#12328

[redacted]

#12328
APPROVED
12-13-78
4-K
T. McNair
3-27-79

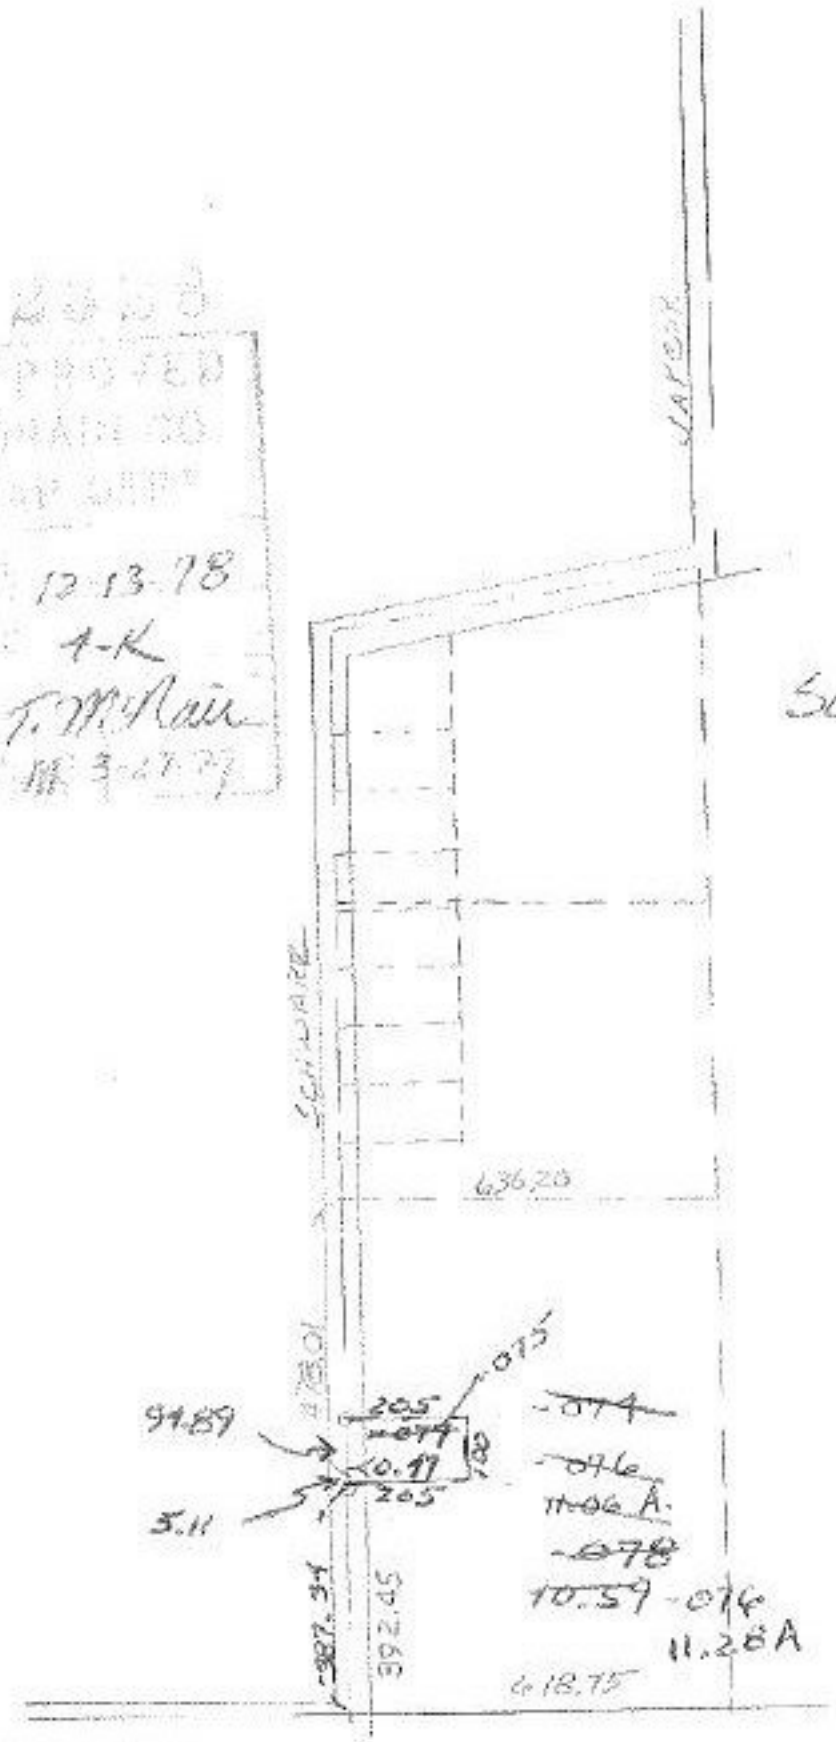

SEE ALSO
12152
11835
12317

RIEGELSBERGER