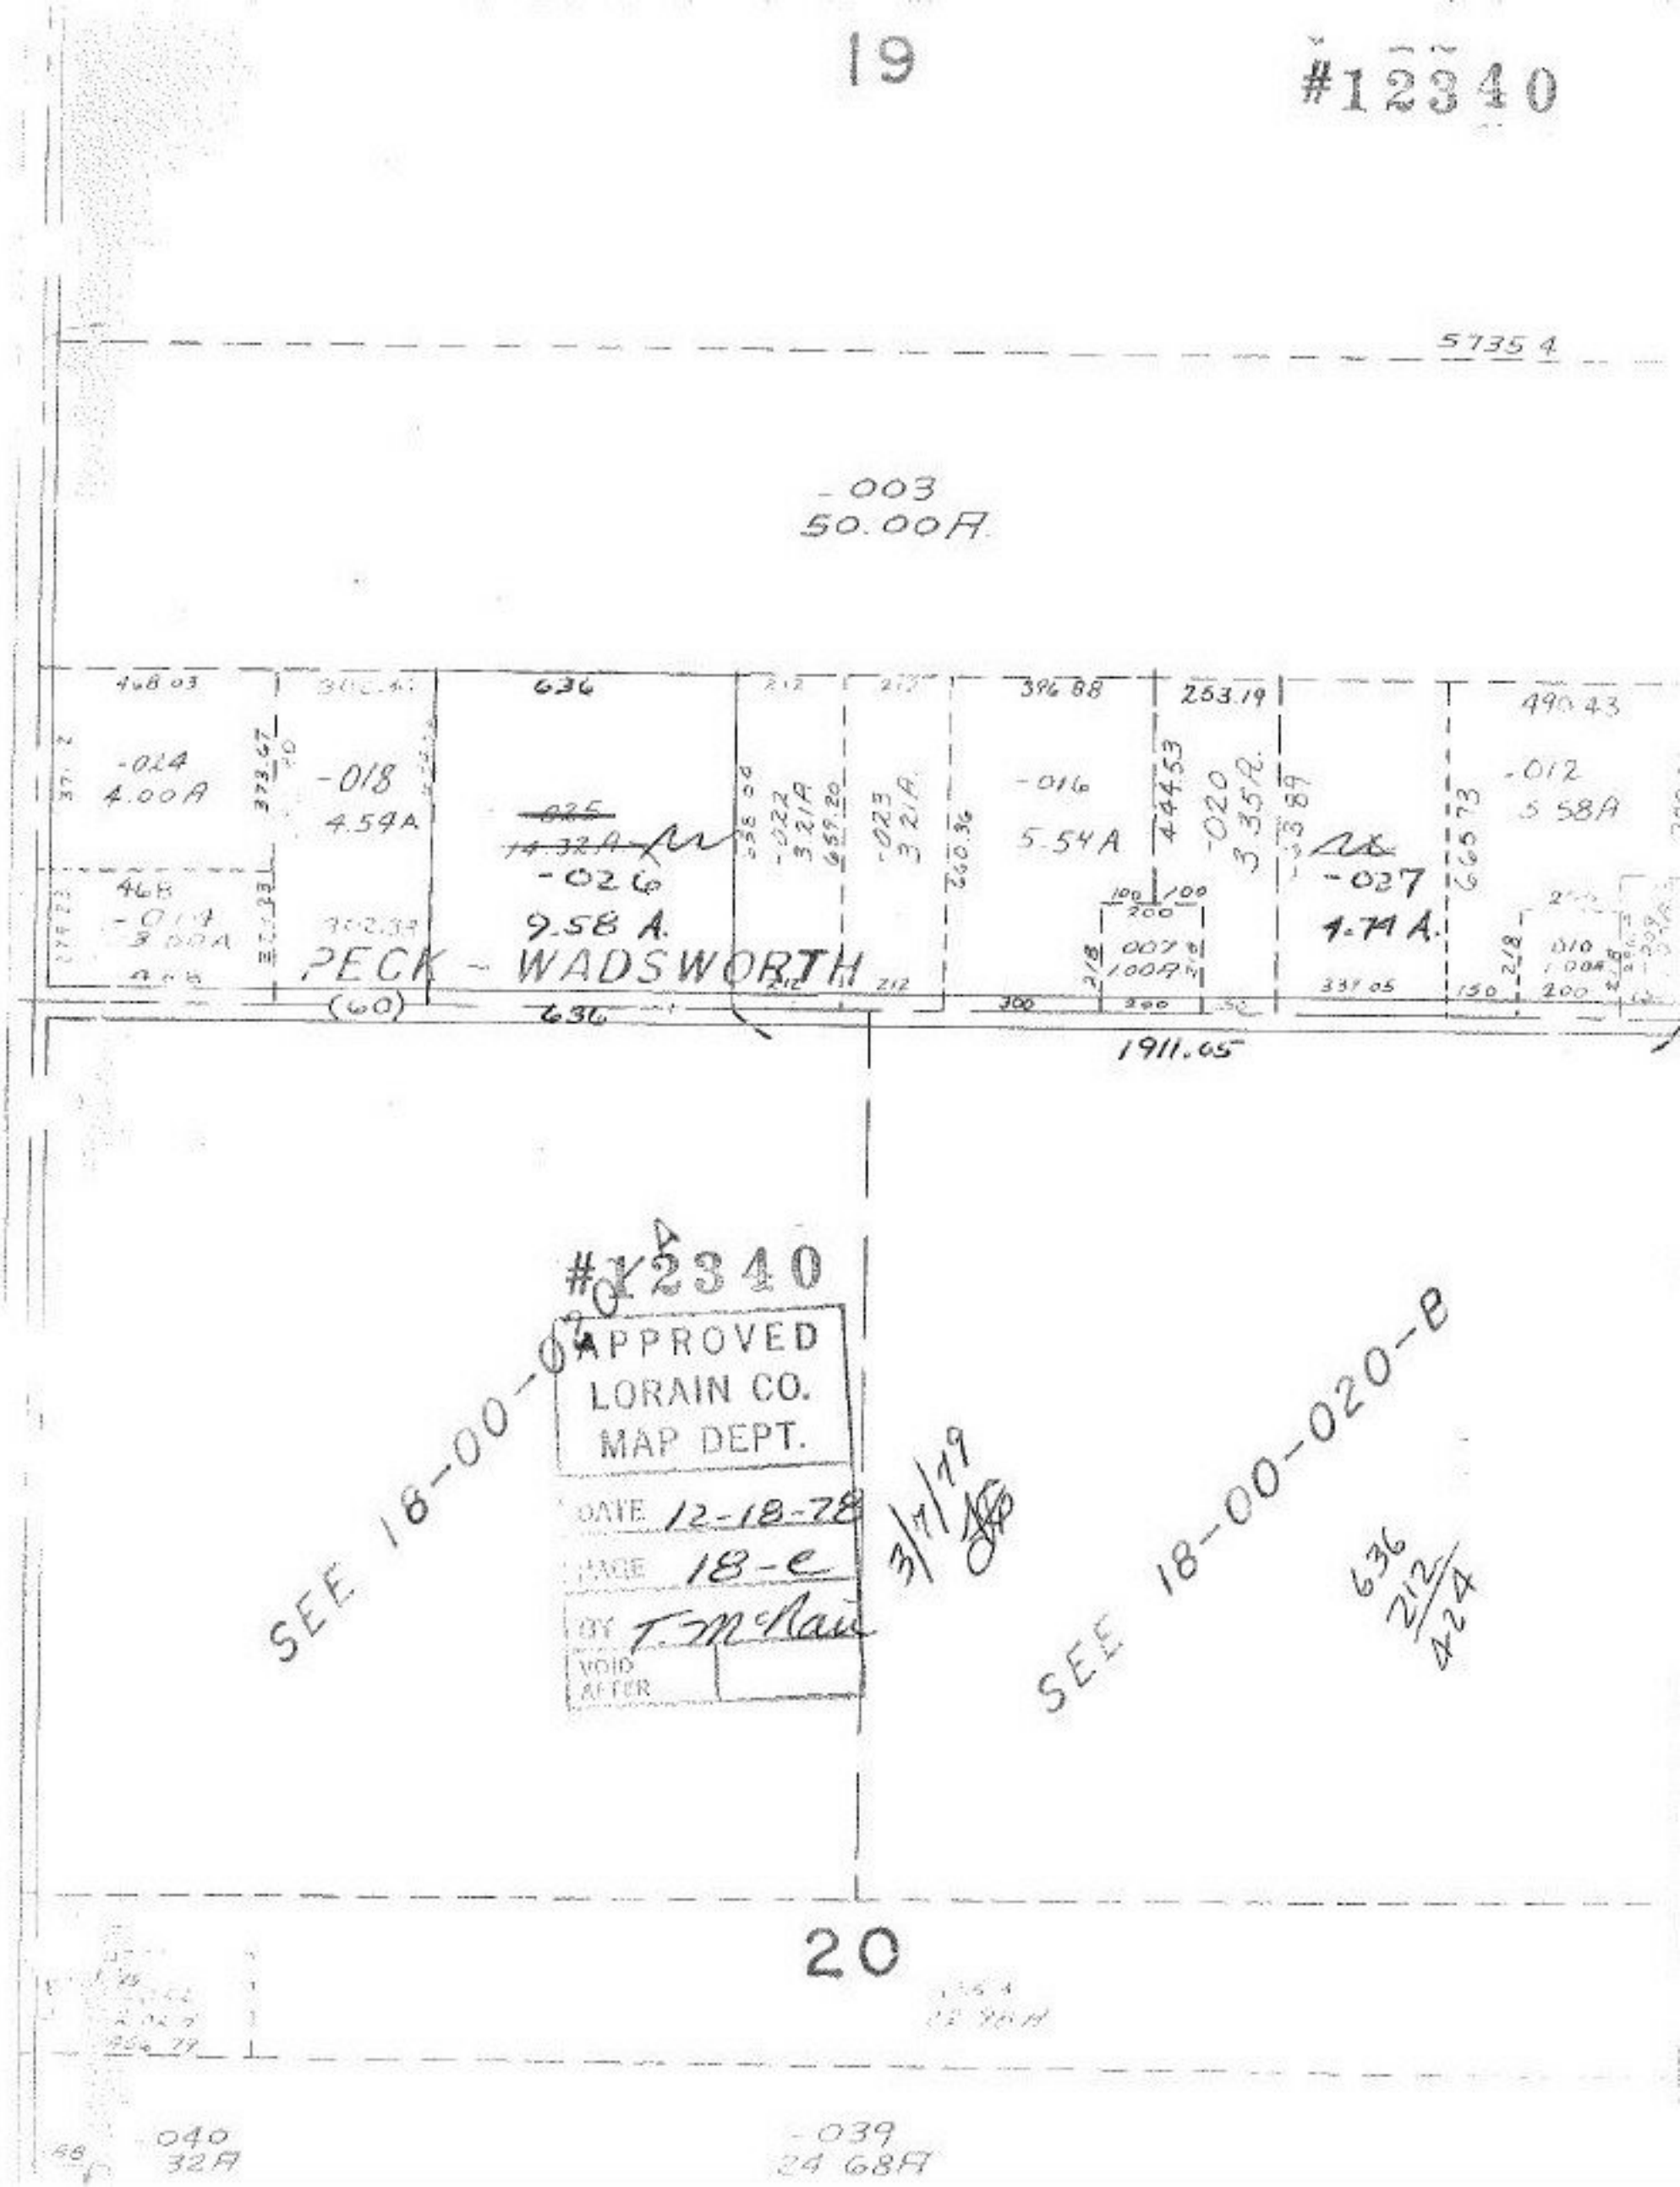
19
#12340
5735.4
-003
50.00A
468.03
-024
4.00A
-018
4.54A
636
-026
9.58 A.
PECK - WADSWORTH
(60)
636
396.88
-016
5.54A
253.19
444.53
-020
3.35A.
-027
4.74 A.
490.43
-012
5.58A
1911.05
#12340
APPROVED
LORAIN CO.
MAP DEPT.
DATE 12-18-78
PAGE 18-e
BY T. McNair
VOID AFTER
3/7/79
SEE 18-00-020-A
SEE 18-00-020-B
636
212
424
20
-040
32A
-039
24.68A