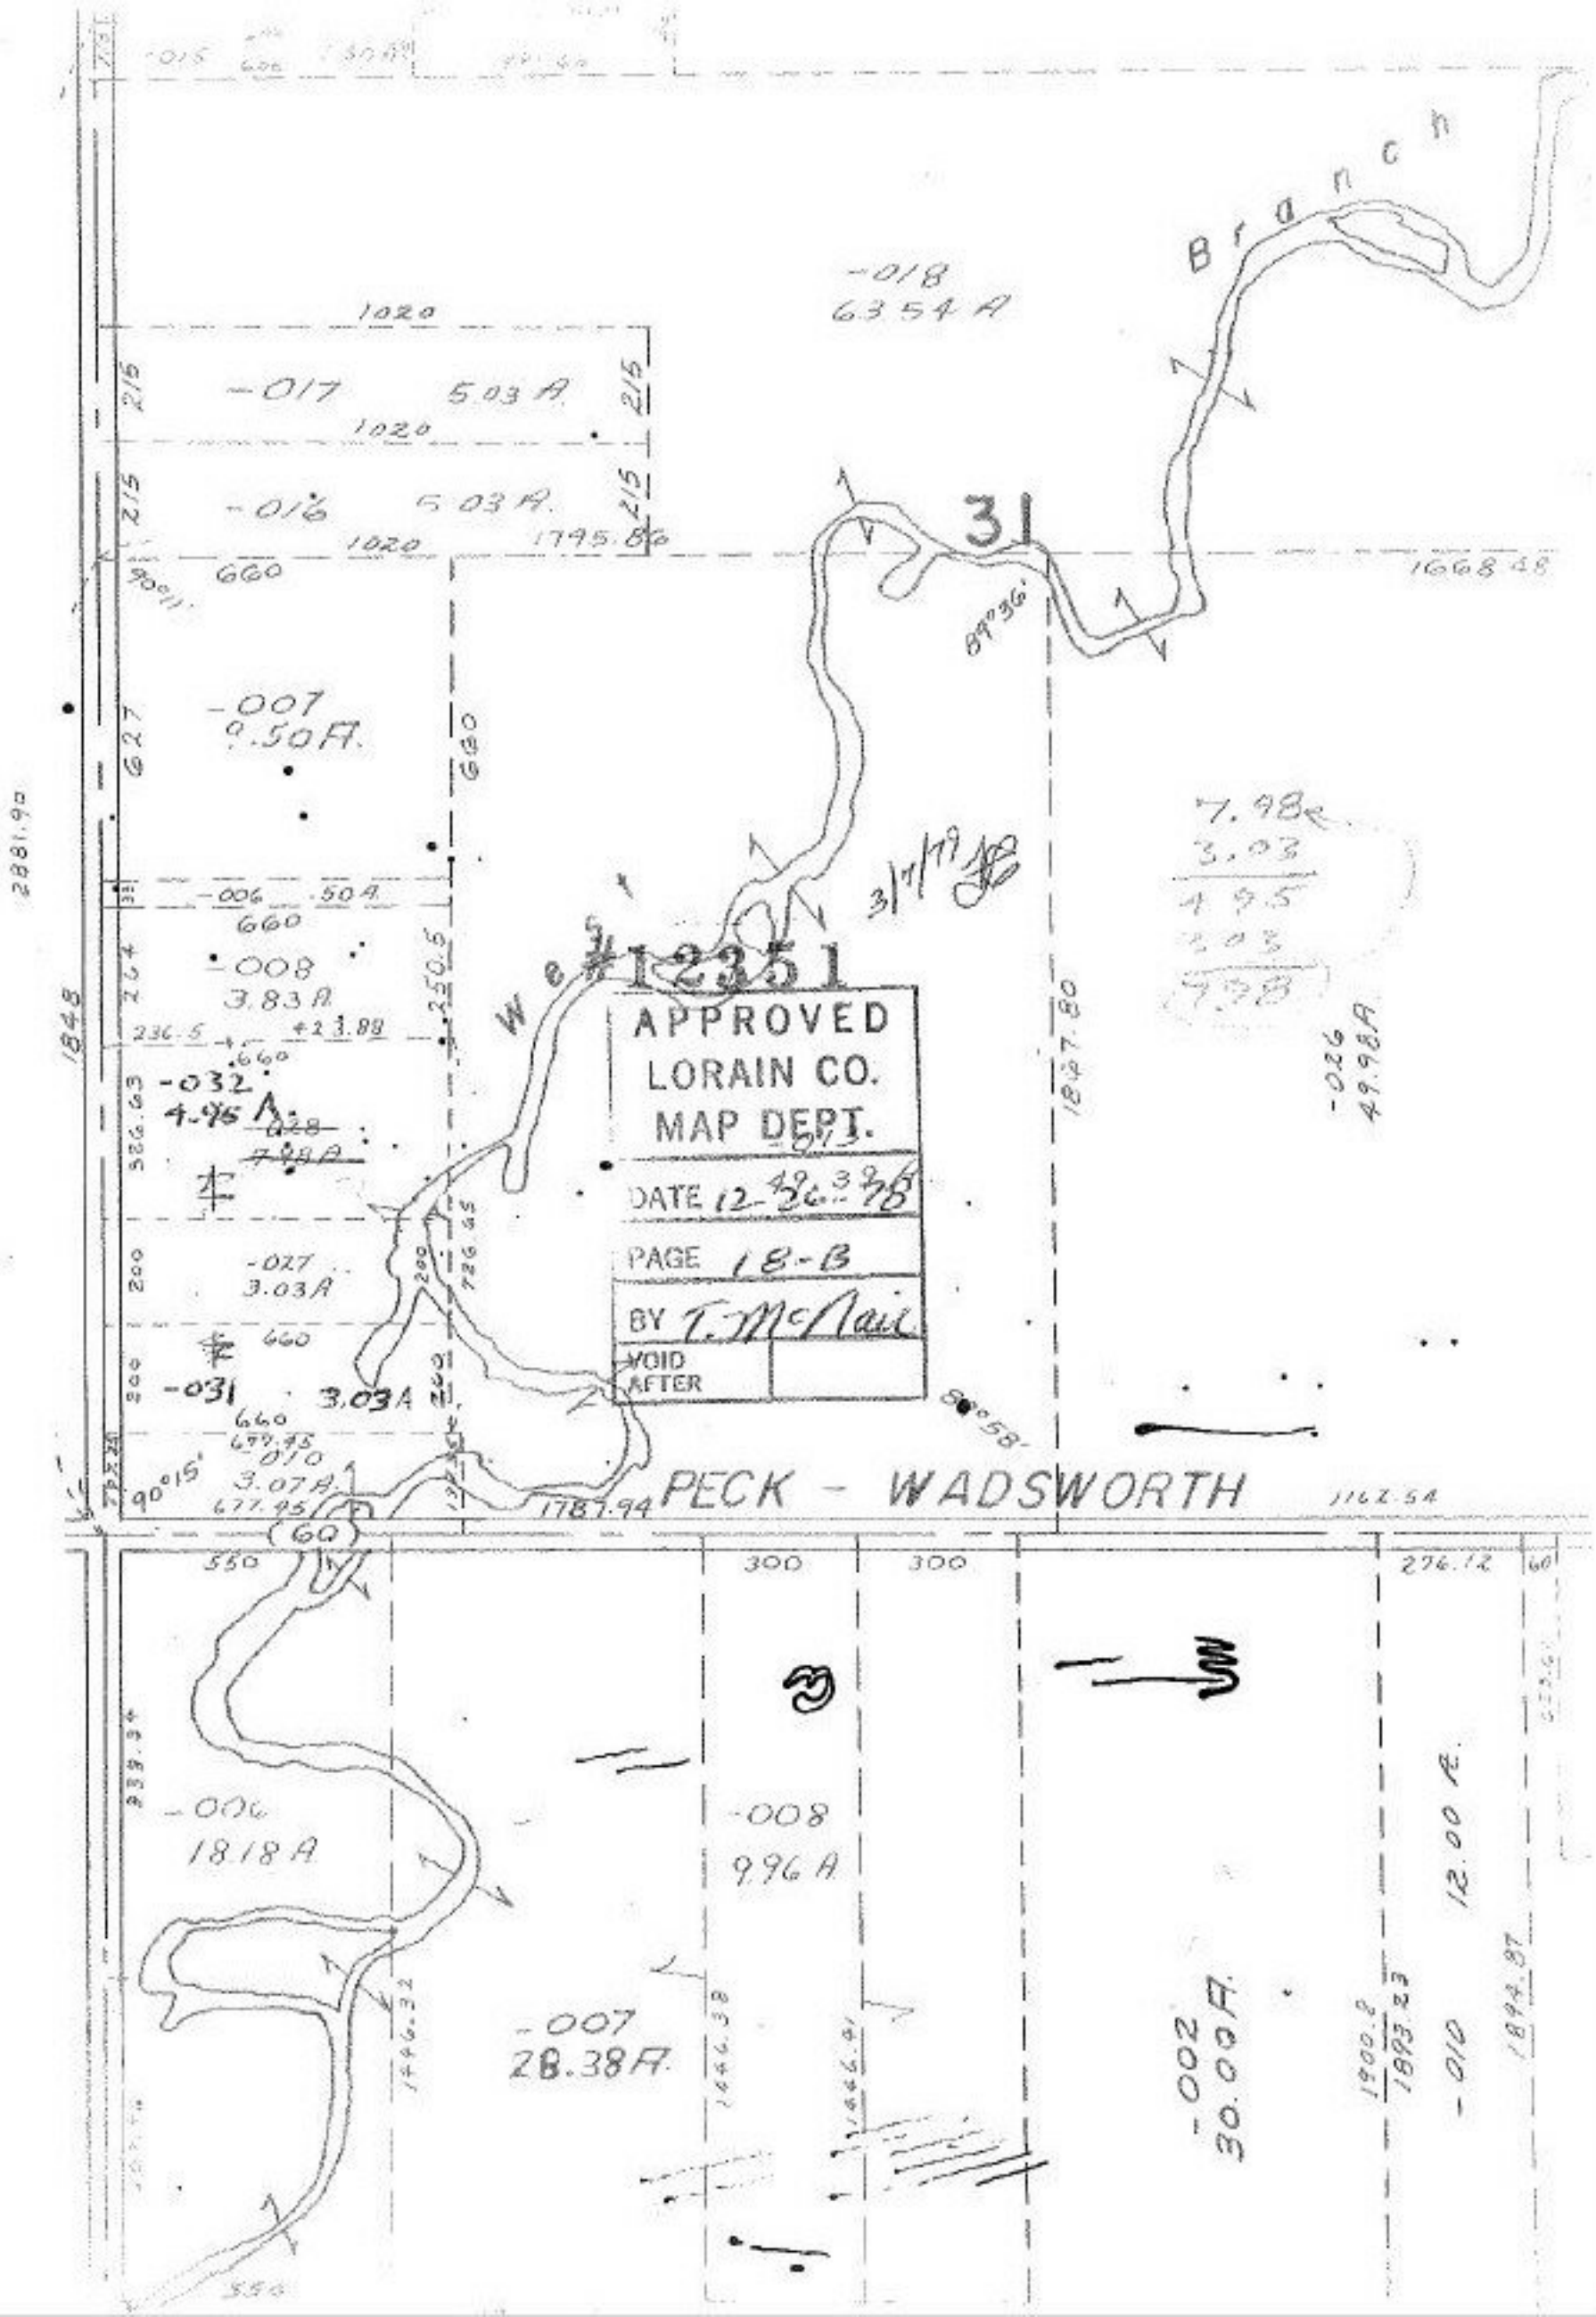

Branch
-018
63.54 A
1020
-017 5.03 A
-016 5.03 A
1795.86
31
1668.48
-007
9.50 A
-006 .50 A
-008
3.83 A
-032
4.95 A
-027
3.03 A
-031 3.03 A
-010
3.07 A
PECK - WADSWORTH
1787.94
1162.54
-006
18.18 A
-008
9.96 A
-007
28.38 A
-002
30.00 A
-010 12.00 A
1894.87
1900.8
1893.23
1446.32
1446.38
1446.41
1848
2881.90
1867.80
-026
49.98 A
7.98
3.03
4.95
3.03
7.98
3/7/79
West
#12351
APPROVED
LORAIN CO.
MAP DEPT.
DATE 12-26-78
PAGE 18-B
BY T. McNair
VOID AFTER