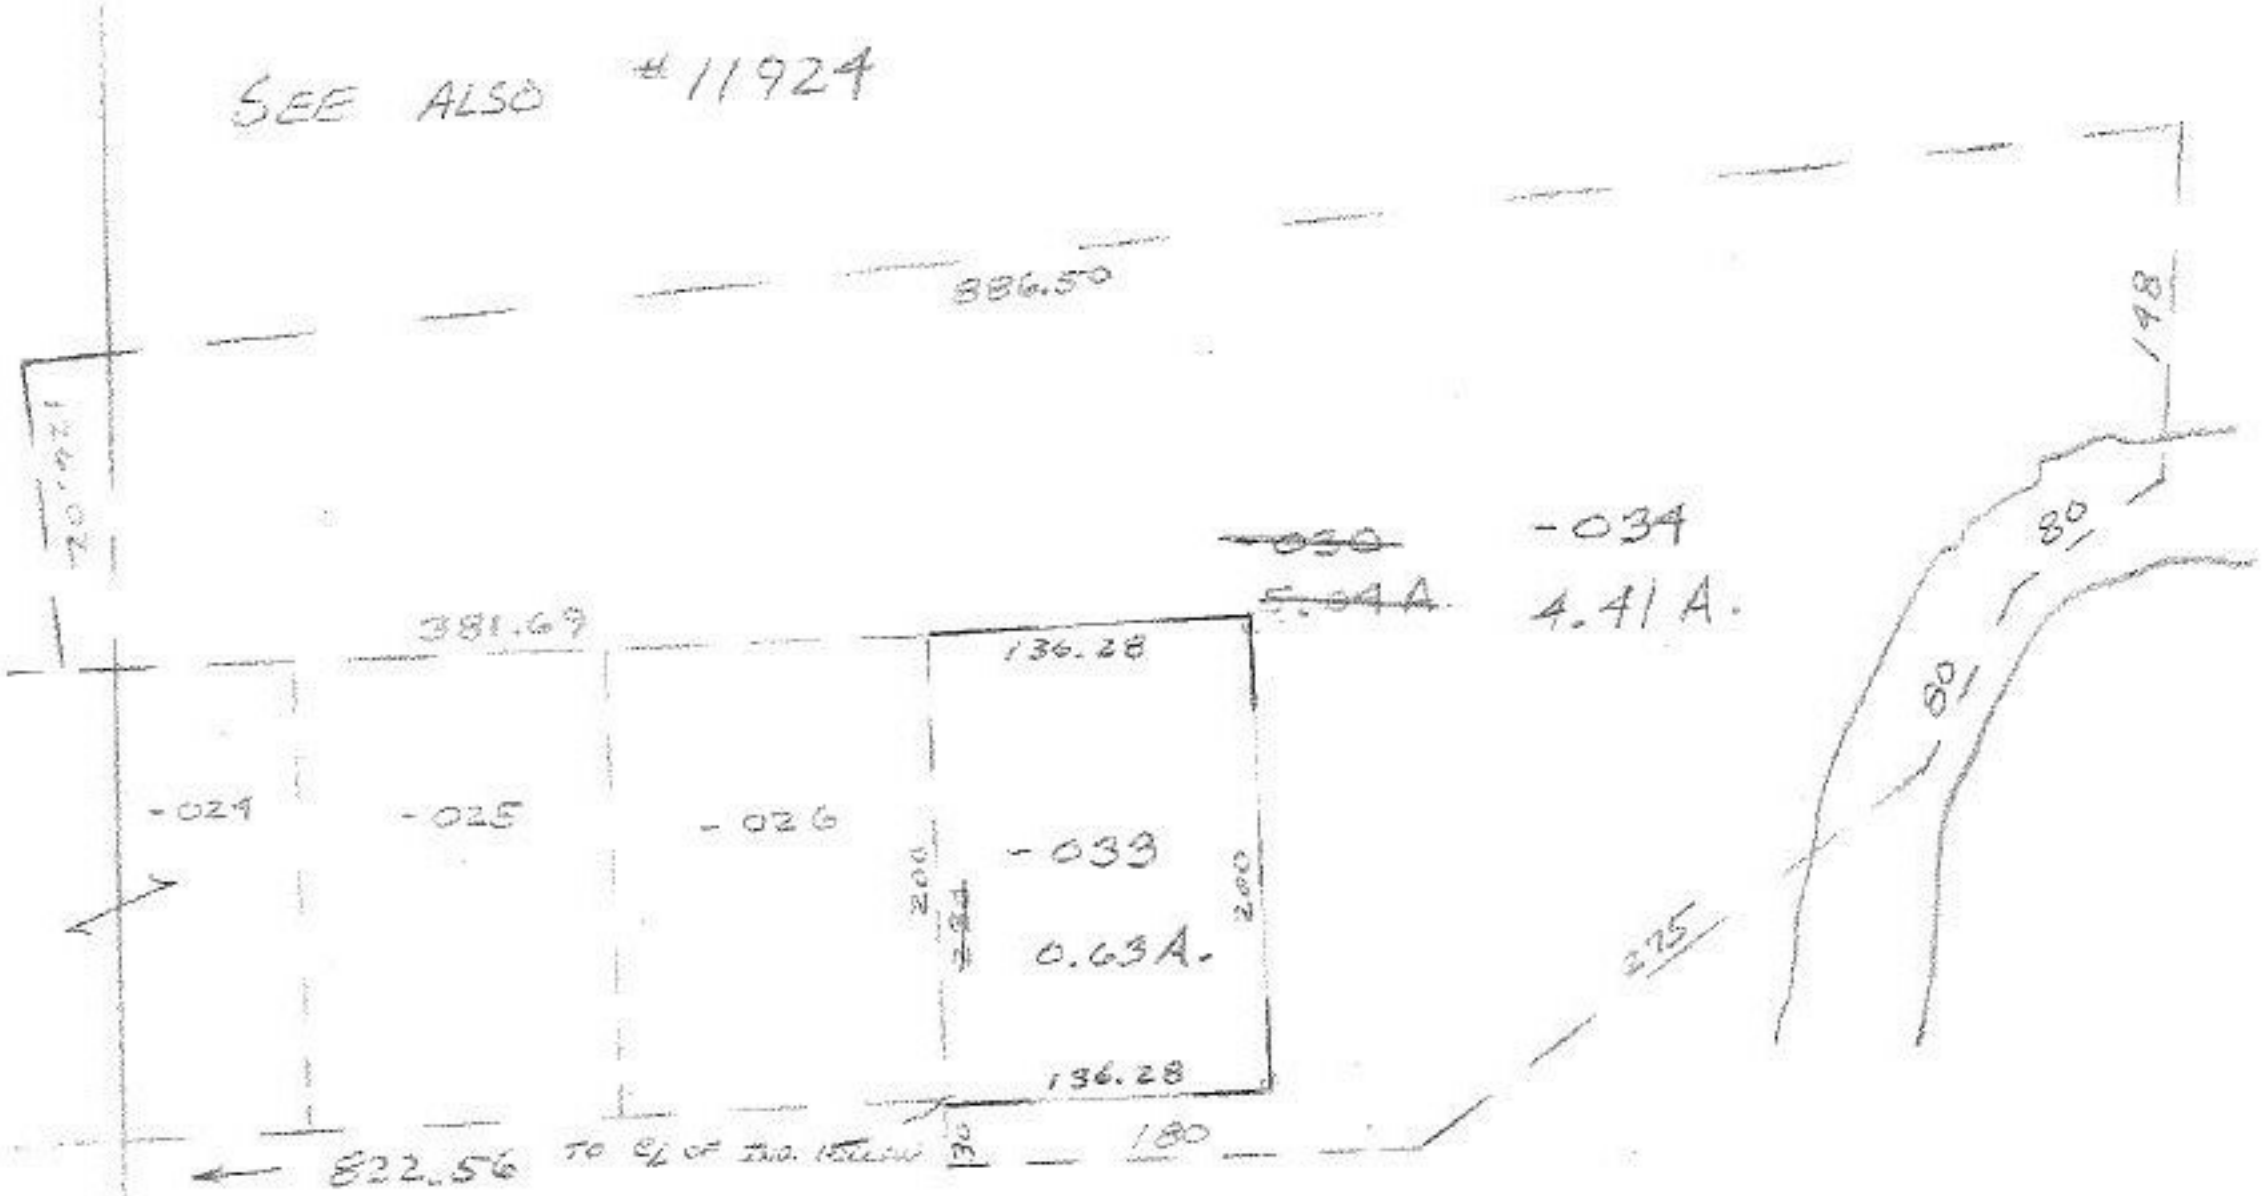

5.04
0.63
4.41
.63
5.04

#12359

APPROVED
LEHIGH CO.
MAP DEPT.
DATE 12-29-78
10-00-015-A
BY T. McNair