12376
#12376

19.64
13.89
5.75
13.89
19.64

SEE SPLIT 11888
O.L. 53 NEEDS REDRAWING

#12376
APPROVED
LORAIN CO.
MAP DEPT.
DATE 1-9-79
PAGE 9-E
BY T. McNair
VOID AFTER NR 4-23-79
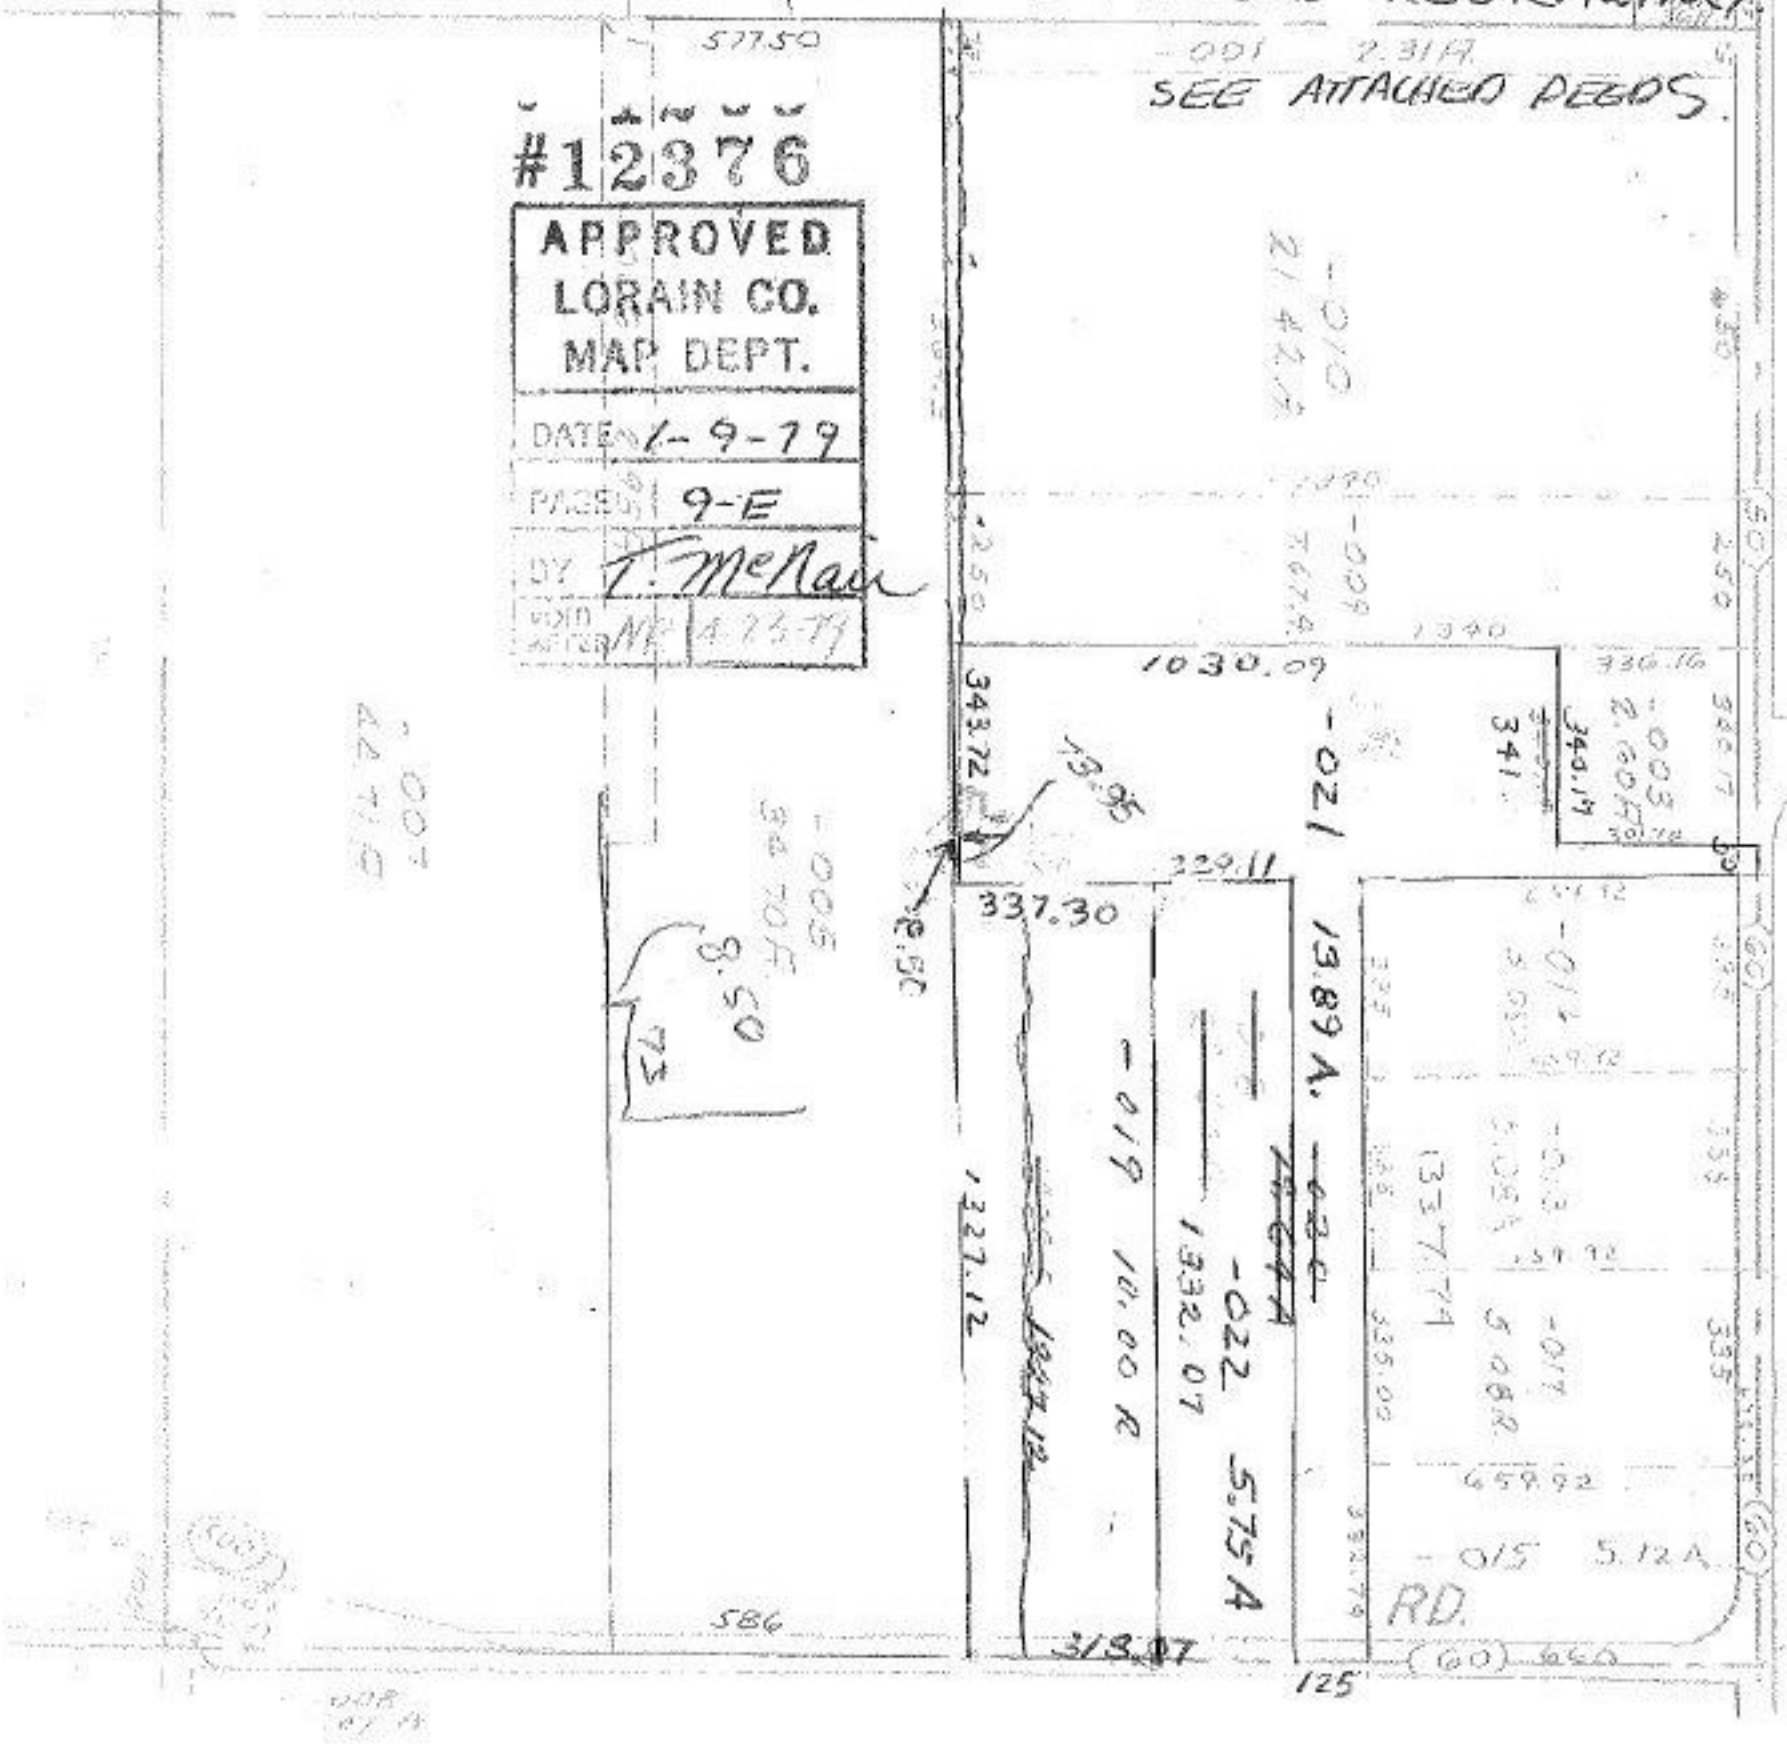
SEE ATTACHED DEEDS.