#12387

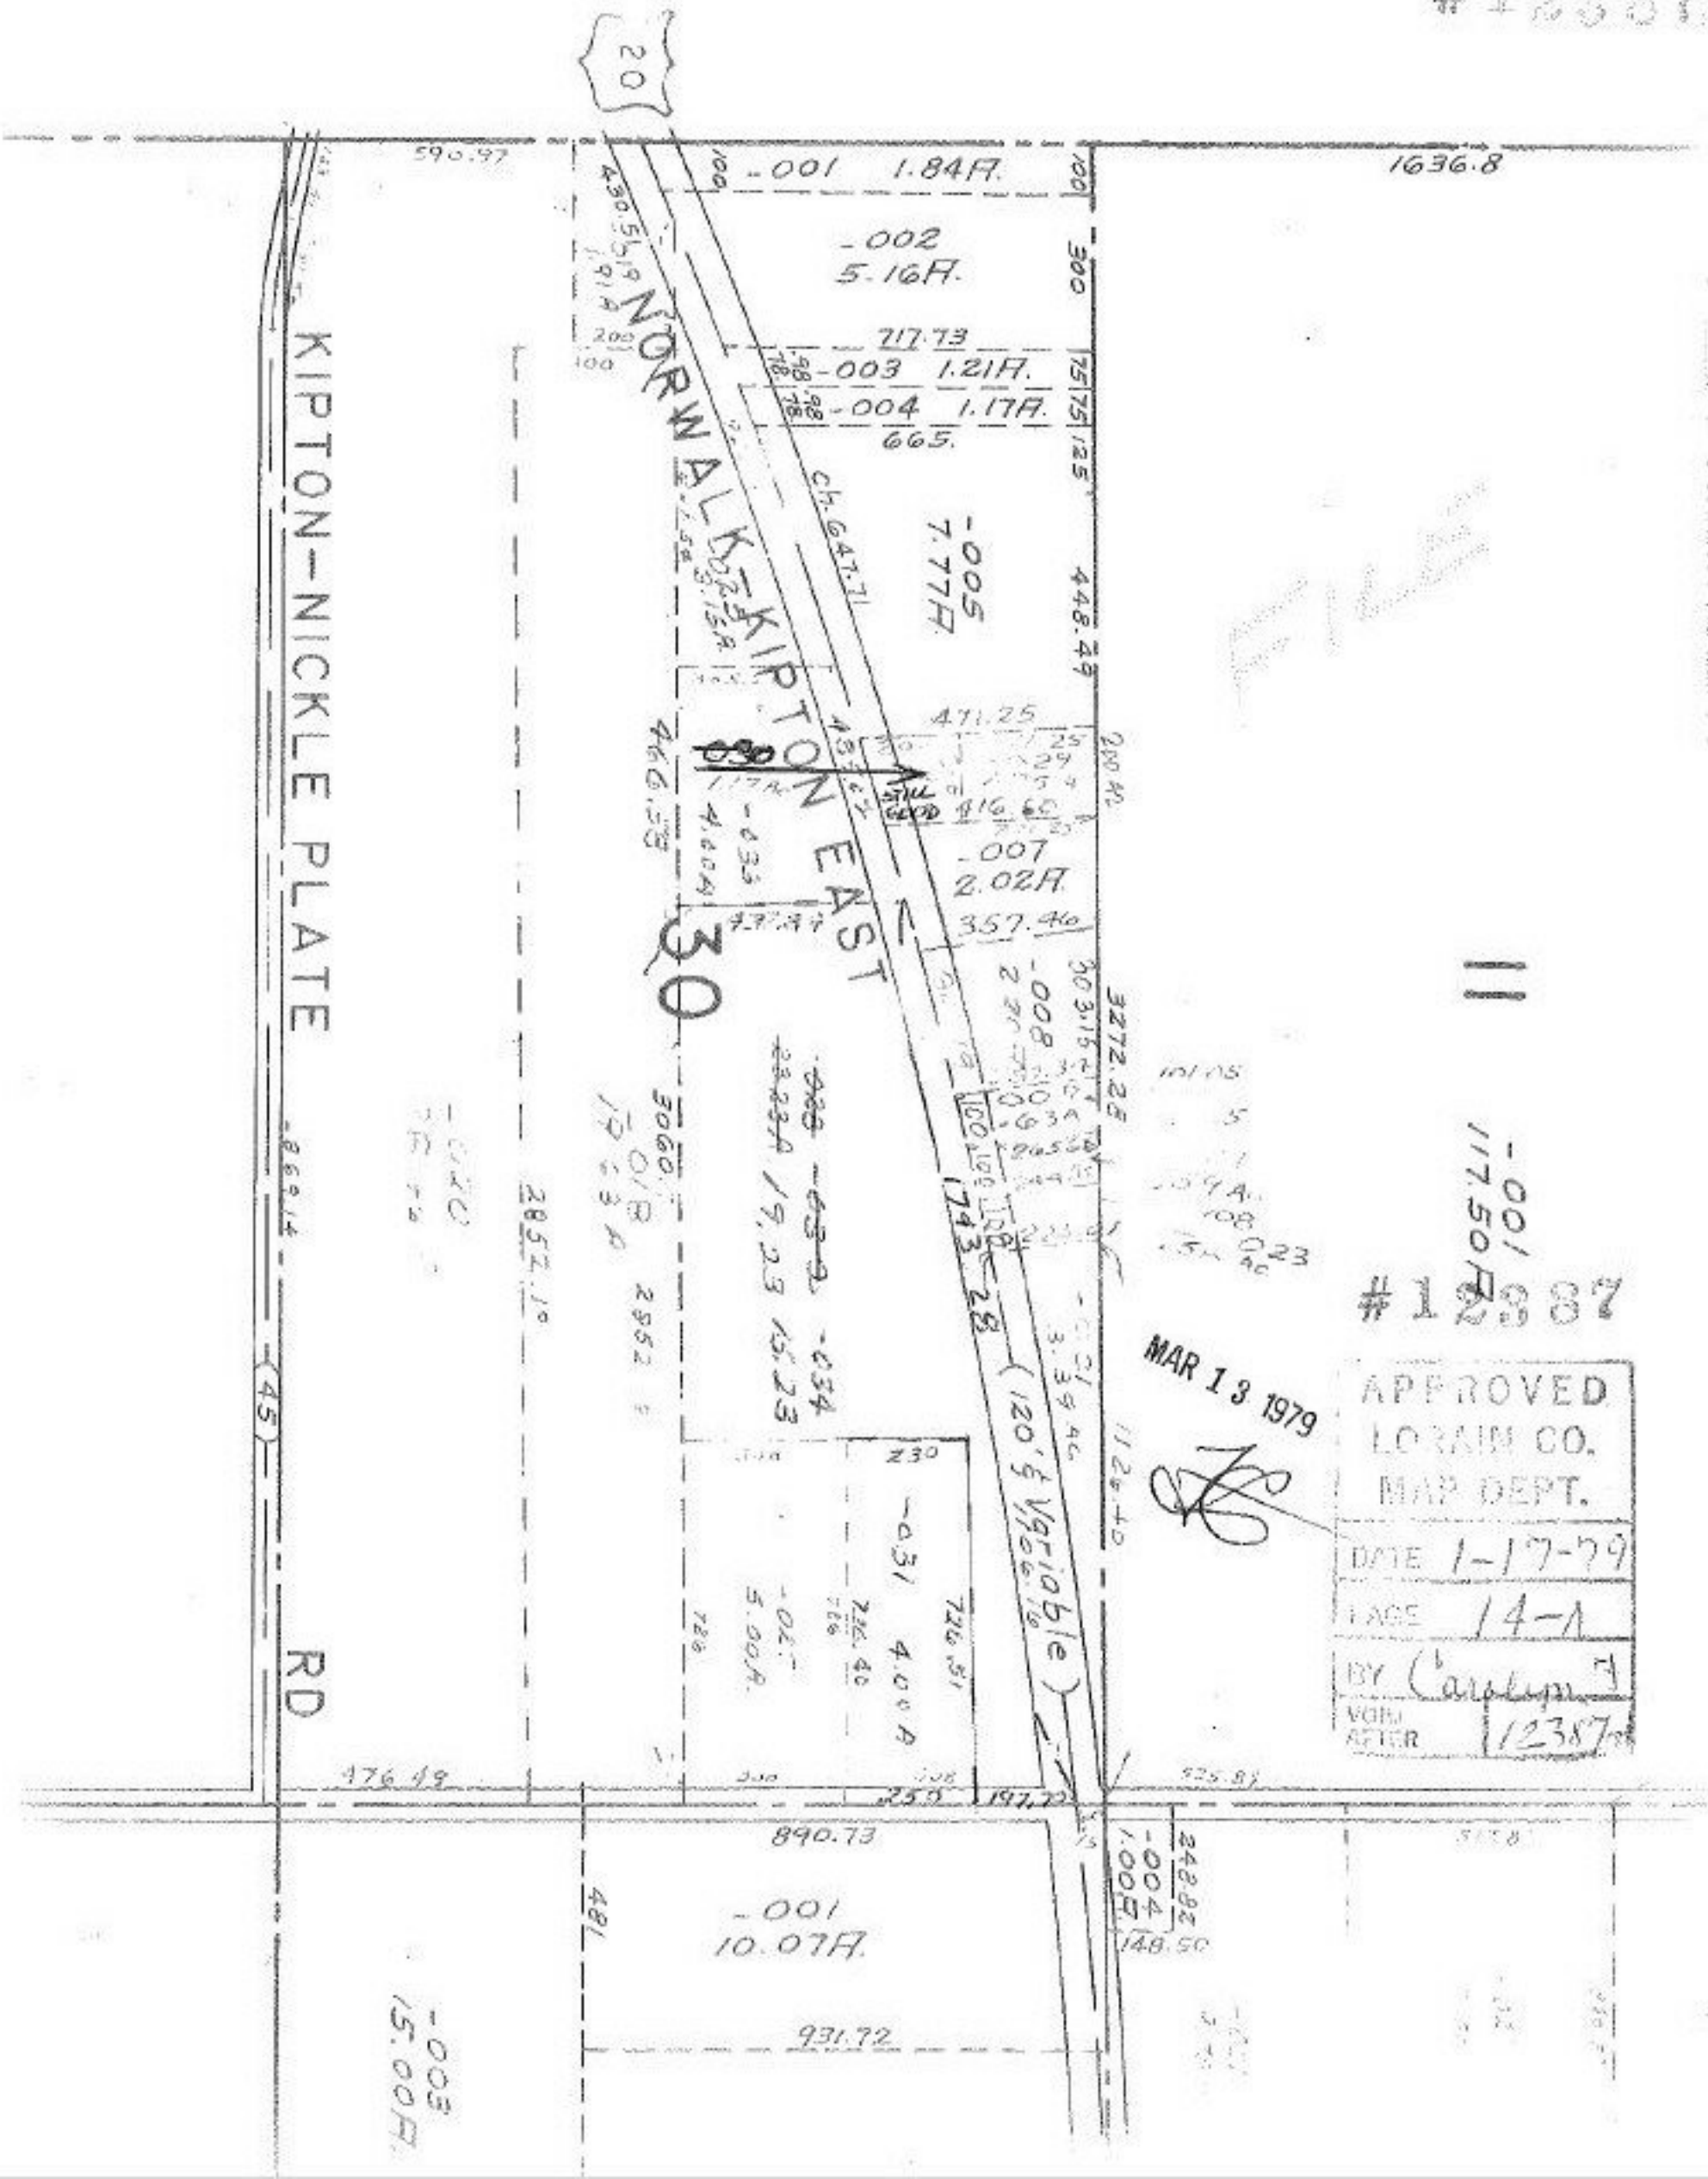

20
590.97
1636.8
-001 1.84A.
-002 5.16A.
717.73
-003 1.21A.
-004 1.17A.
665.
-005 7.77A.
448.49
471.25
416.60
-007 2.02A.
357.46
NORWALK-KIPTON EAST
KIPTON-NICKLE PLATE
RD
30
-001 117.50A.
#12387
MAR 13 1979
APPROVED
LORAIN CO.
MAP DEPT.
DATE 1-17-79
PAGE 14-A
BY Carolyn
VOID AFTER 12387
-031 4.00A
-027 5.00A.
-034 19.23 15.23
-008
-003 15.00A.
-001 10.07A.
890.73
931.72
476.49
525.87
-004 1.00A.
148.50