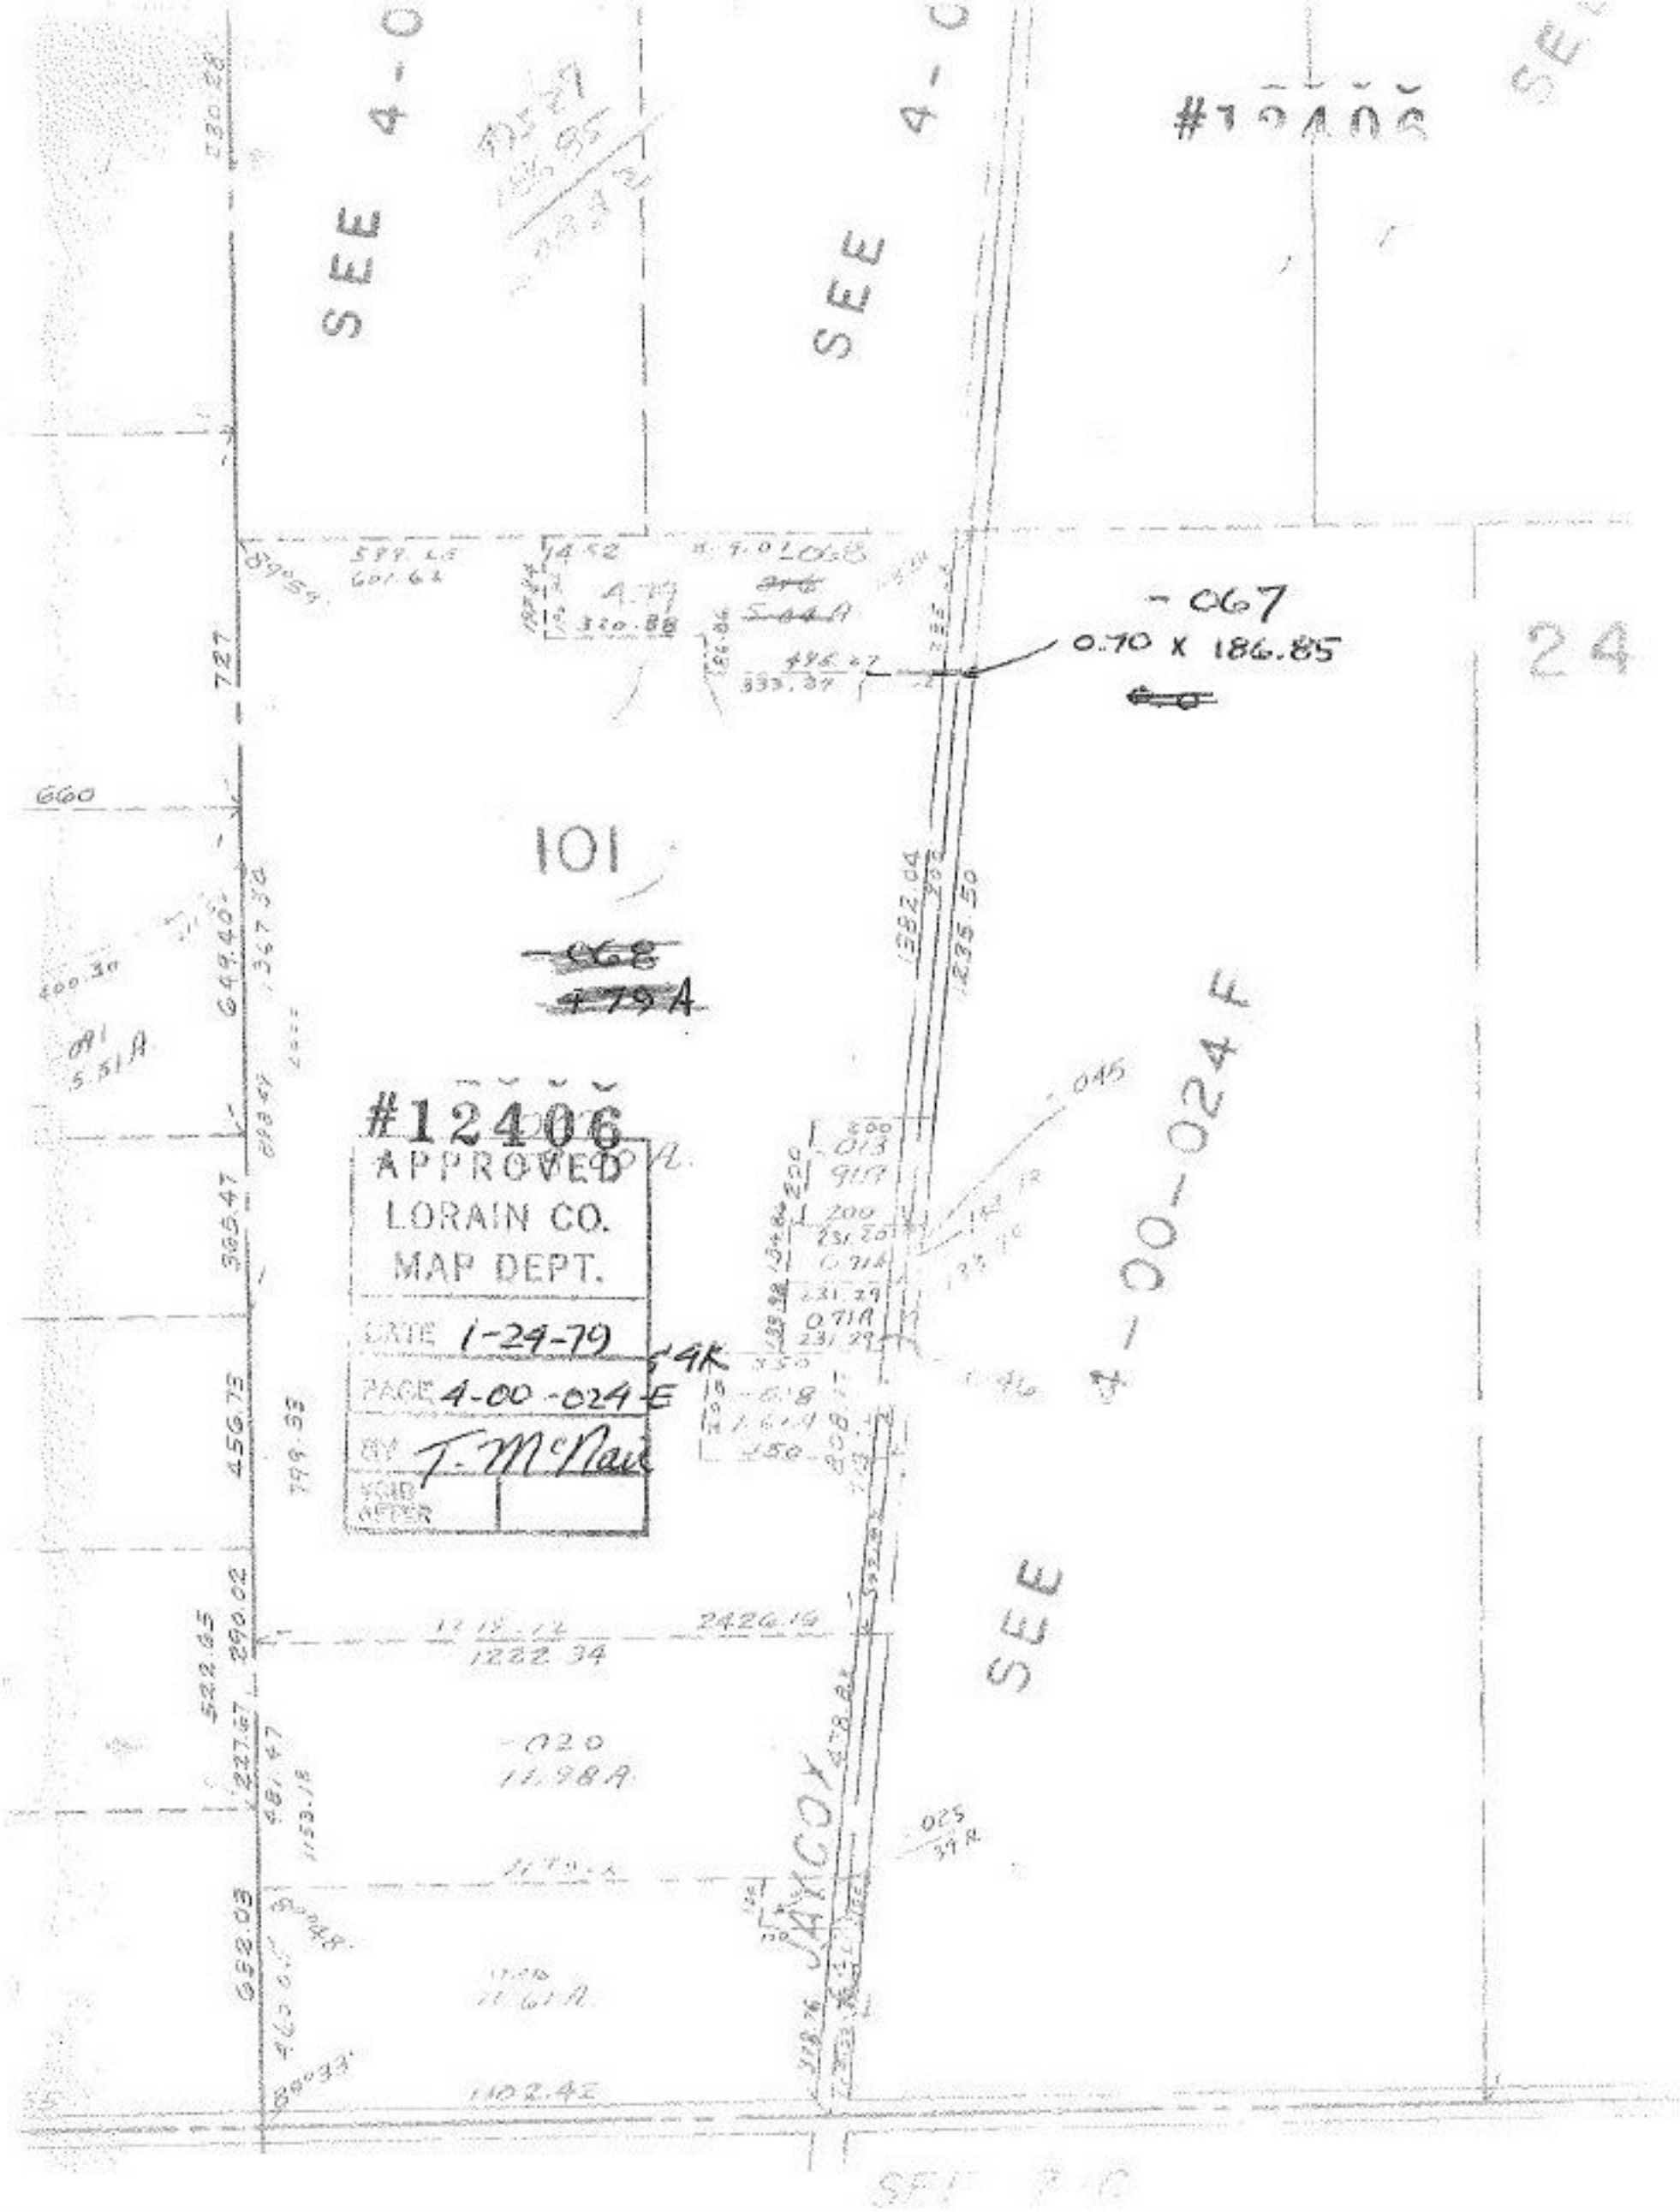

SEE 4-0
SEE 4-0
#12406
24
-067
0.70 X 186.85
101
~~068~~
~~479A~~
#12406
APPROVED
LORAIN CO.
MAP DEPT.
DATE 1-24-79
PAGE 4-00-024-E
BY T. McNair
VOID AFTER
4-00-024 E
SEE
JAYCOX
-020
11.98A