#12410

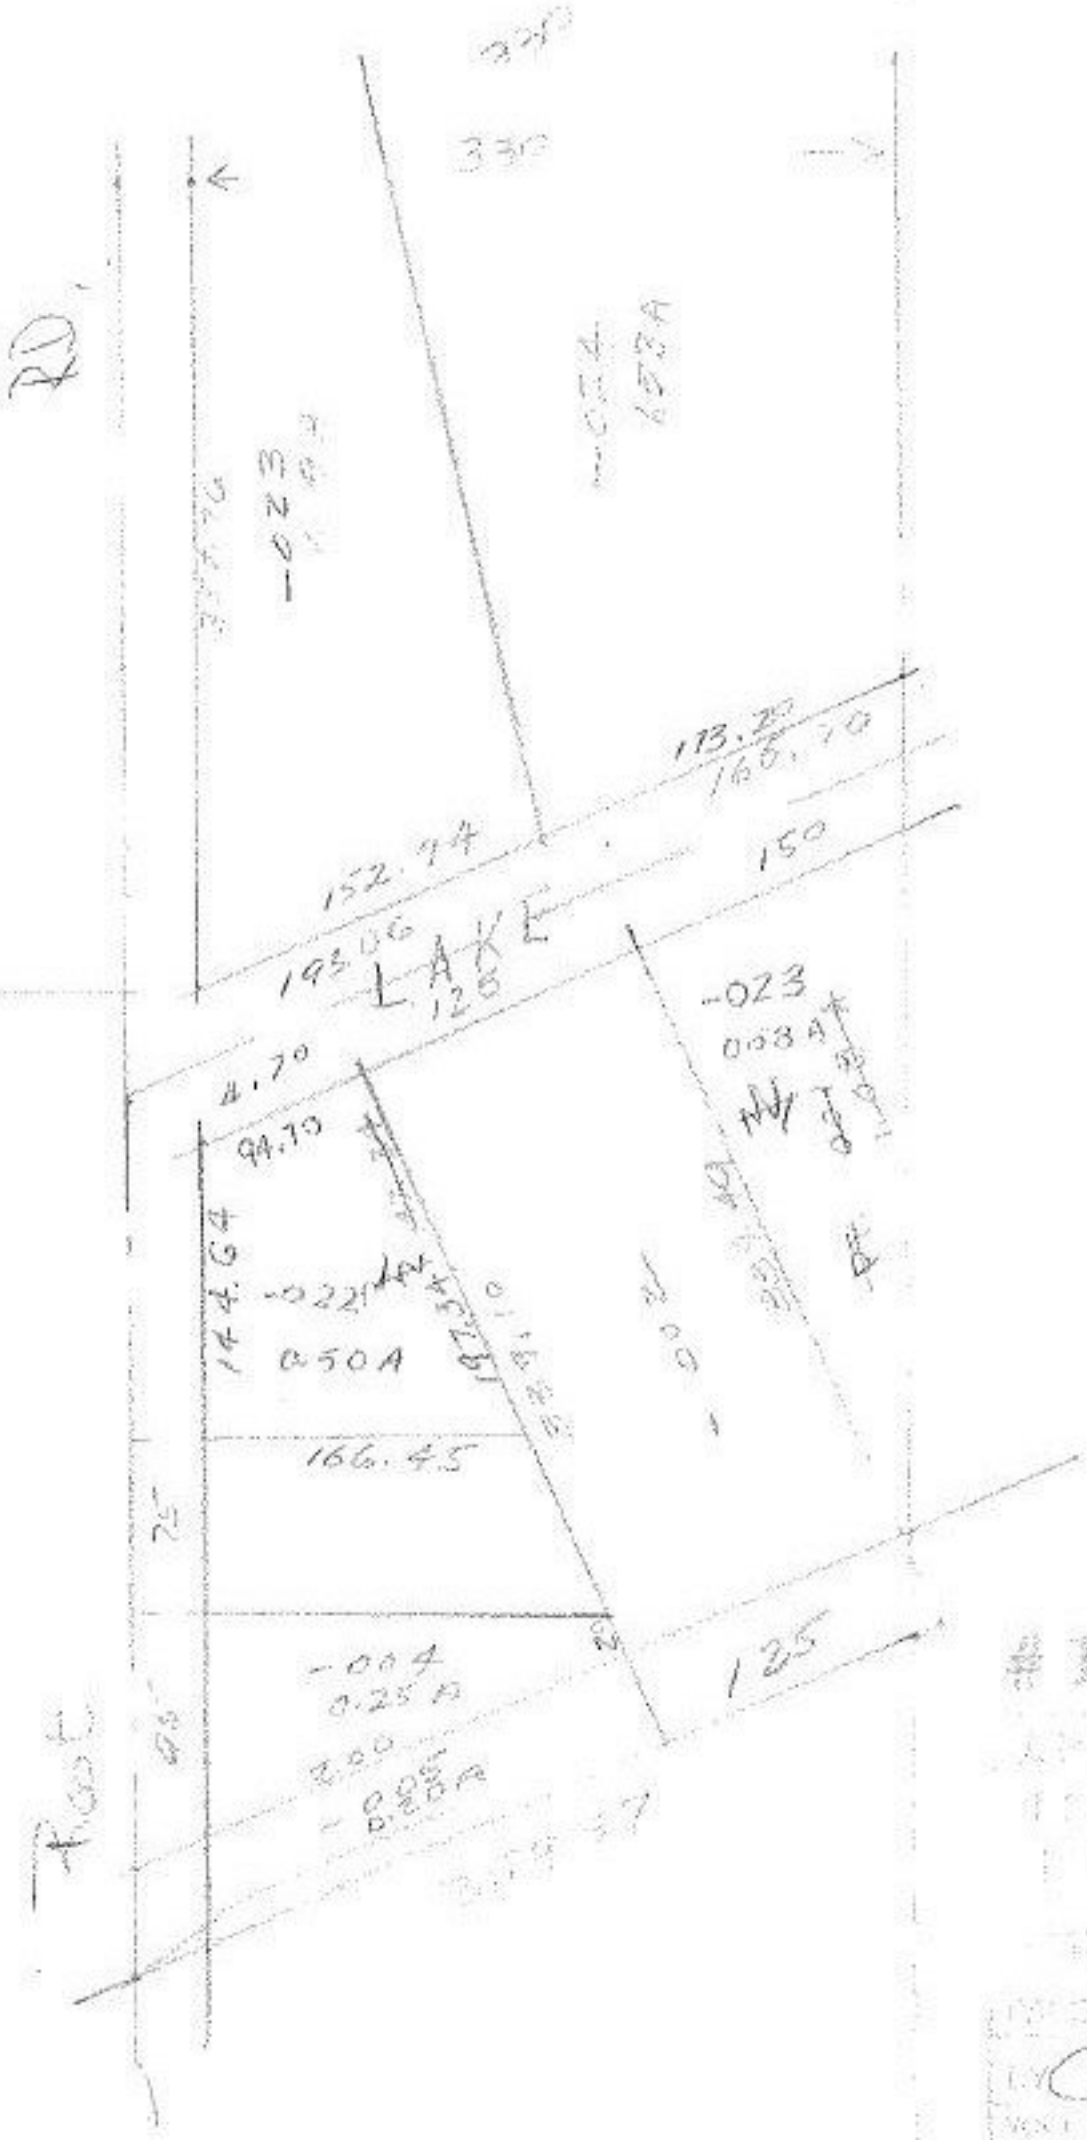

#12410

1-25-79
3-00-045
Carolyn F
12410