#12419

#12419
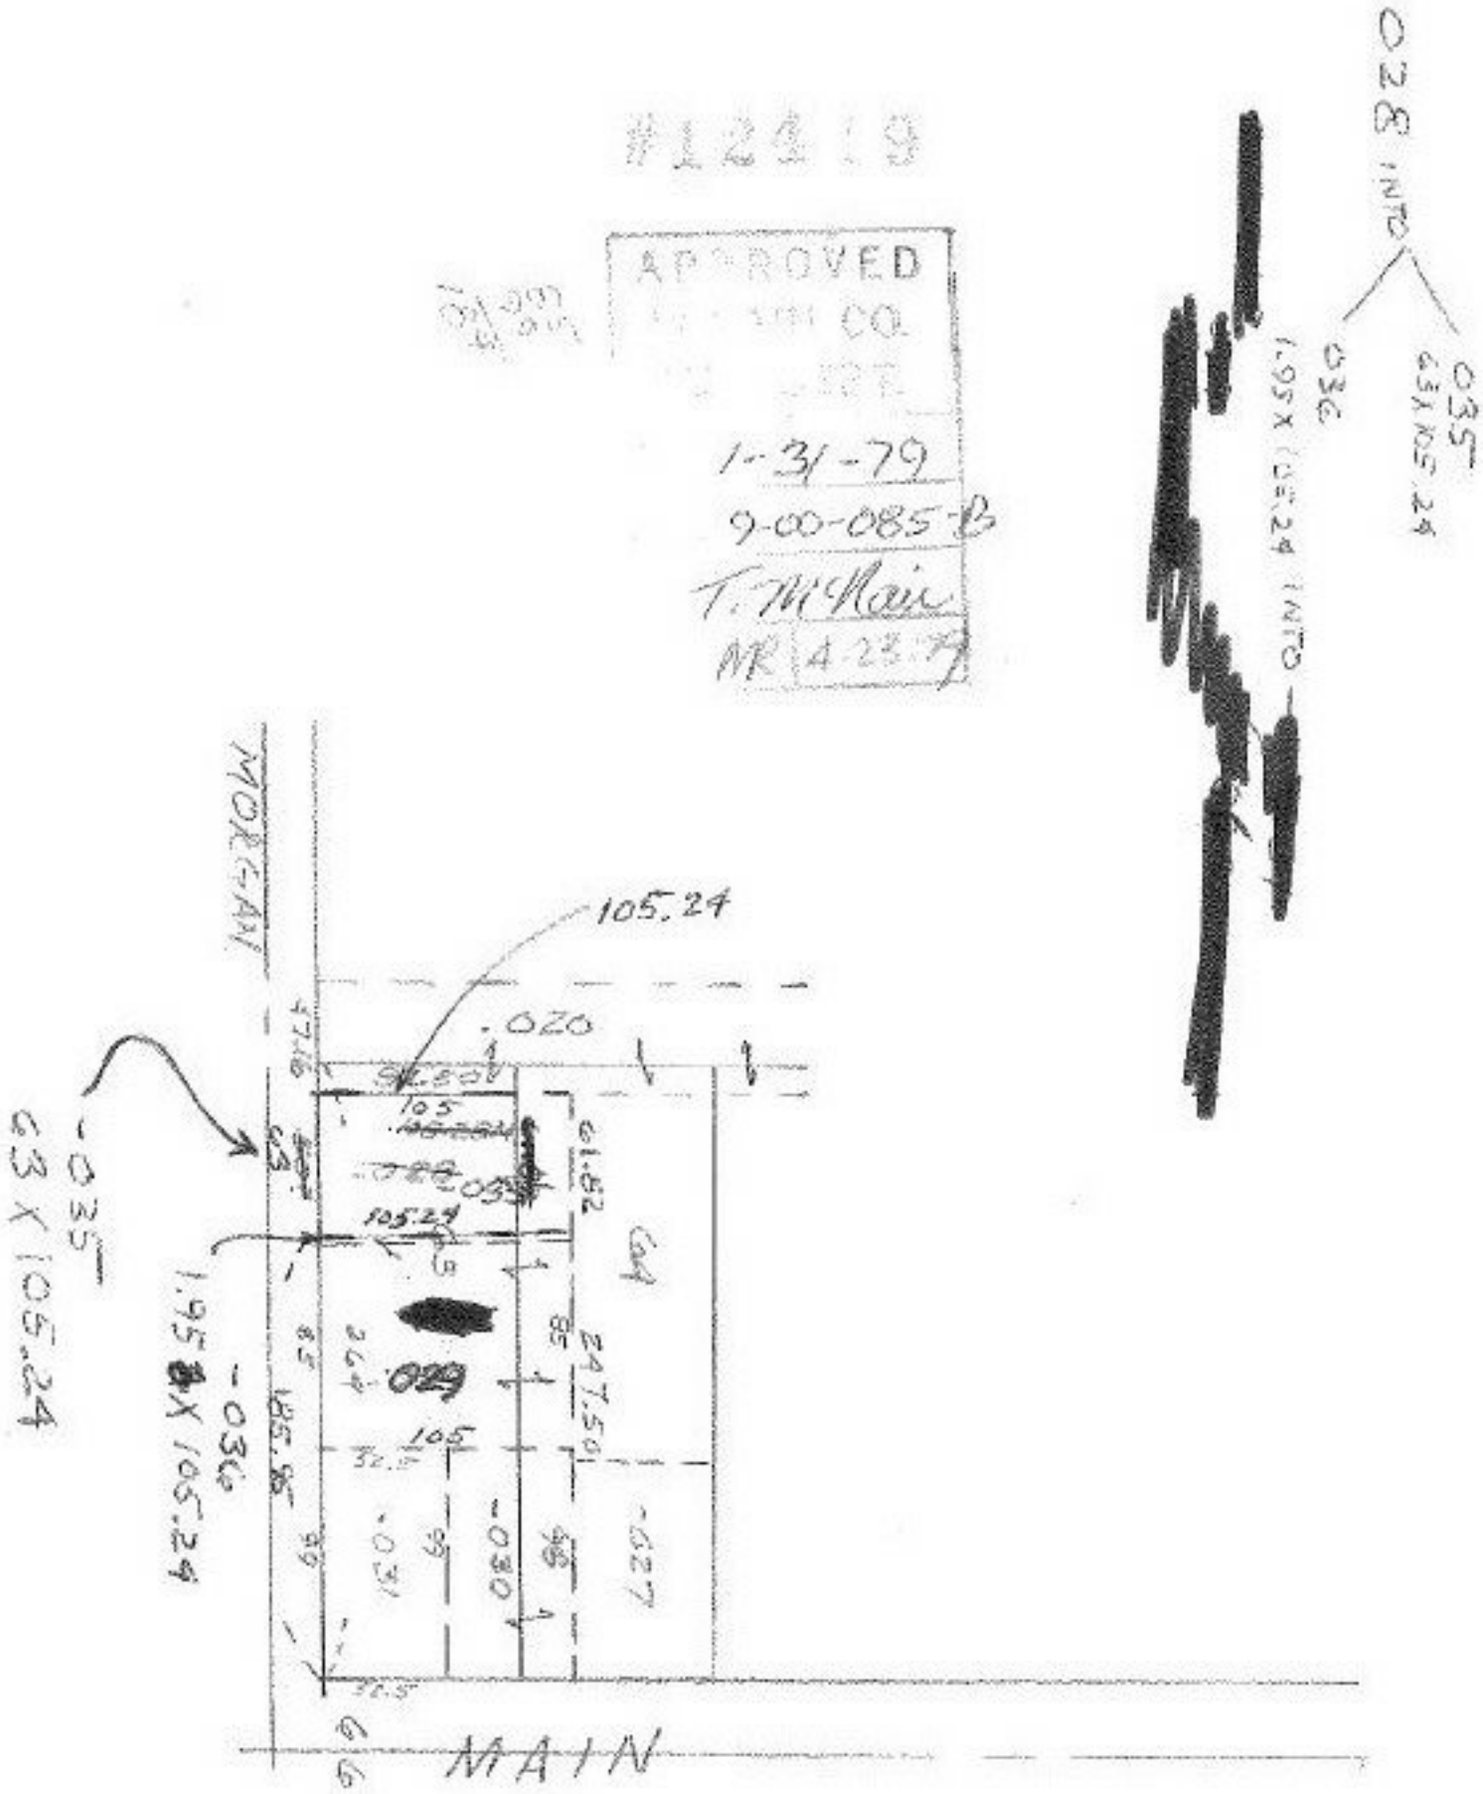
APPROVED
[illegible] CO.
[illegible]
1-31-79
9-00-085-B
T. McNair
MR 4-23-79