12424

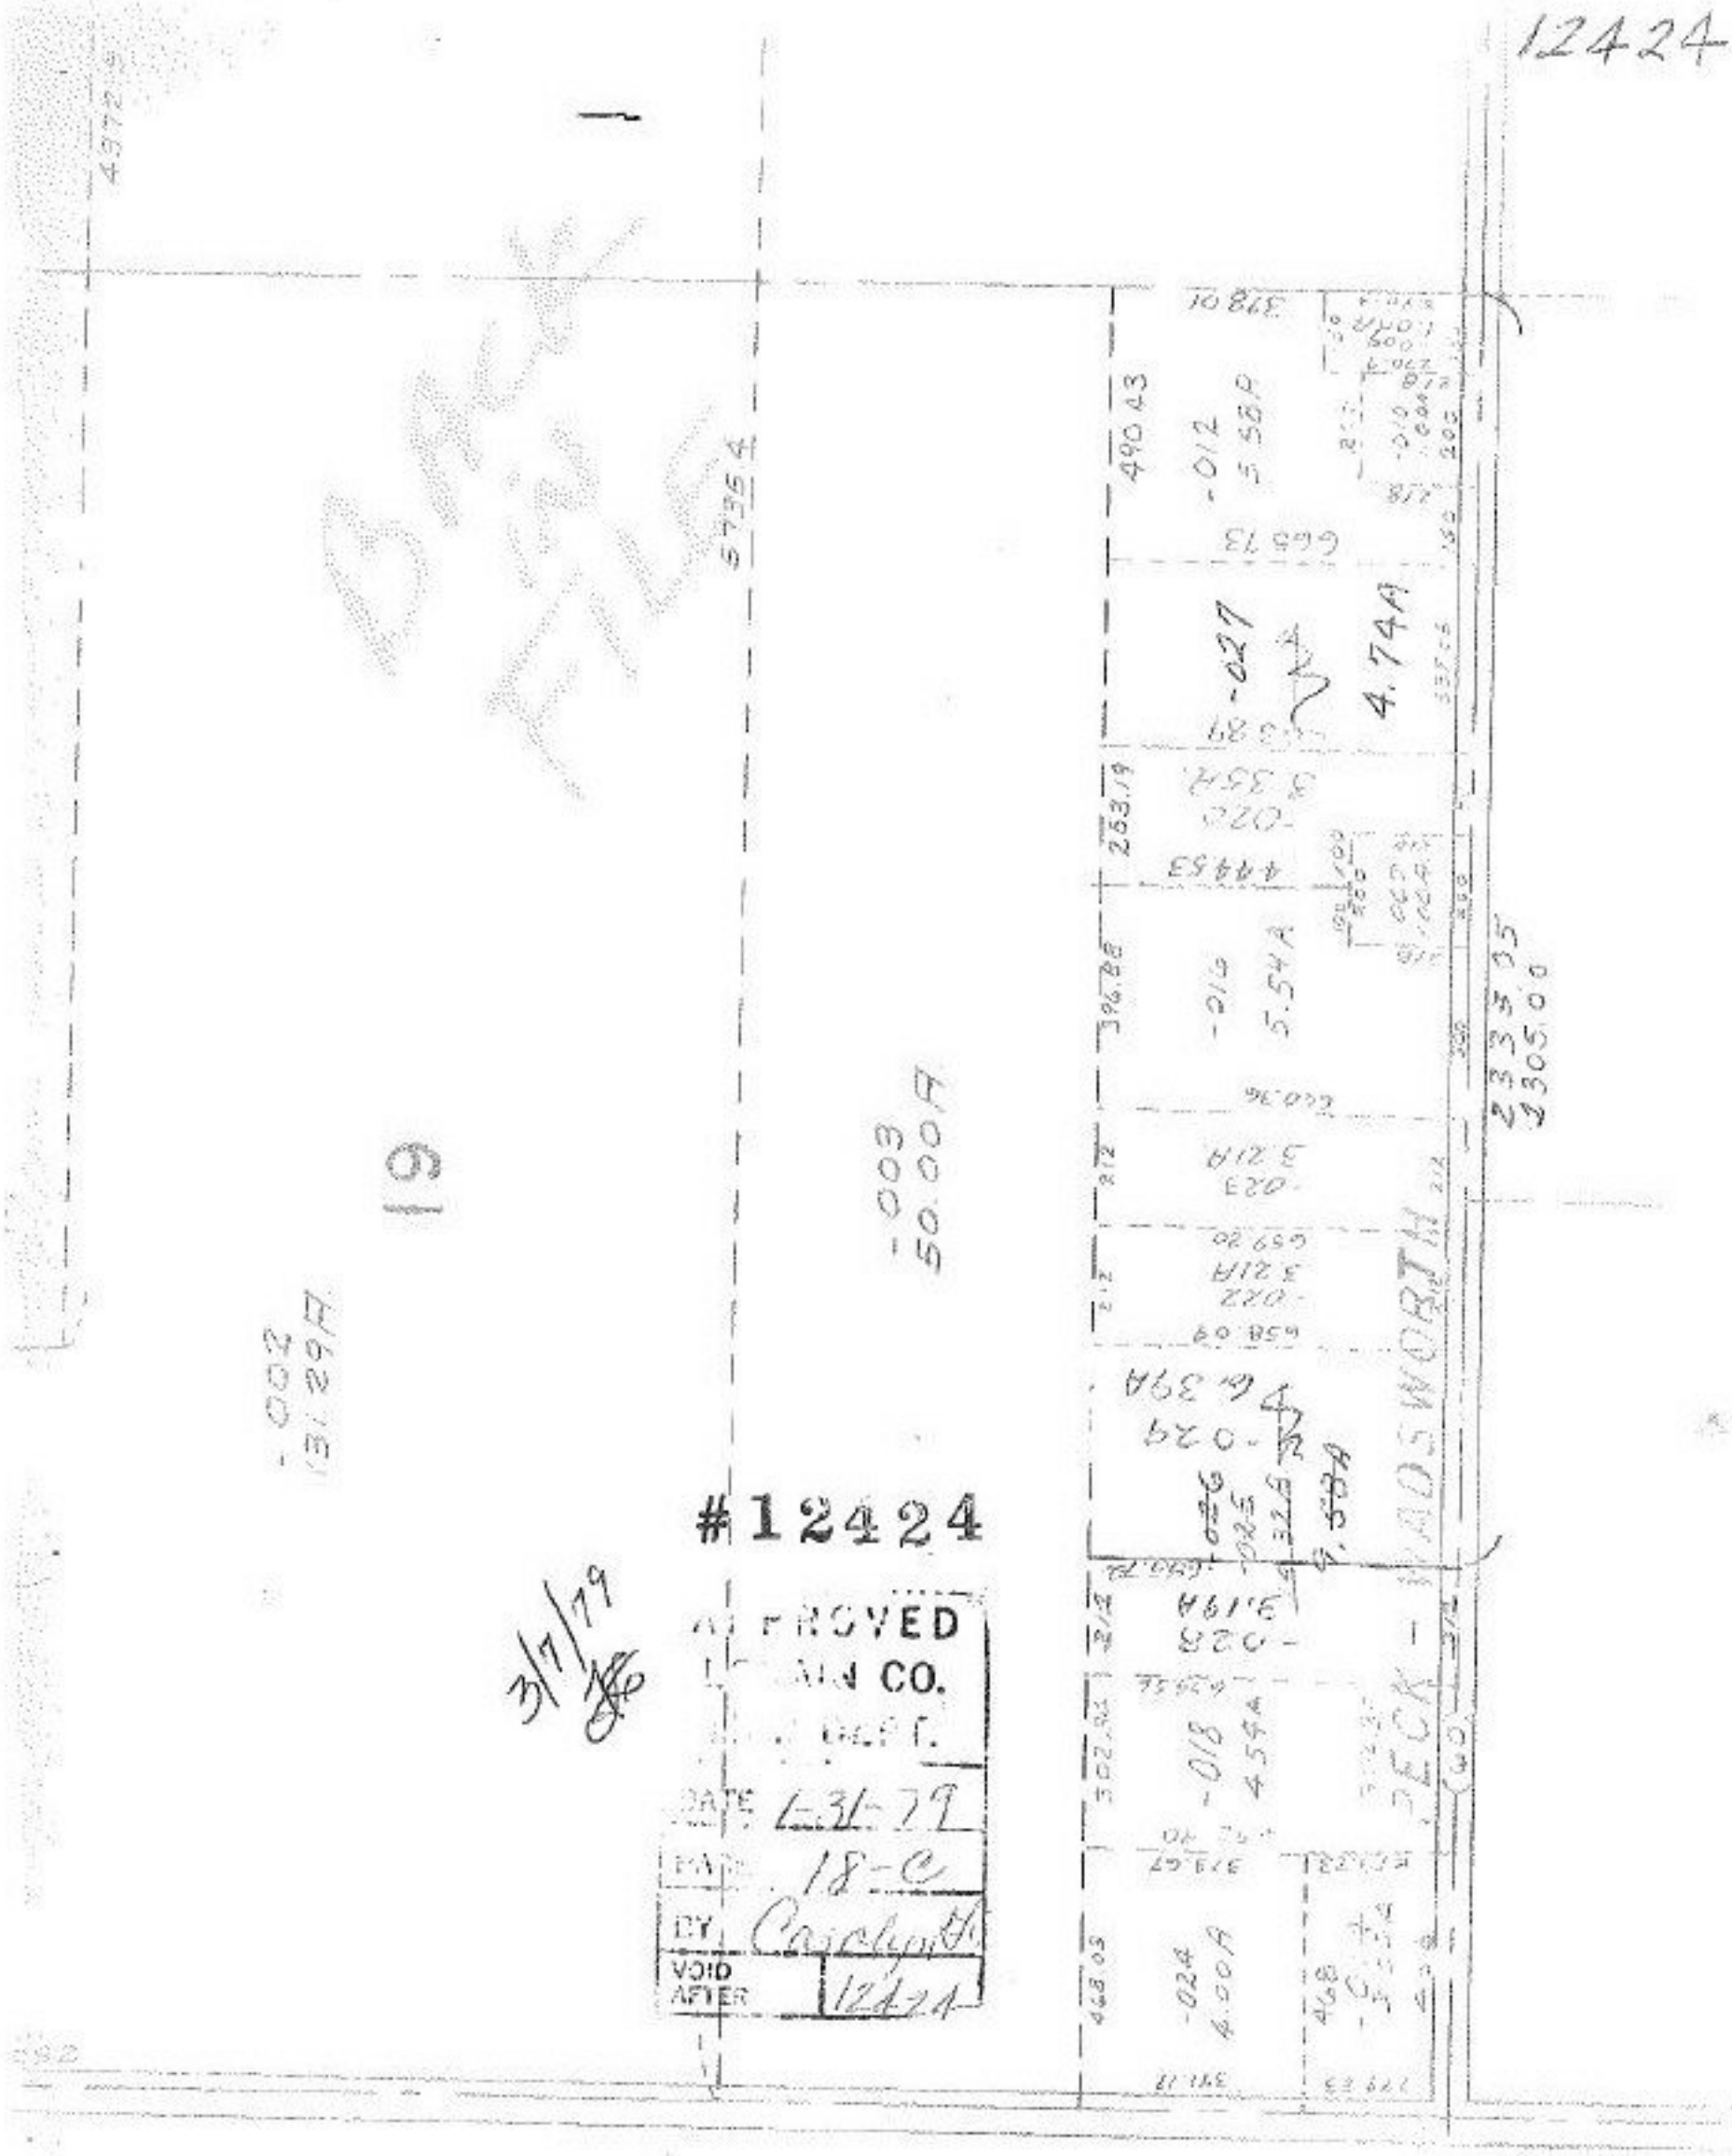

#12424

3/7/79

APPROVED
... CO.
... DEPT.
DATE 1-31-79
PAGE 18-C
BY Carolyn H.
VOID AFTER 12424