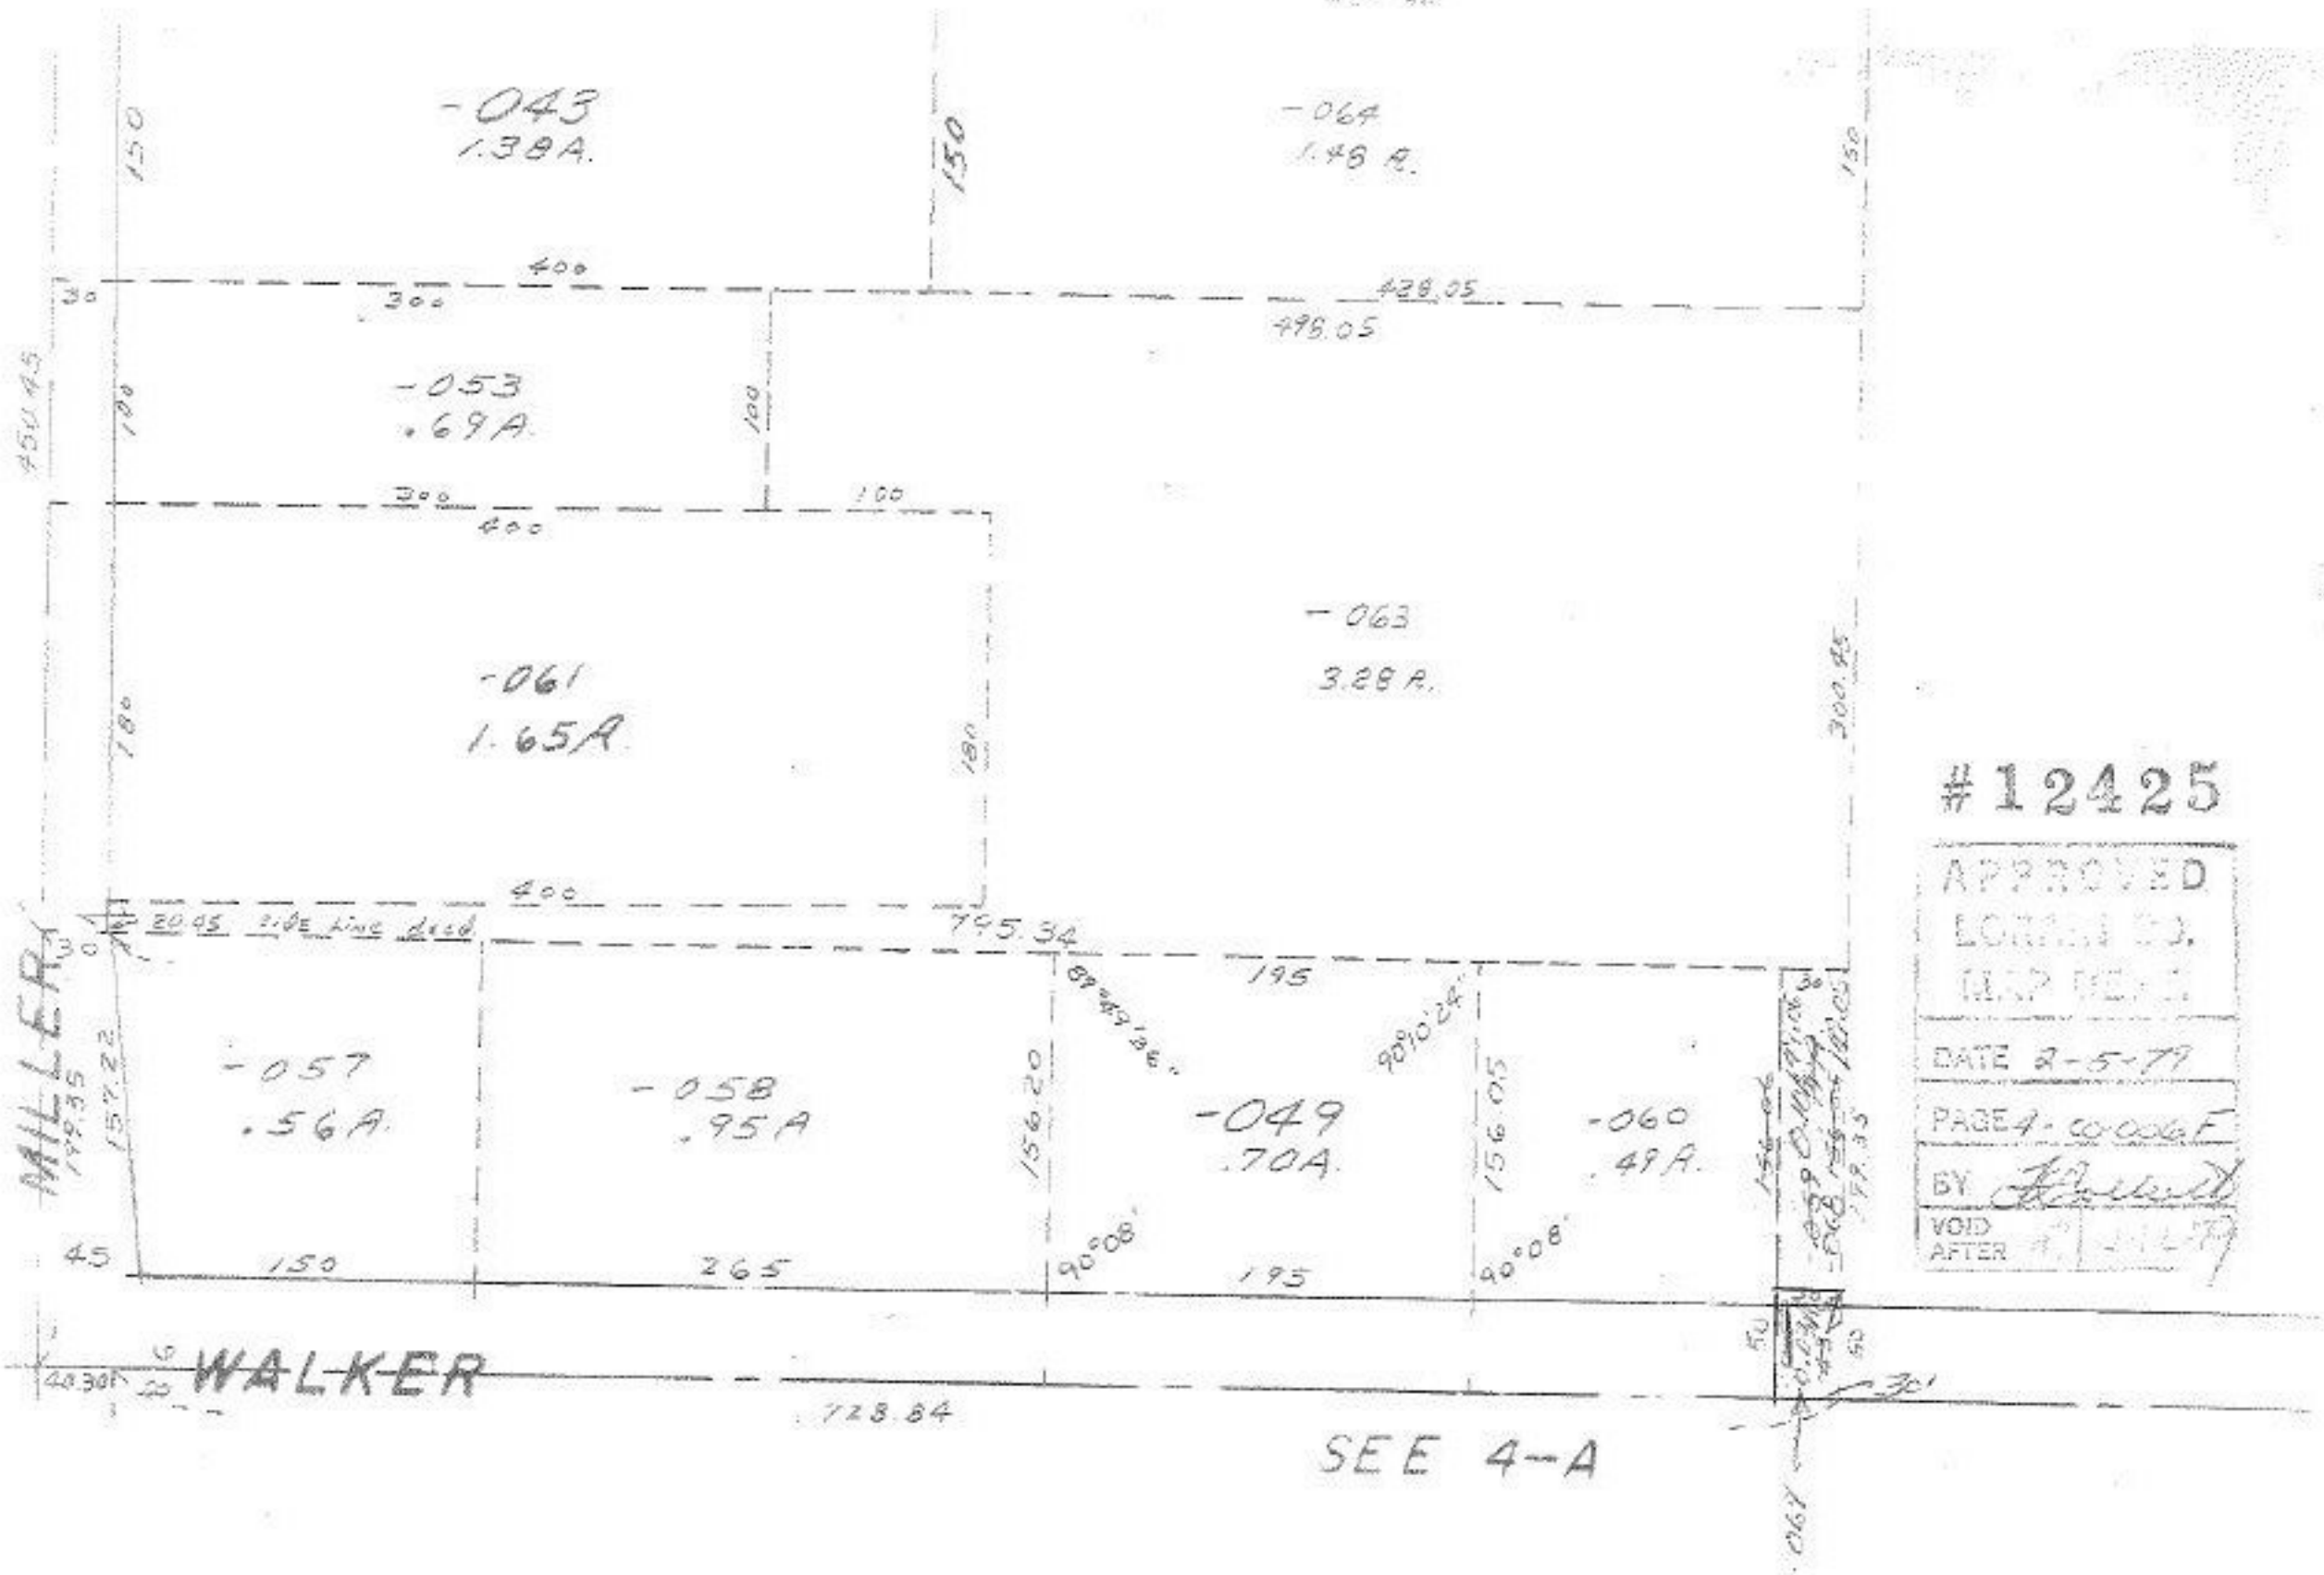
-043
1.38A.
-064
1.48 A.
-053
.69A.
-061
1.65A
-063
3.28 A.
-057
.56A.
-058
.95A
-049
.70A.
-060
.49A.
MILLER
WALKER
20.45 side line deed
795.34
728.84
450.45
300.45
428.05
498.05
156.20
156.05
157.22
199.35
90°08'
90°10'24"
SEE 4-A
#12425
APPROVED
LORAIN CO.
MAP DEPT.
DATE 2-5-79
PAGE 4-00006F
BY
VOID AFTER