12435
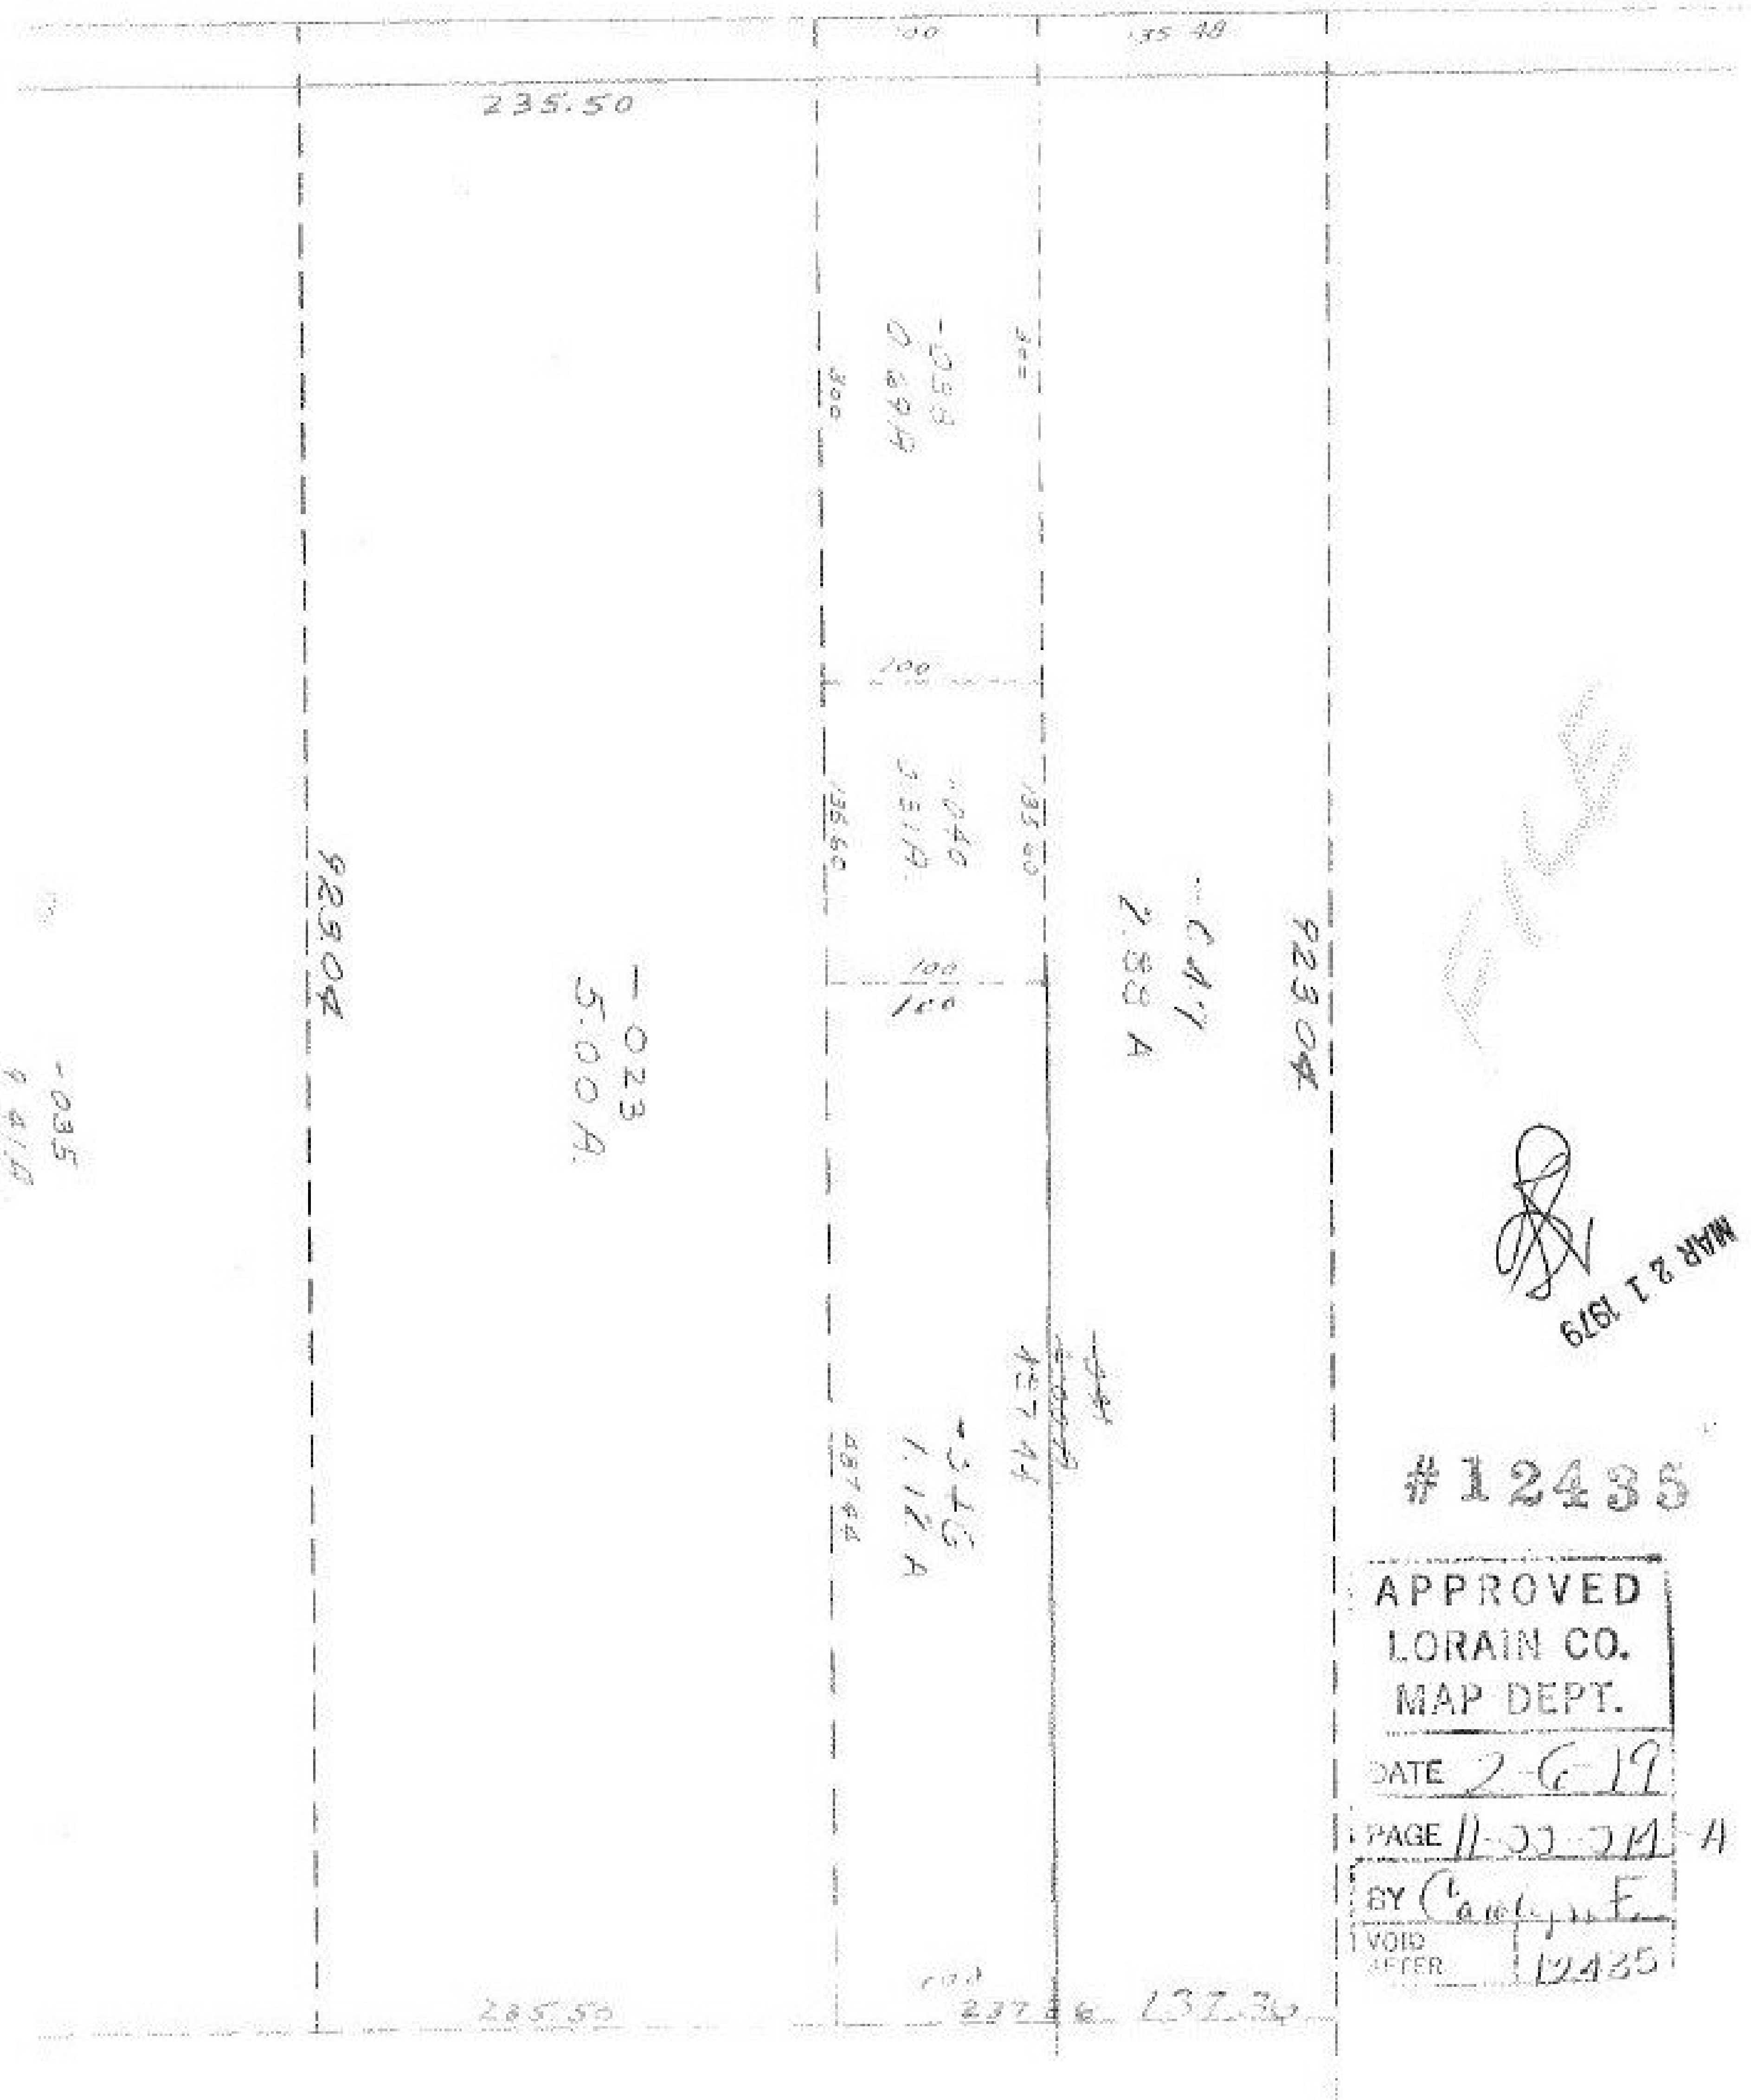
SEE 11-A