12445

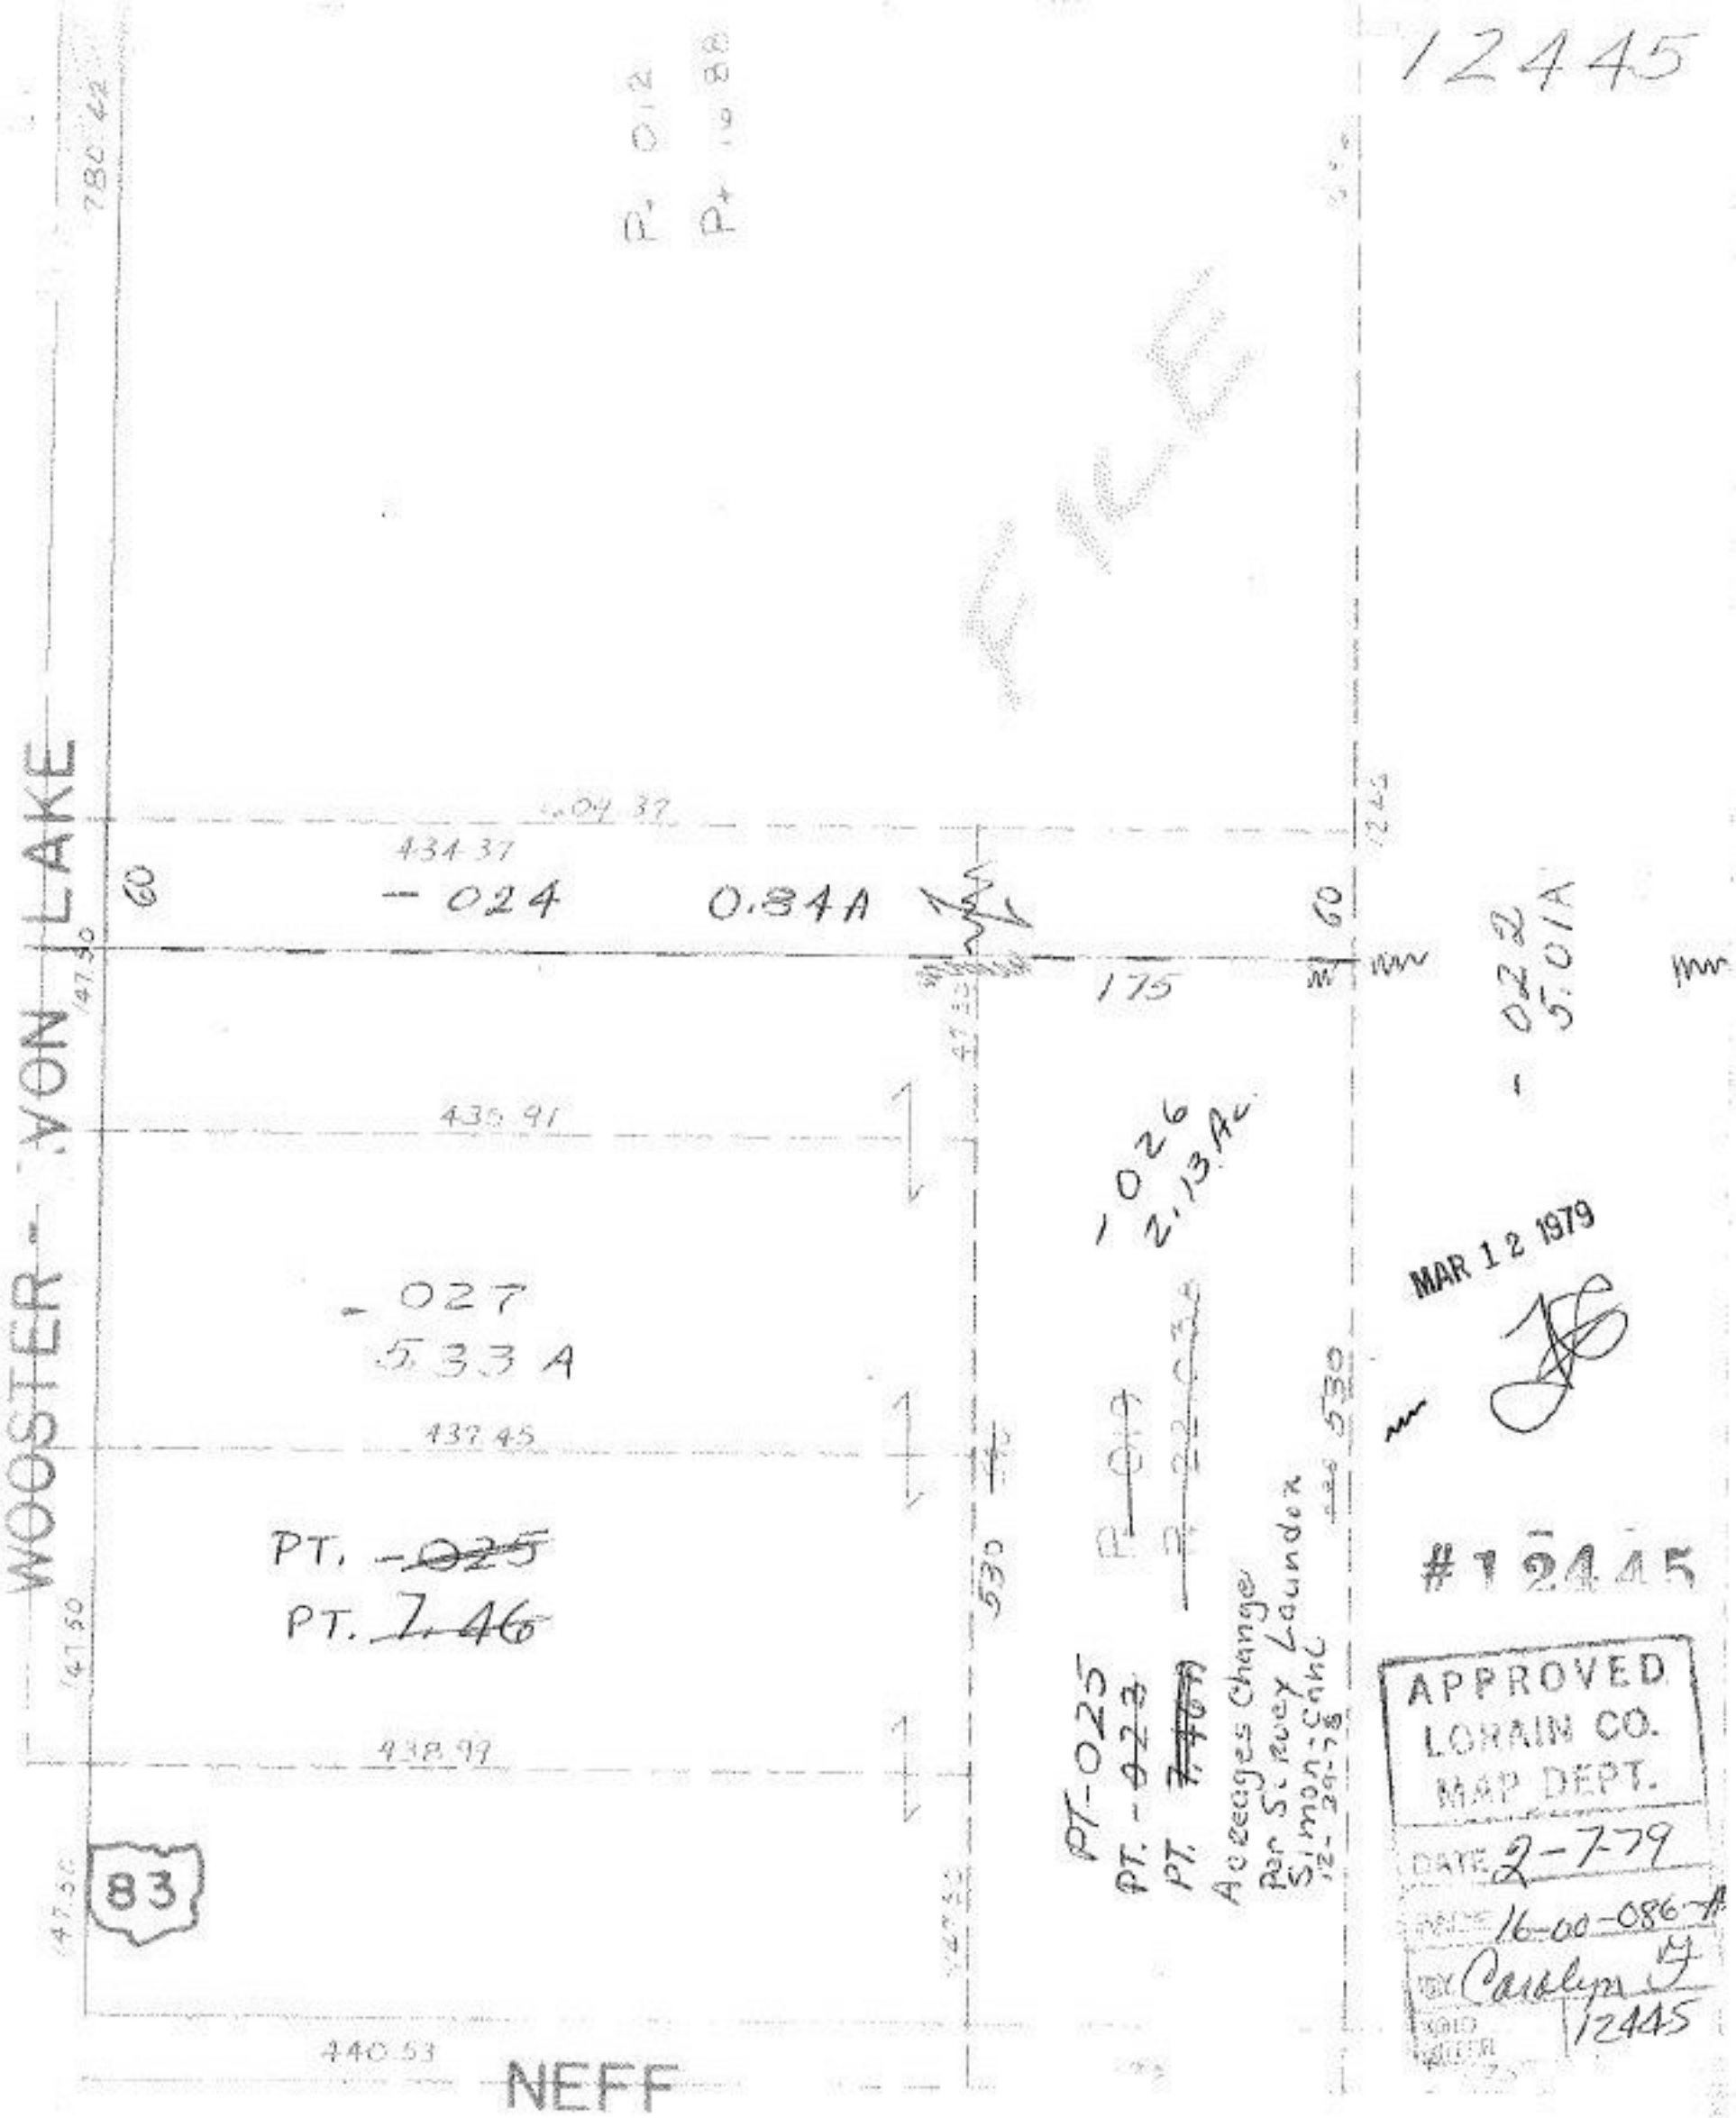

WOOSTER - VON LAKE
NEFF
83
FILE
780.42
434.37
-024
0.84A
60
175
435.91
-027
5.33 A
437.45
PT. ~~-025~~
PT. ~~7.46~~
438.99
440.53
530
-026
2.13 Ac
-022
5.01A
PT-025
PT. -~~023~~
PT. ~~7.46~~
Acreages Change
Per Survey Laundex
Simon-Cahl
12-29-78
MAR 12 1979
#12445
APPROVED
LORAIN CO.
MAP DEPT.
DATE 2-7-79
PAGE 16-00-086-A
BY Carolyn
12445