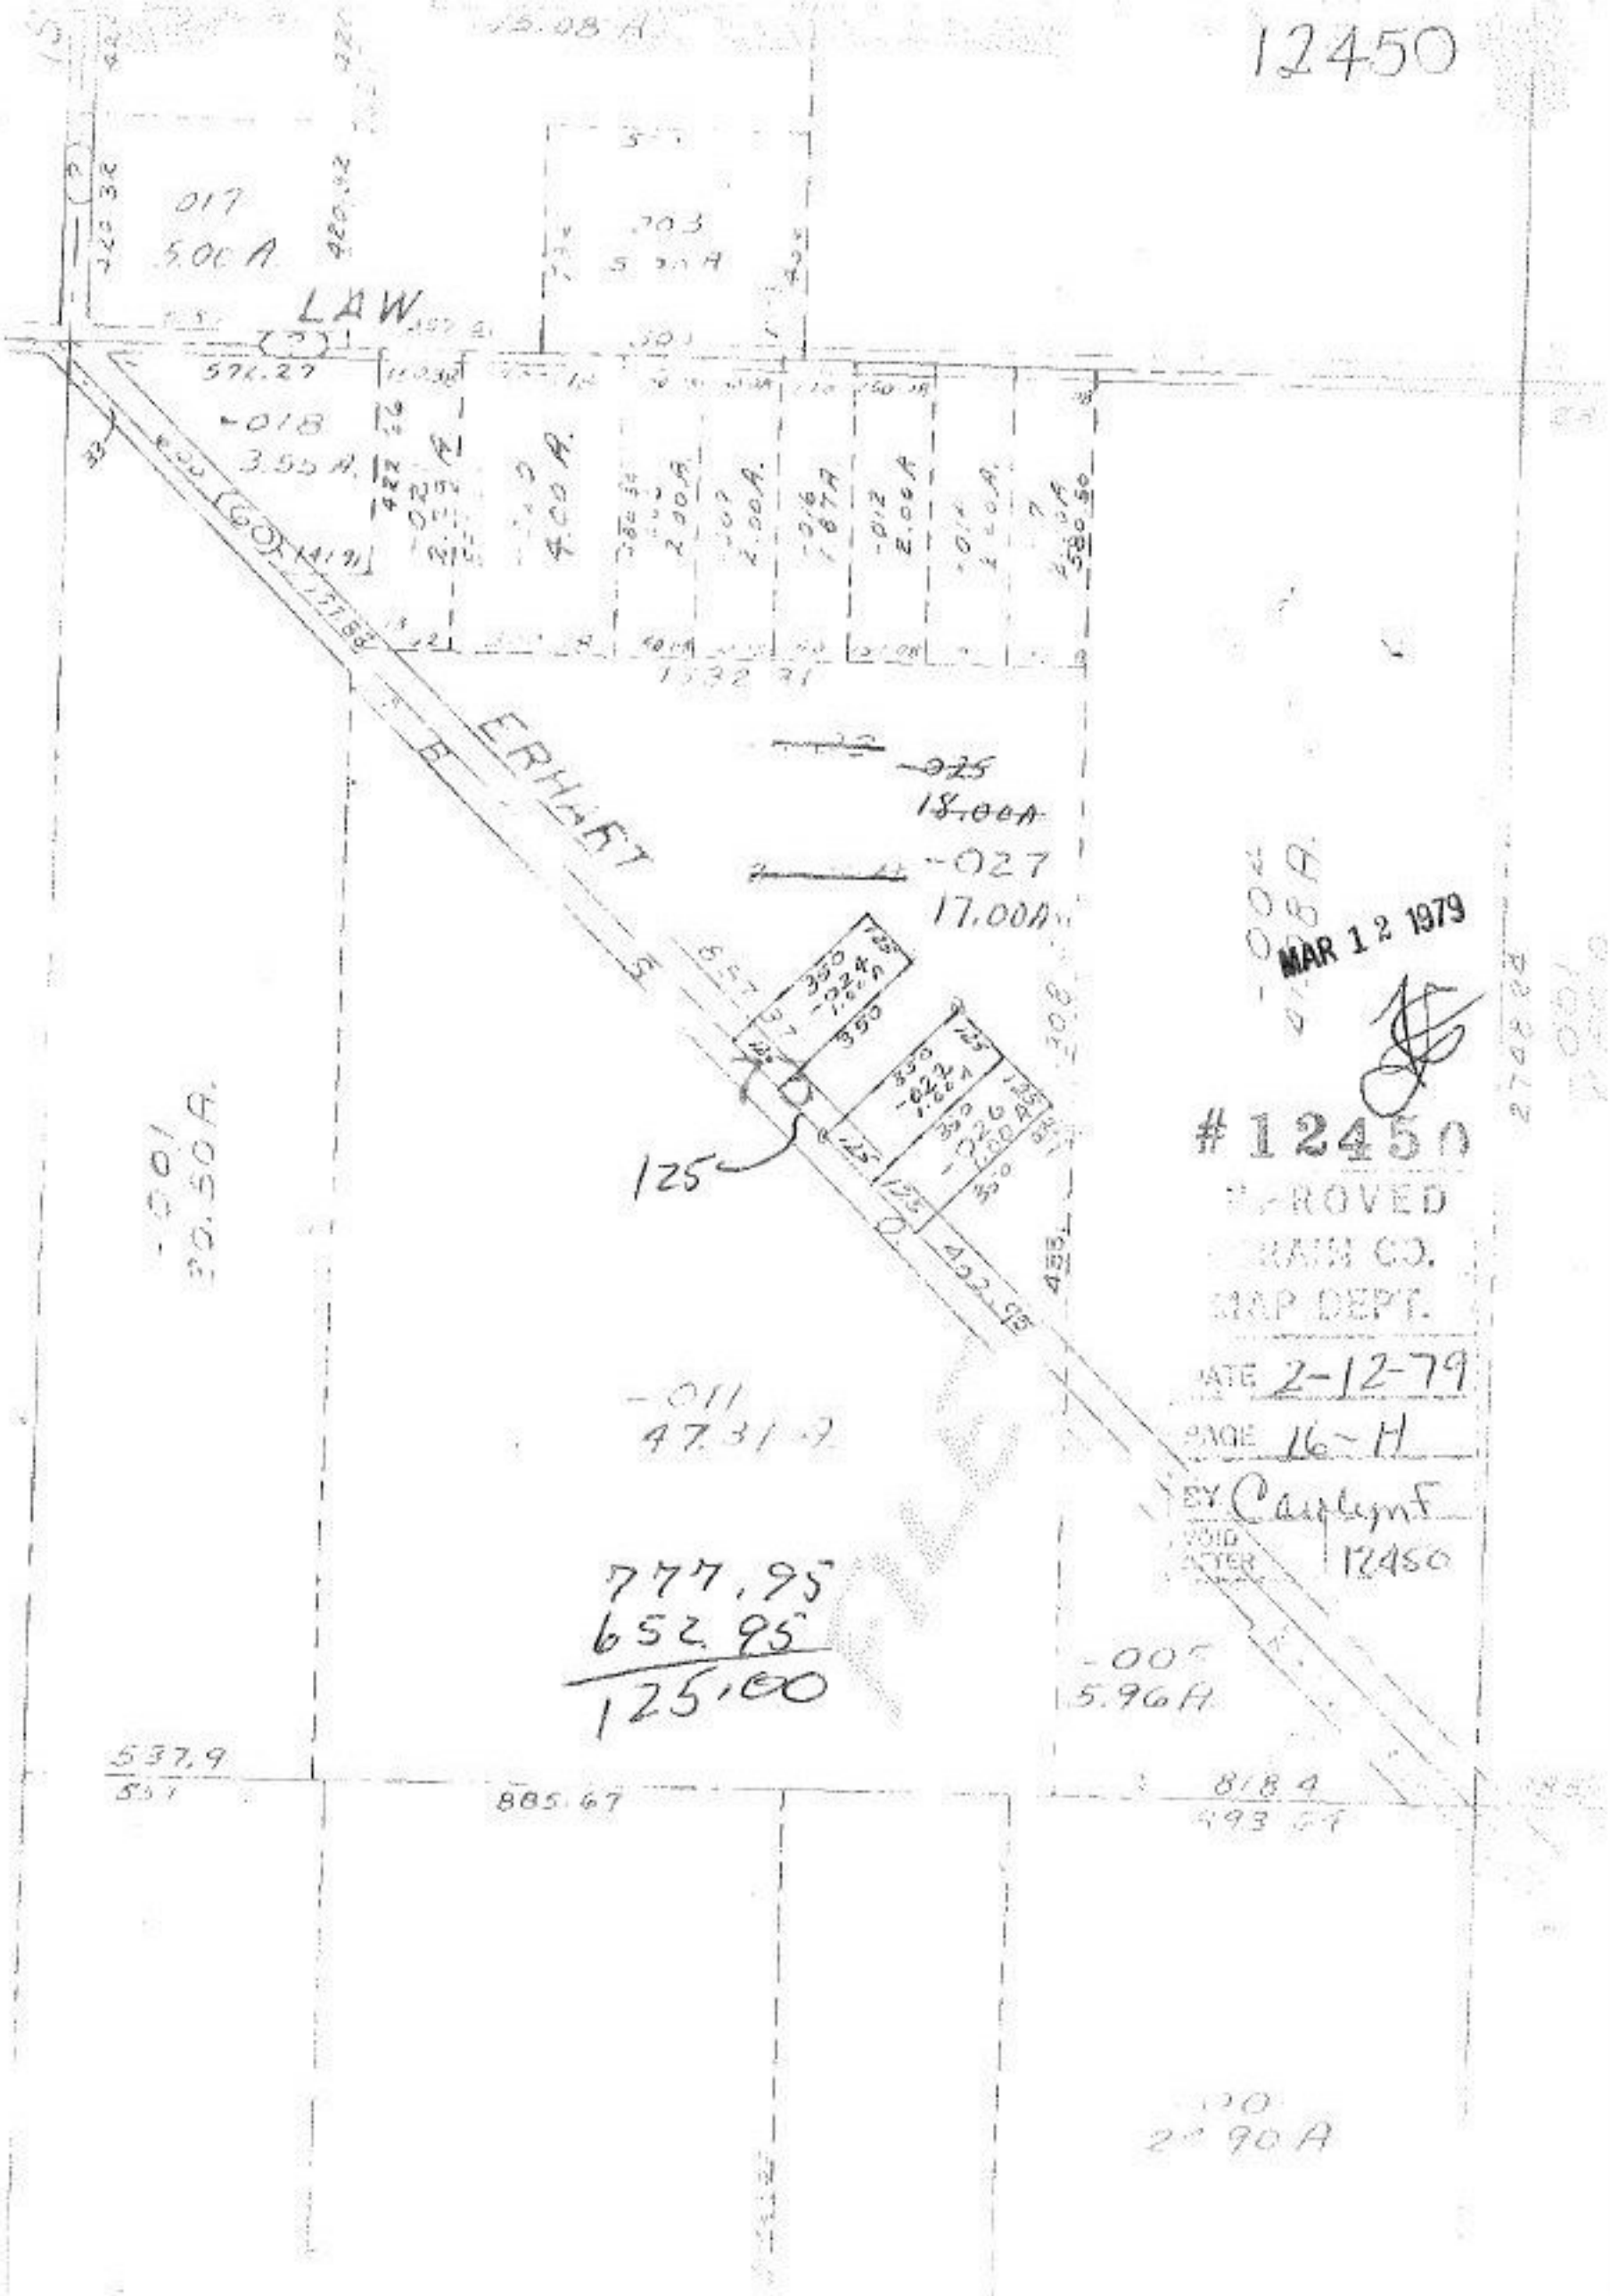
12450
LAW
ERHART
-017
5.00 A
-018
3.55 A
-025
18.00A
-027
17.00A
125
-011
47.31 A
777.95
652.95
125.00
-005
5.96A
537.9
885.67
818.4
MAR 12 1979
#12450
APPROVED
DRAIN CO.
MAP DEPT.
DATE 2-12-79
PAGE 16-H
BY Carolyn F
VOID
AFTER 12450