12465

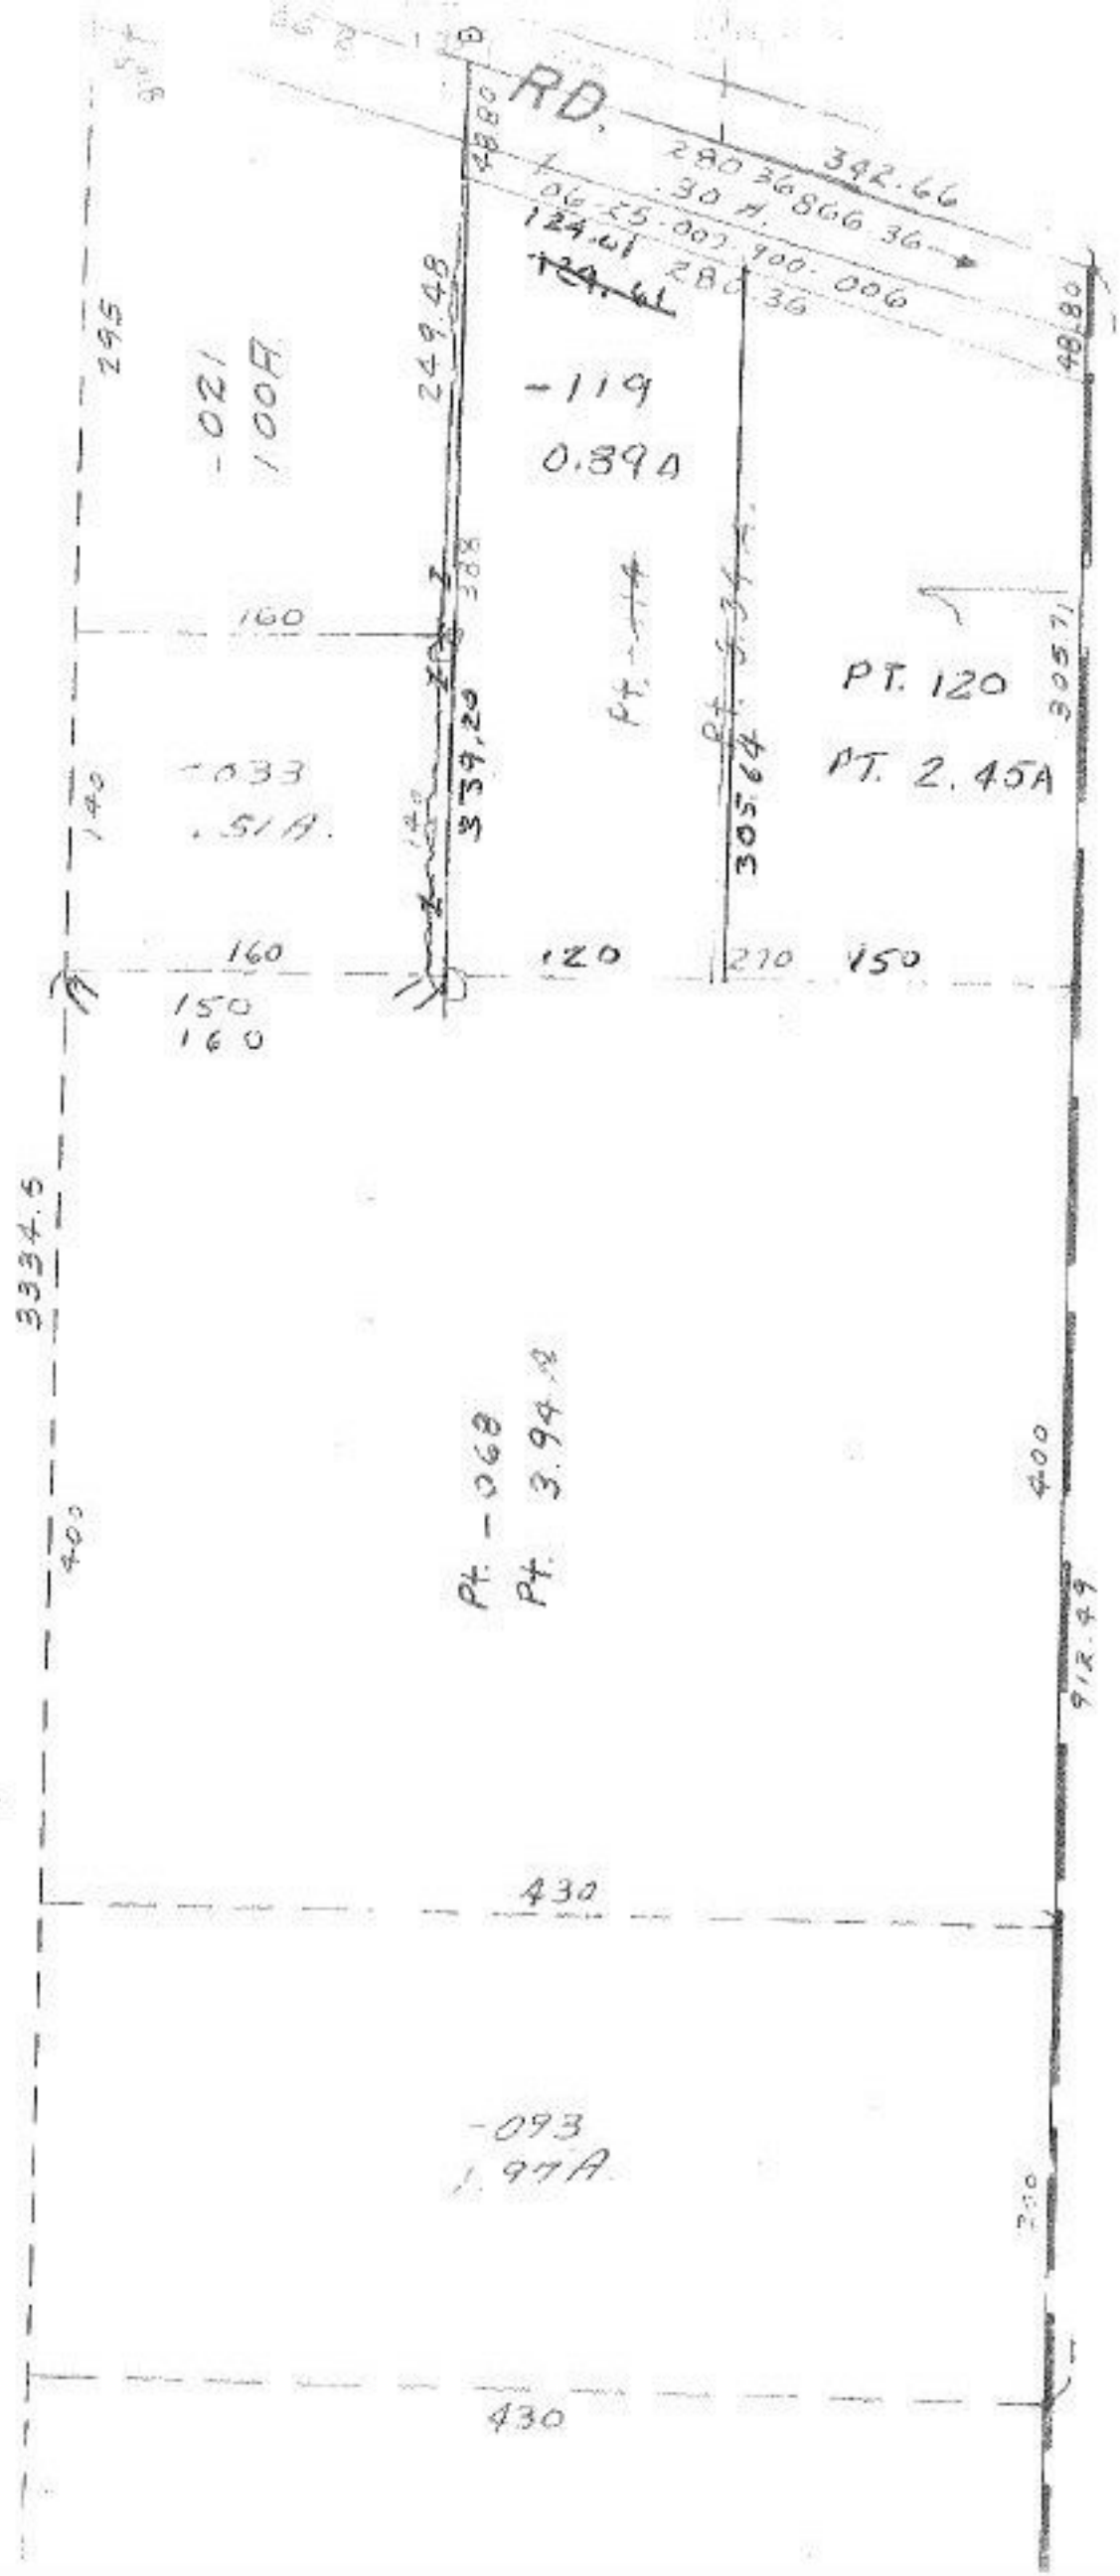

MAY 7 1979

#12465

APPROVED
LAND DIV.
MAP DEPT.
DATE 2-20-79
PAGE 6-125 6-126
BY Carolyn L.
VOID AFTER 12465