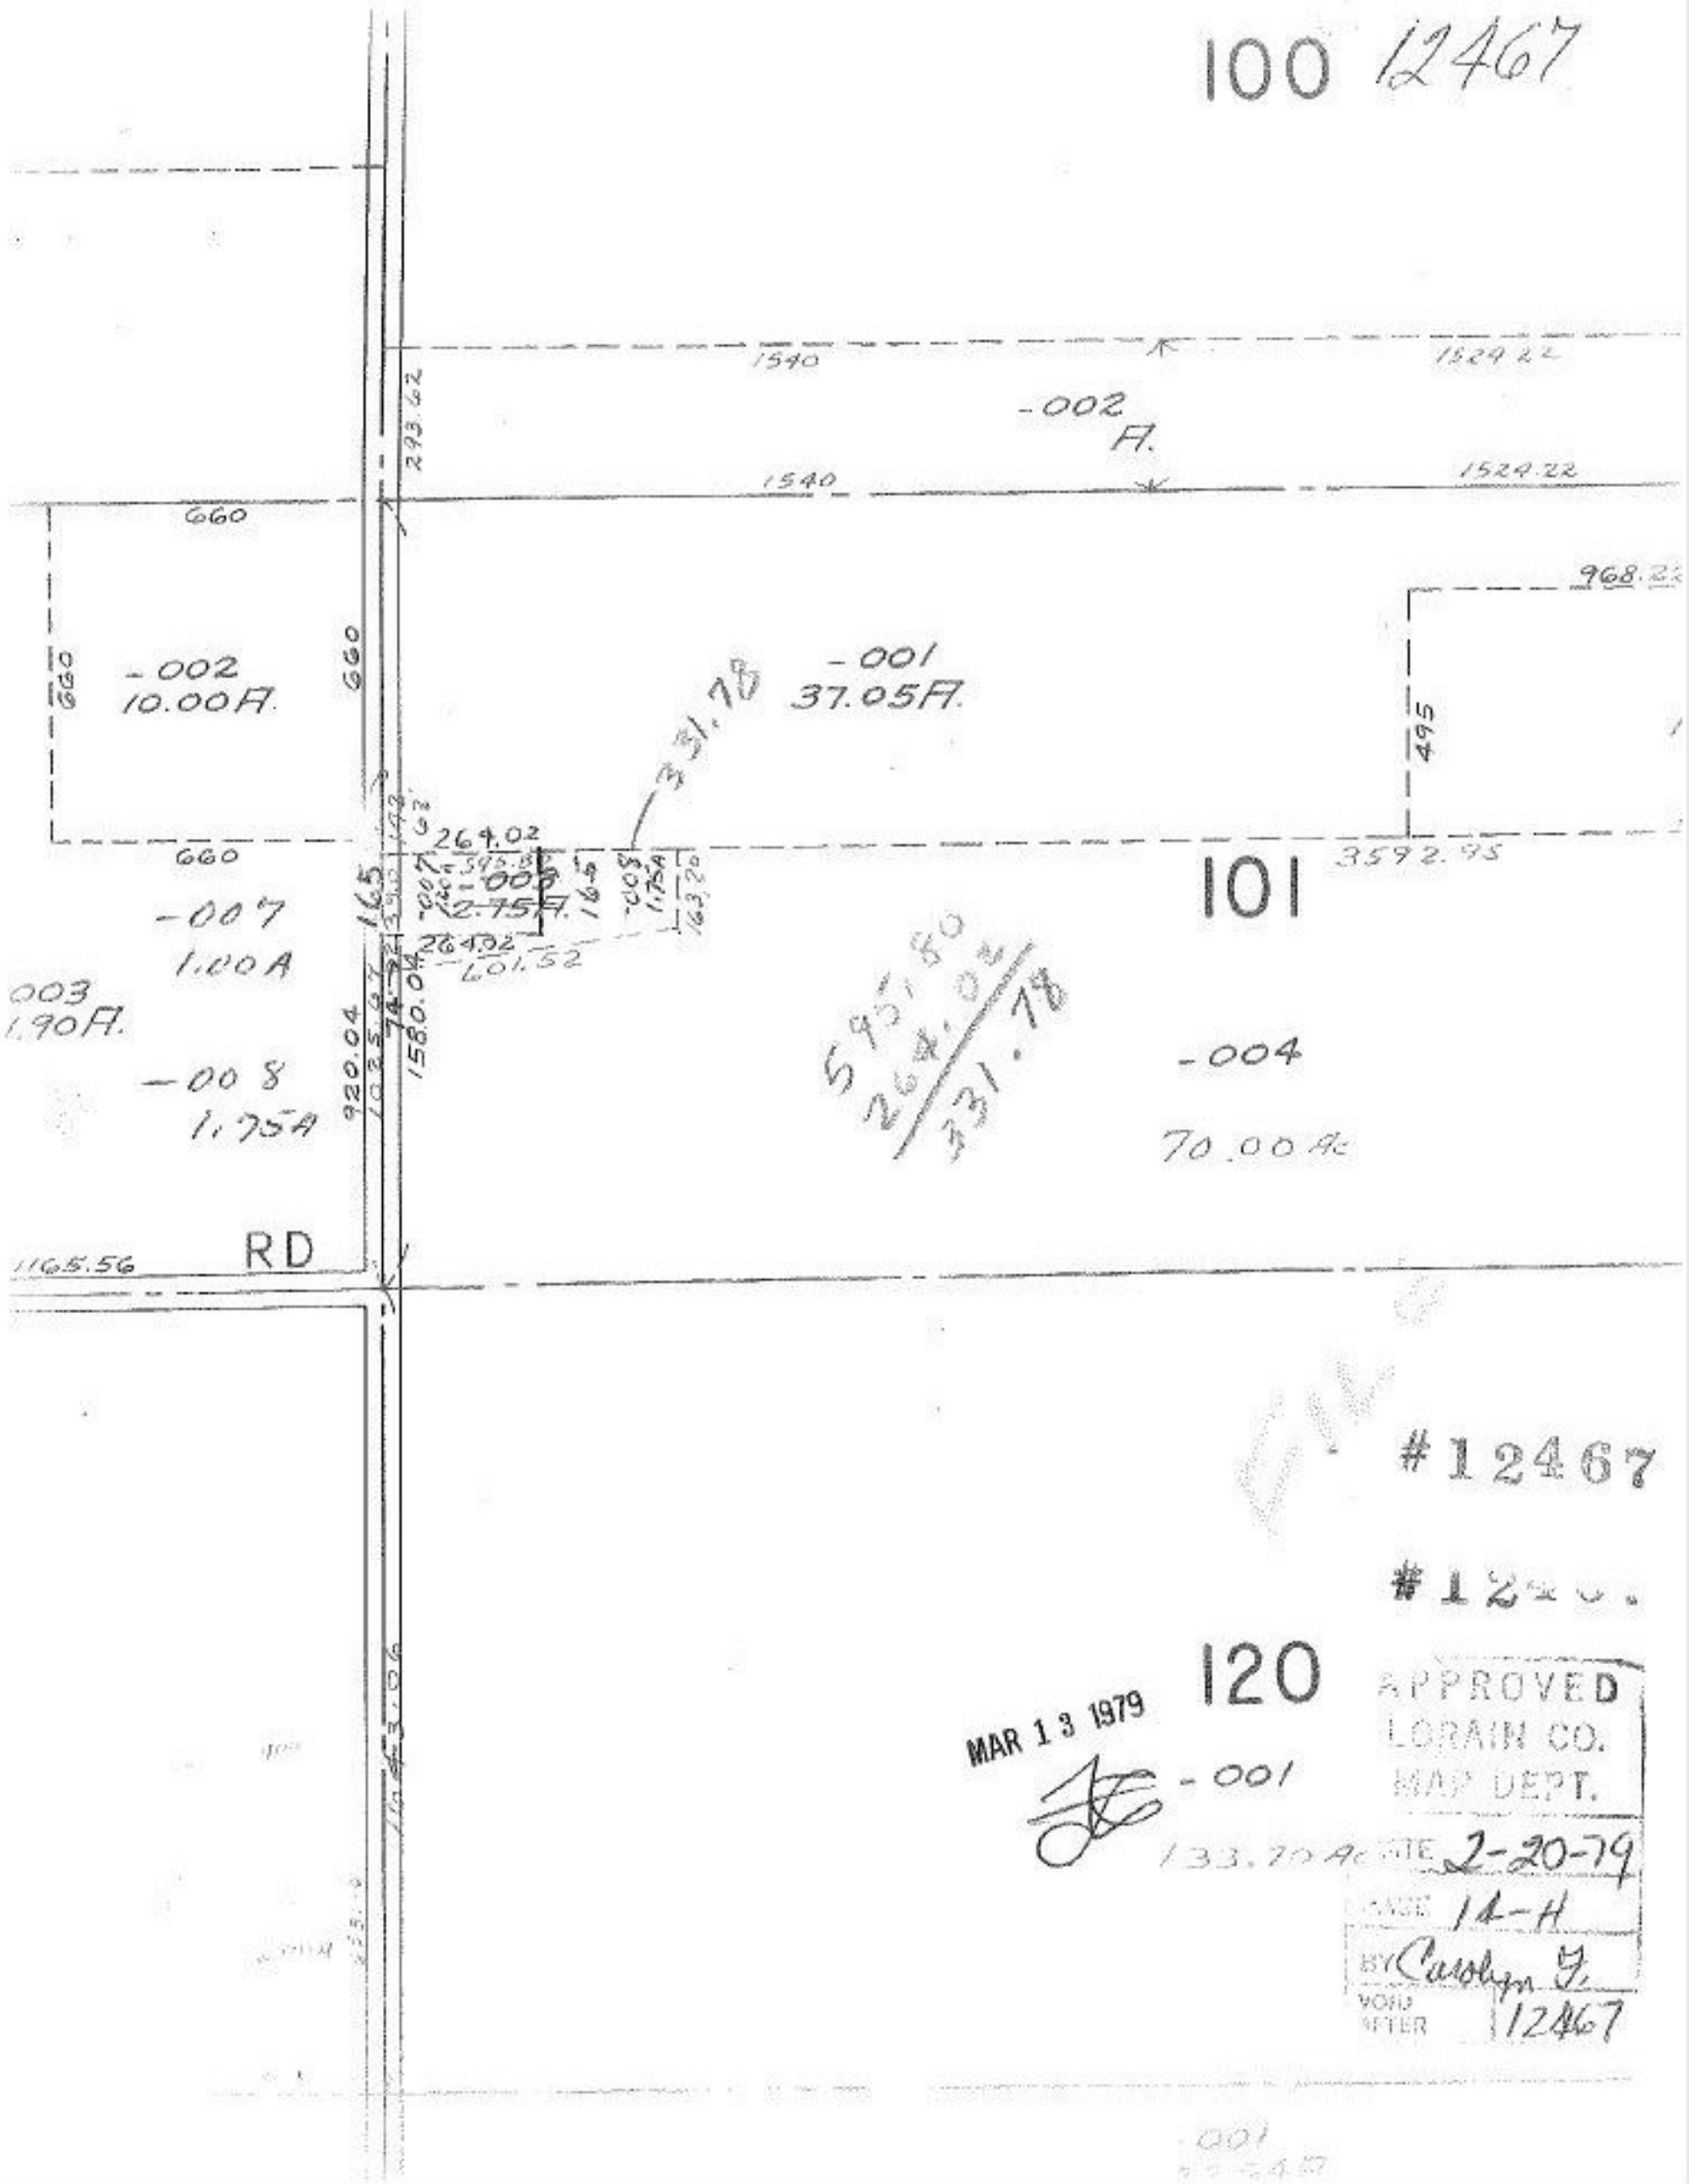
100 12467
1540
1524.22
-002
A.
293.62
1540
1524.22
660
968.22
-002
10.00A.
660
660
-001
37.05A.
331.78
495
264.02
660
3592.95
101
-007
1.00A
165
-008
2.75A.
165
-008
1.75A
163.20
264.02
601.52
003
1.90A.
1580.04
920.04
-008
1.75A
595.80
264.02
331.78
-004
70.00 Ac
1165.56
RD
#12467
#12
120
MAR 13 1979
-001
133.70 Ac
APPROVED
LORAIN CO.
MAP DEPT.
DATE 2-20-79
PAGE 14-H
BY Carolyn F.
VOID AFTER 12467
-001