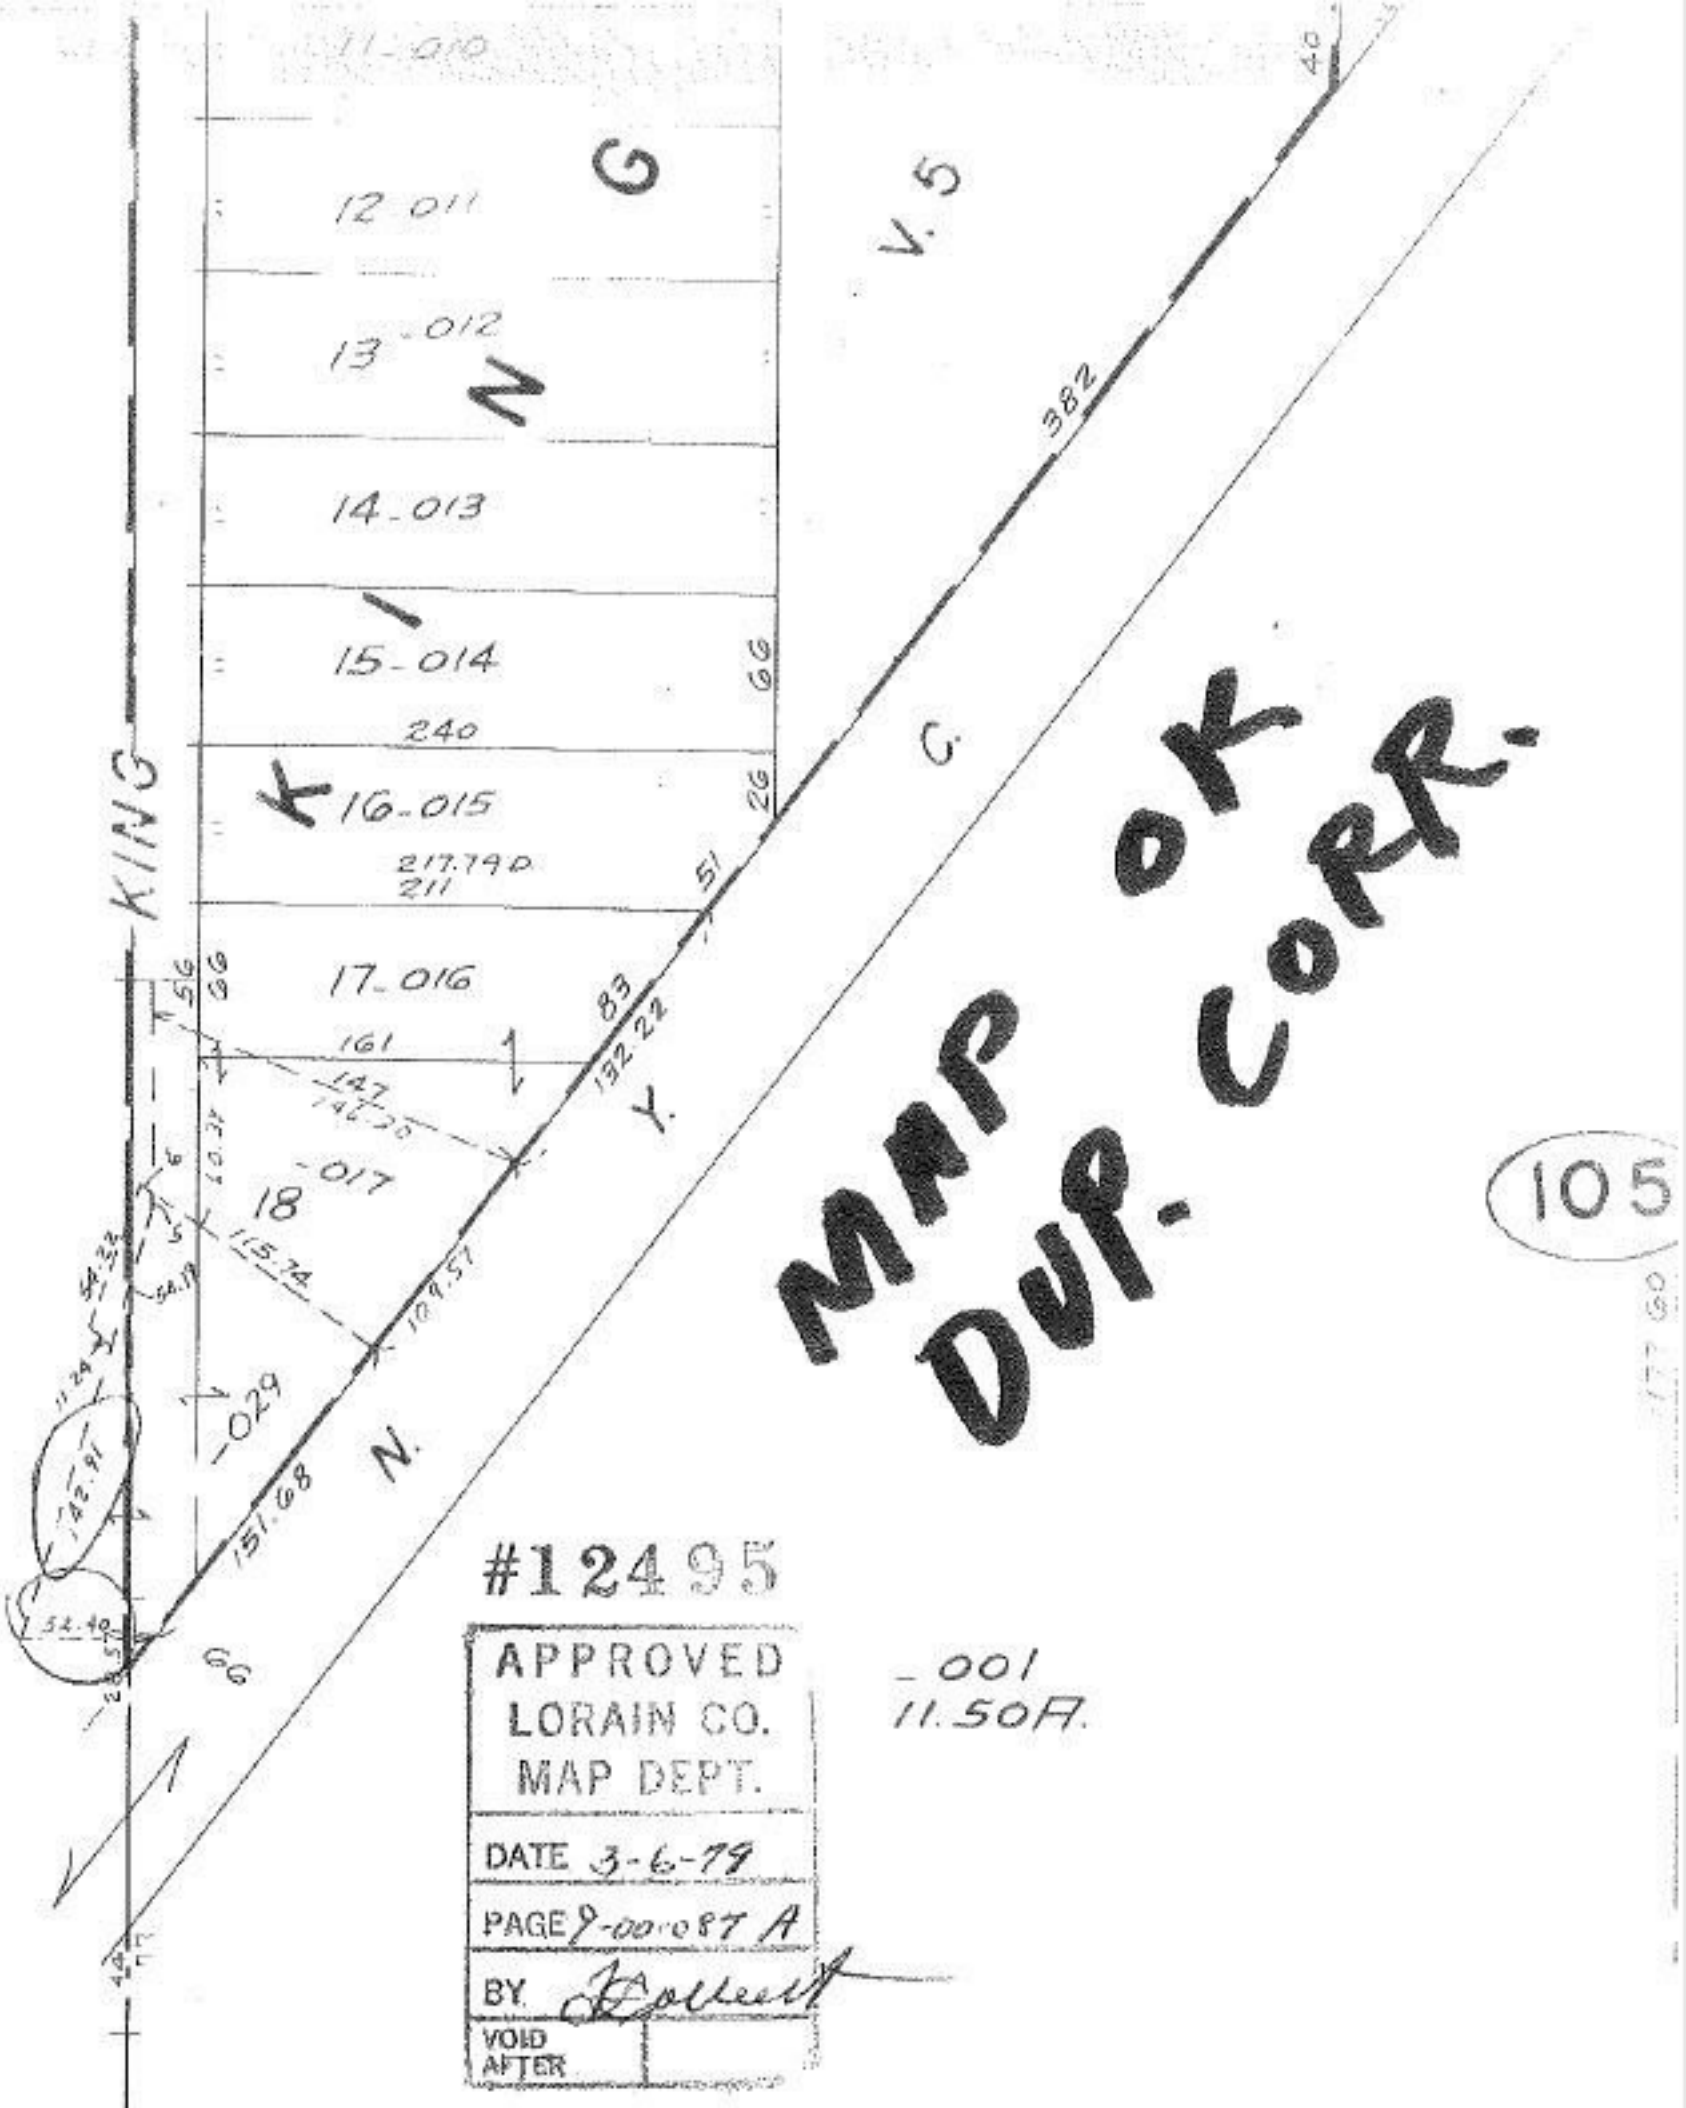

#12495

APPROVED
LORAIN CO.
MAP DEPT.
DATE 3-6-79
PAGE 9-00-087 A
BY
VOID AFTER

-001
11.50A.

9-00-087-A.