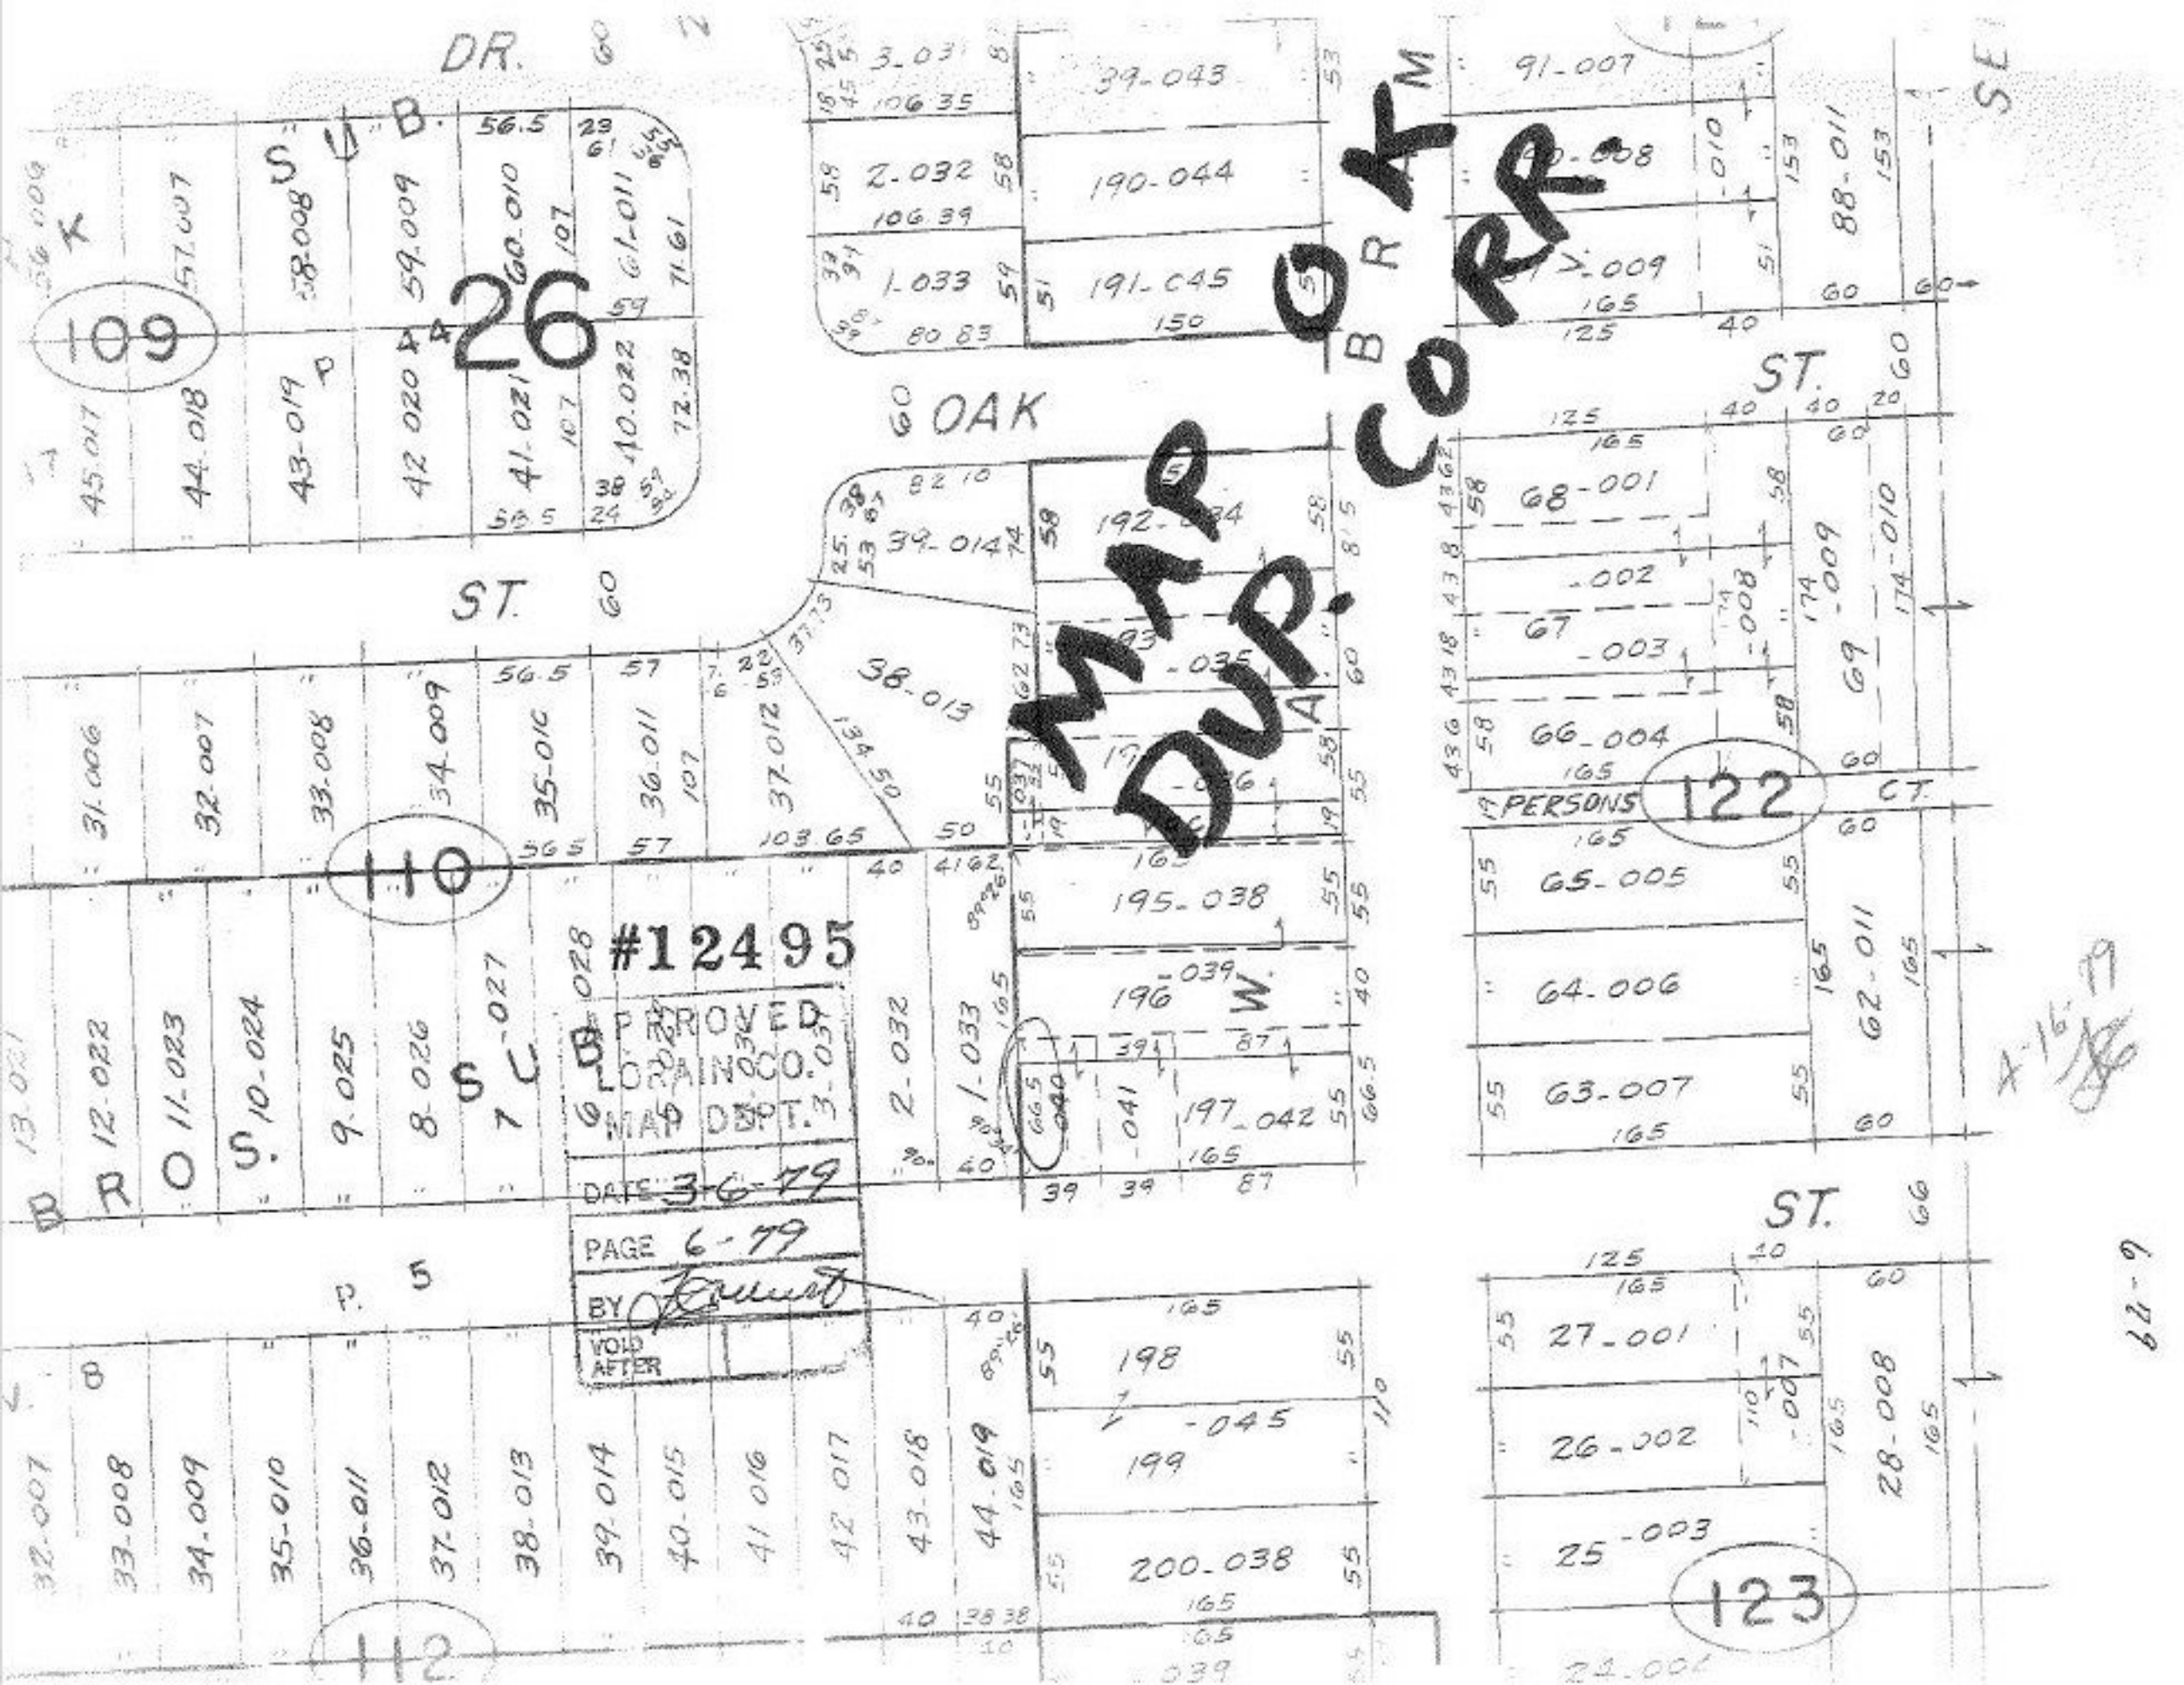

MAP OK
DUP. CORR.
#12495
APPROVED
LORAIN CO.
MAP DEPT.
DATE 3-6-79
PAGE 6-79
BY
VOID AFTER
DR.
SUB.
OAK
ST.
PERSONS
CT.
BROS.
109
110
112
122
123
26
4-16-79
6-79