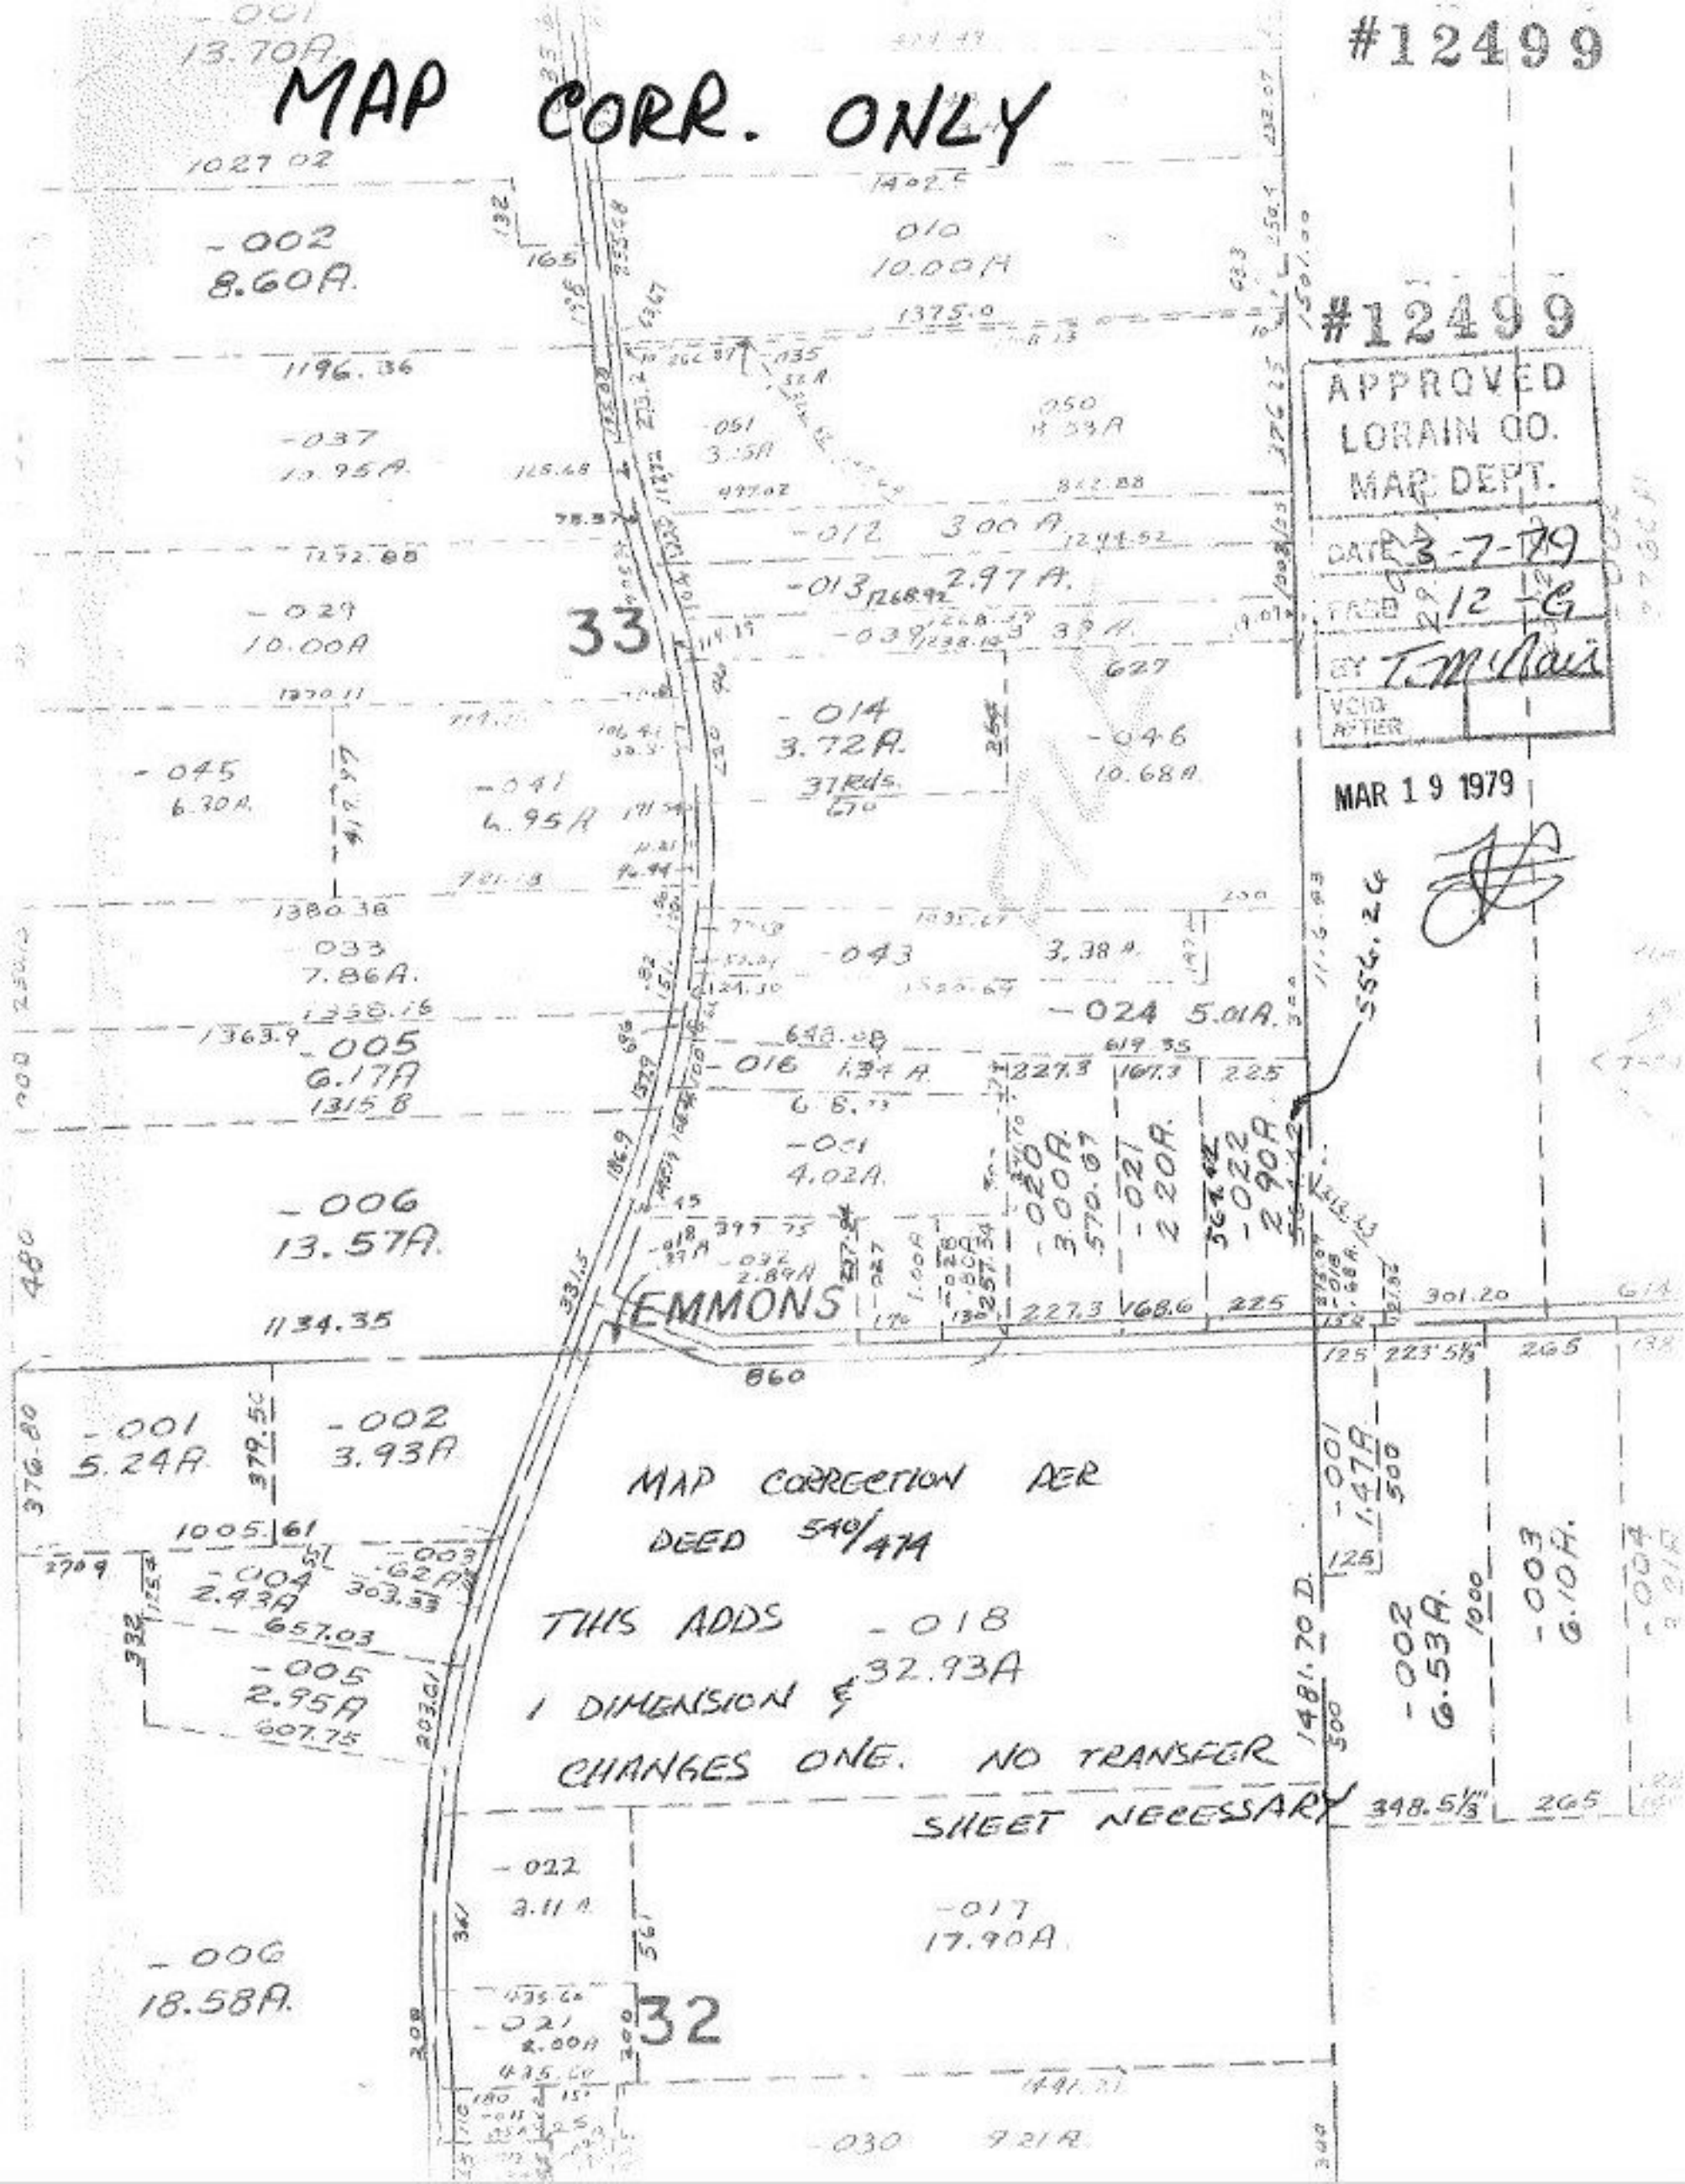

MAP CORR. ONLY
#12499
#12499
APPROVED
LORAIN CO.
MAP DEPT.
DATE 3-7-79
PAGE 12-G
BY T. McNair
VOID AFTER
MAR 19 1979
-001 13.70A
-002 8.60A
010 10.00A
-037 10.95A
-012 3.00A
-013 2.97A
-029 10.00A
33
-014 3.72A
-046 10.68A
-045 6.30A
-041 6.95A
-033 7.86A
-043 3.38A
-024 5.01A
-005 6.17A
-016 1.34A
-021 4.02A
-006 13.57A
-020 3.00A
-021 2.20A
-022 2.90A
EMMONS
-001 5.24A
-002 3.93A
MAP CORRECTION PER
DEED 540/474
THIS ADDS -018
32.93A
1 DIMENSION &
CHANGES ONE. NO TRANSFER
SHEET NECESSARY
-004 2.43A
-003 .62A
-005 2.95A
-001 1.47A
-002 6.53A
-003 6.10A
-022 3.11A
-017 17.90A
-006 18.58A
32
-030 9.21A