12501

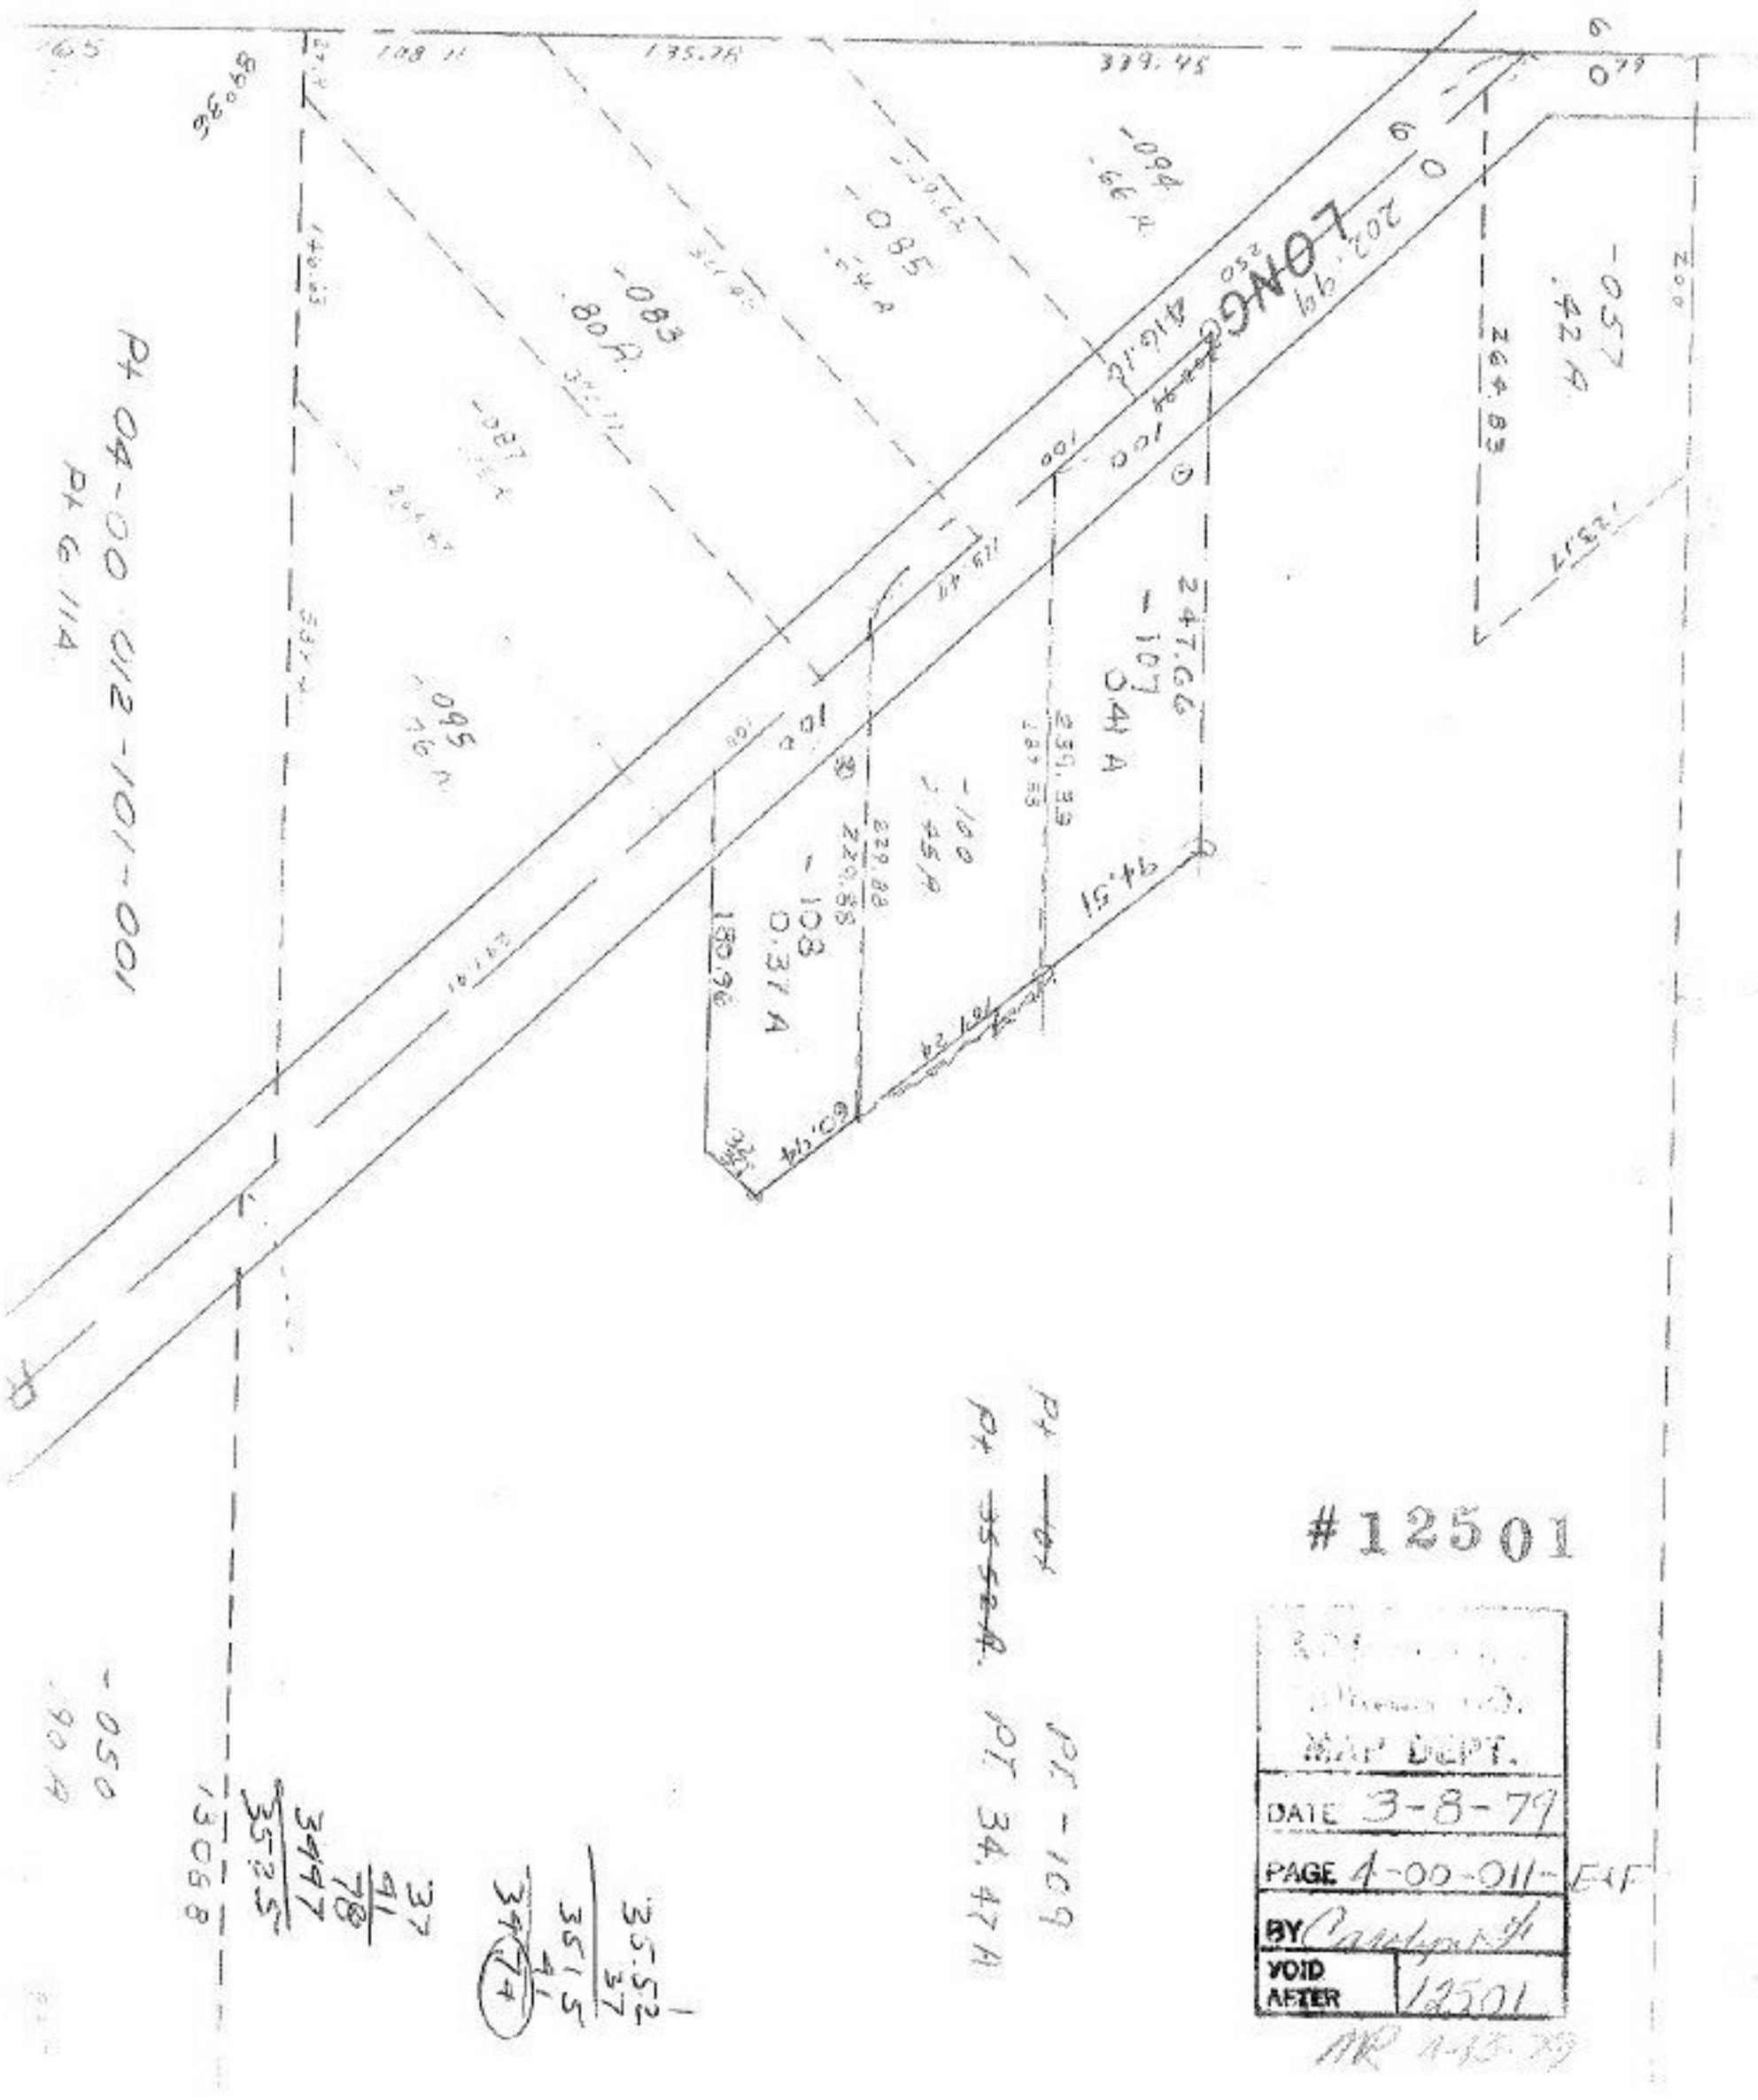

#12501

MAP DEPT.
DATE 3-8-79
PAGE 4-00-011-E&F
BY
VOID AFTER 12501