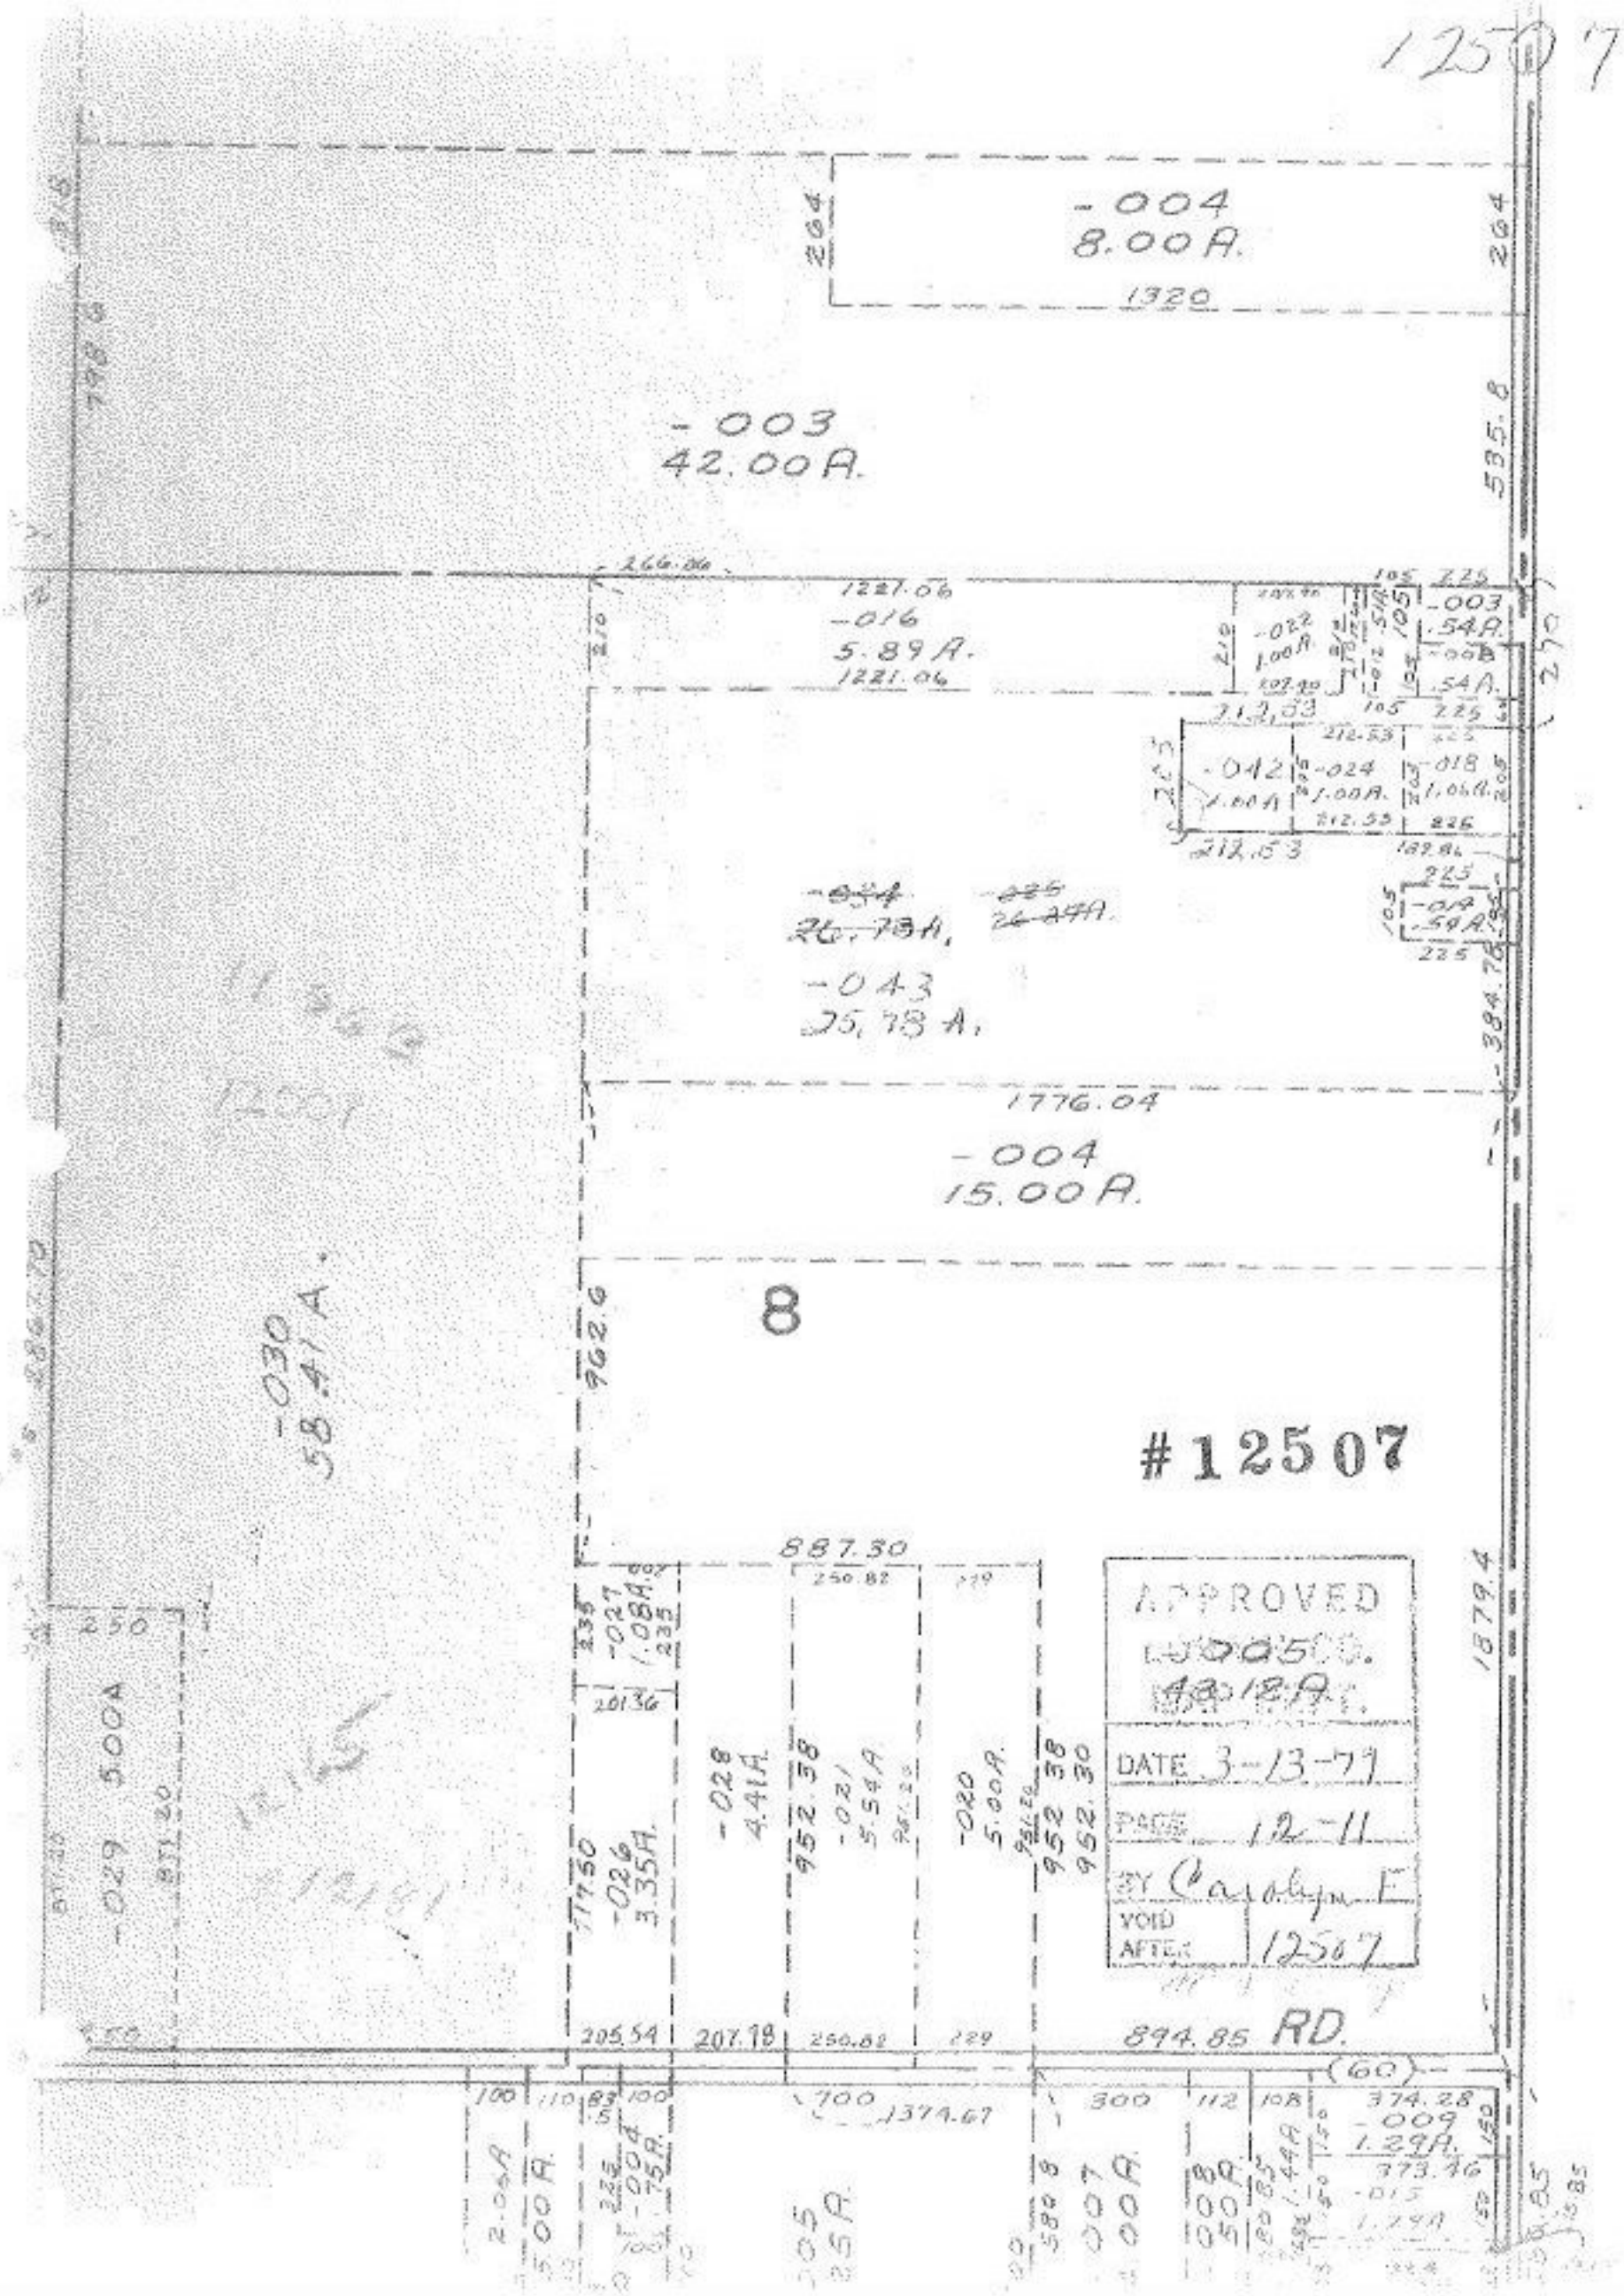
12507
-004
8.00 A.
1320
264
-003
42.00 A.
535.8
266.06
1221.06
-016
5.89 A.
1221.06
-022
1.00 A.
-003
.54 A.
-042
1.00 A.
-024
1.00 A.
-018
1.06 A.
212.53
-034
26.78 A.
-025
26.24 A.
-043
25.78 A.
384.78
1776.04
-004
15.00 A.
8
962.6
-030
58.41 A.
#12507
887.30
250.82
-027
1.08 A.
-028
4.41 A.
952.38
-021
5.54 A.
-020
5.00 A.
952.38
952.30
-026
3.35 A.
-029
5.00 A.
1879.4
APPROVED
DATE 3-13-79
PAGE 12-11
BY Carolyn F
VOID AFTER 12507
205.54
207.98
250.82
229
894.85 RD.
(60)
100
110
100
700
1374.67
300
112
108
374.28
-009
1.29 A.
373.46
-015
1.29 A.
2.06 A.
5.00 A.
-004
.75 A.
-005
.25 A.
-007
.00 A.
-008
.50 A.
1.44 A.