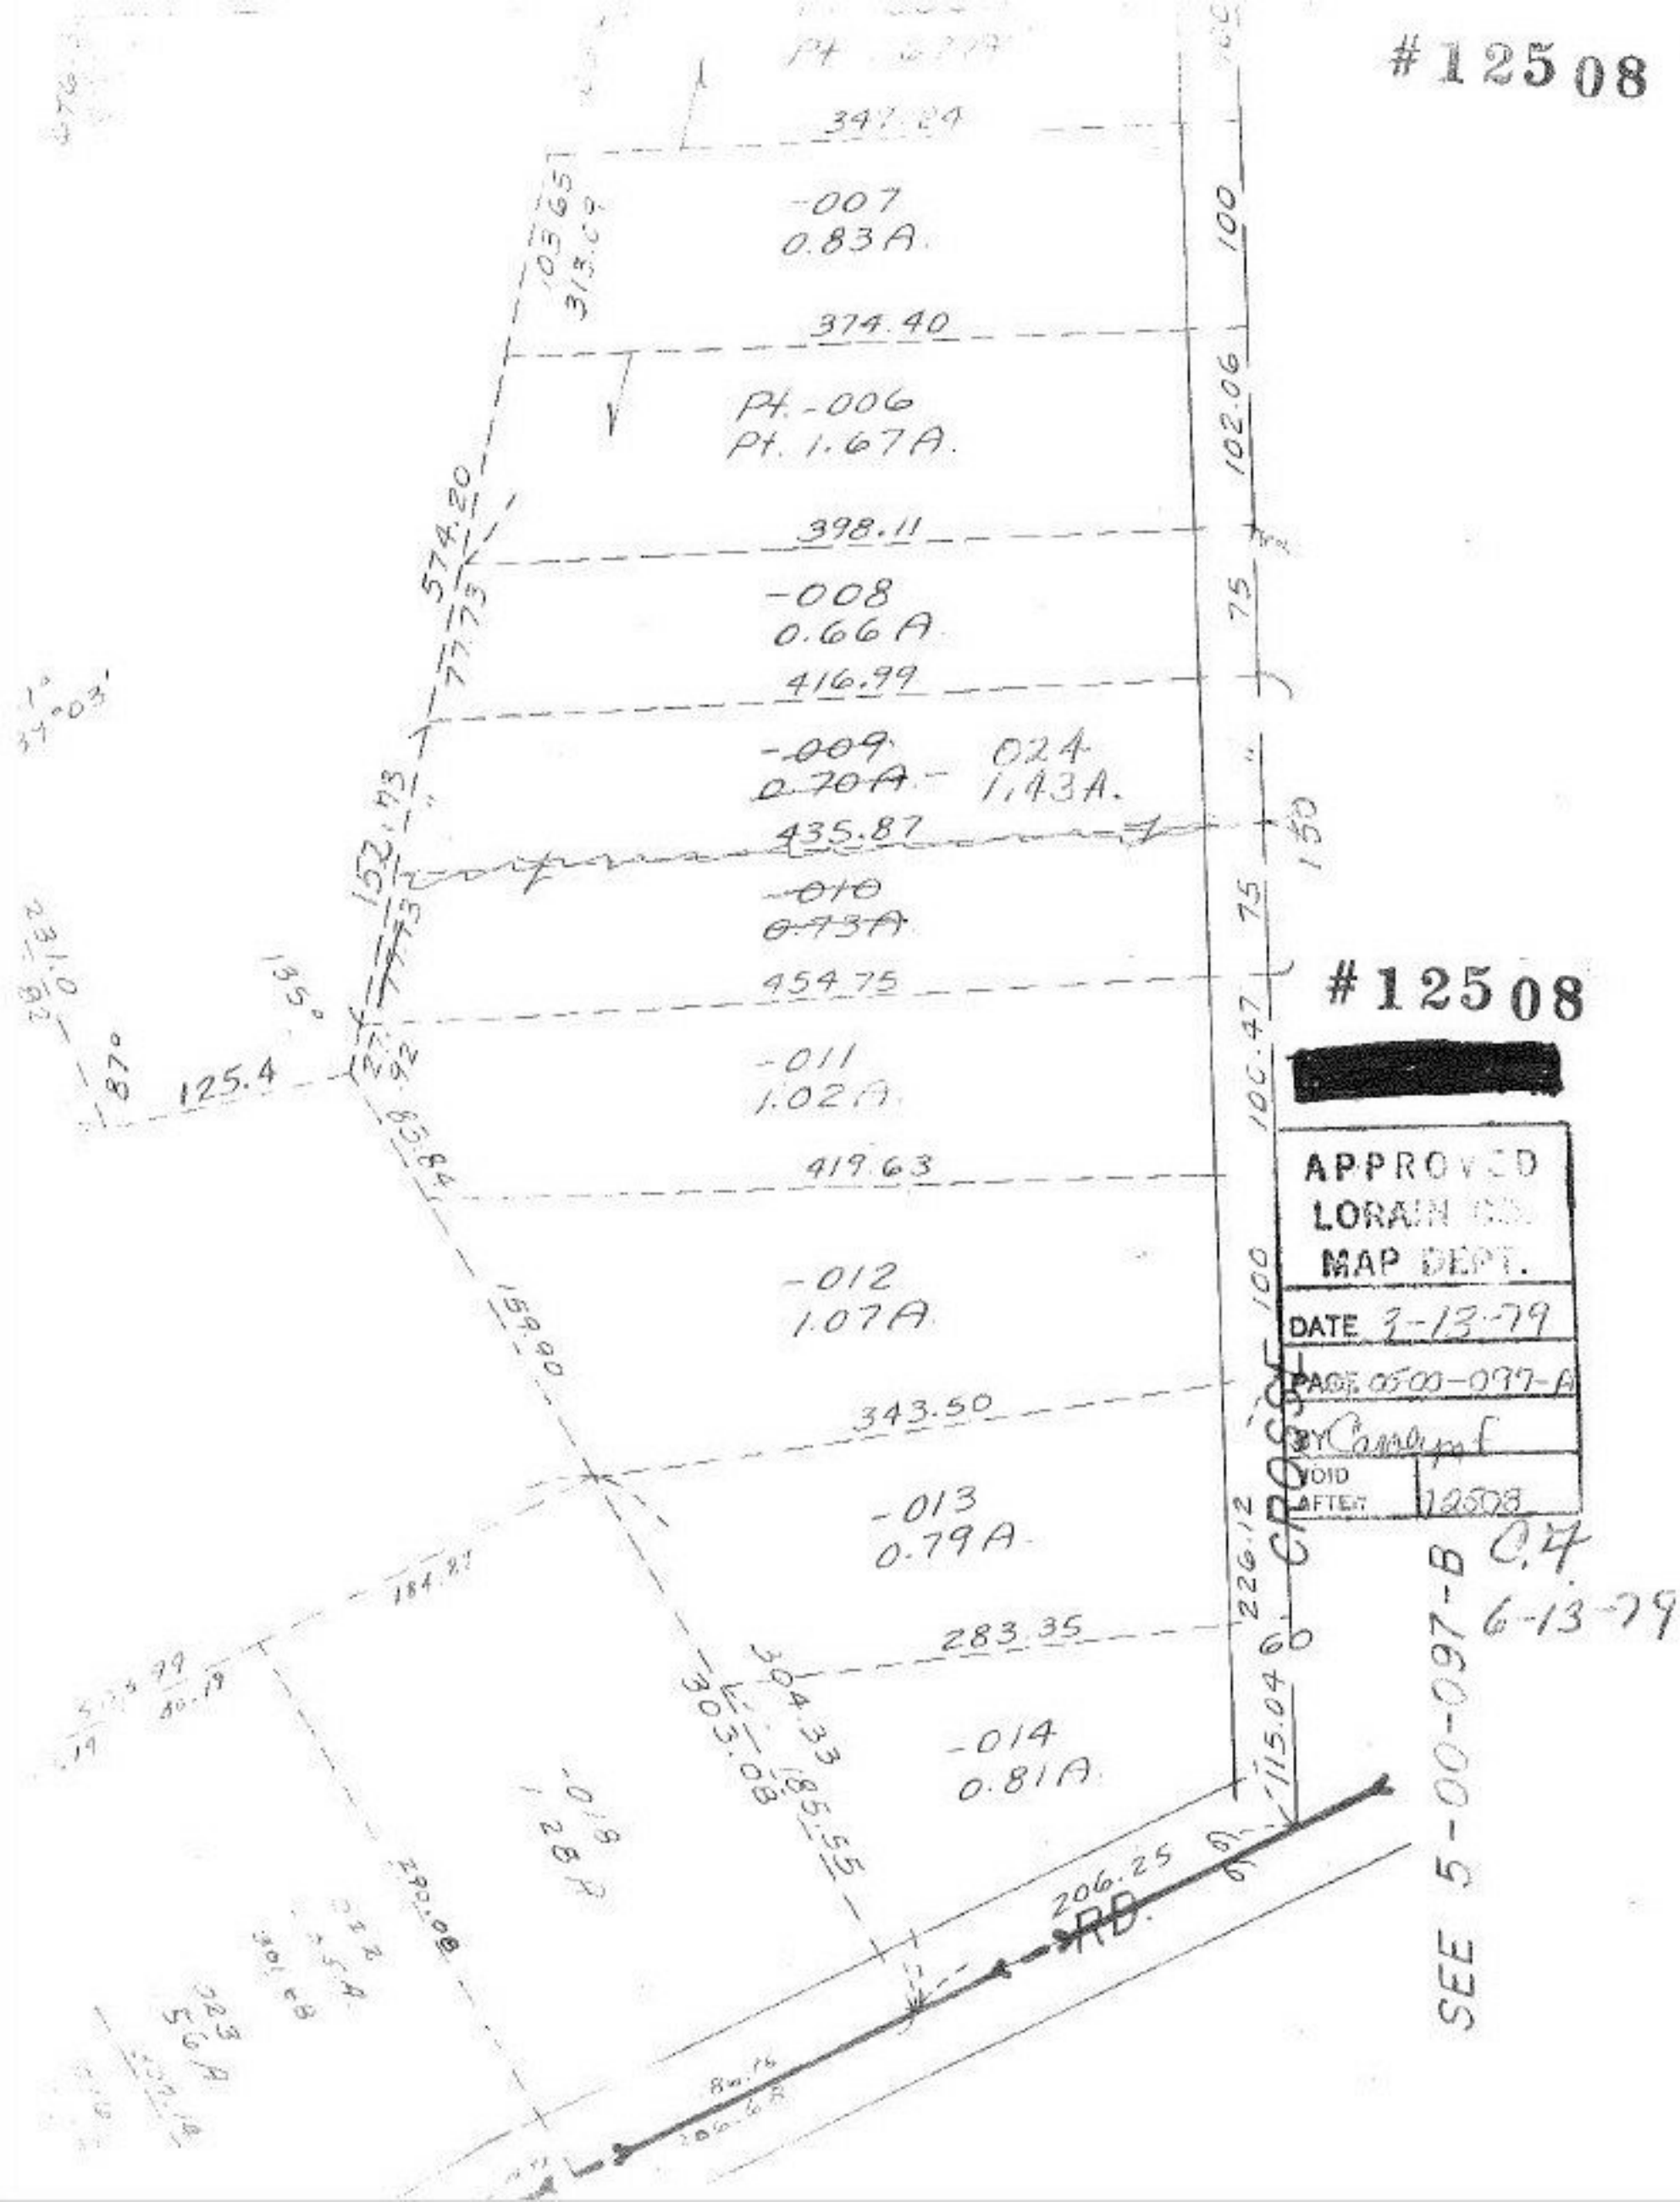
#12508
347.24
-007
0.83A.
374.40
Pt.-006
Pt. 1.67A.
398.11
-008
0.66A
416.99
-009
0.70A
024
1.43A.
435.87
-010
0.73A
454.75
-011
1.02A
419.63
-012
1.07A
343.50
-013
0.79A
283.35
-014
0.81A
100
102.06
75
150
75
100.47
100
226.12
60
115.04
CROSSE
RD.
206.25
SEE 5-00-097-B
#12508
[redacted]
APPROVED
LORAIN CO.
MAP DEPT.
DATE 3-13-79
PAGE 0500-097-A
BY
VOID
AFTER 12508
C.4
6-13-79