#12517

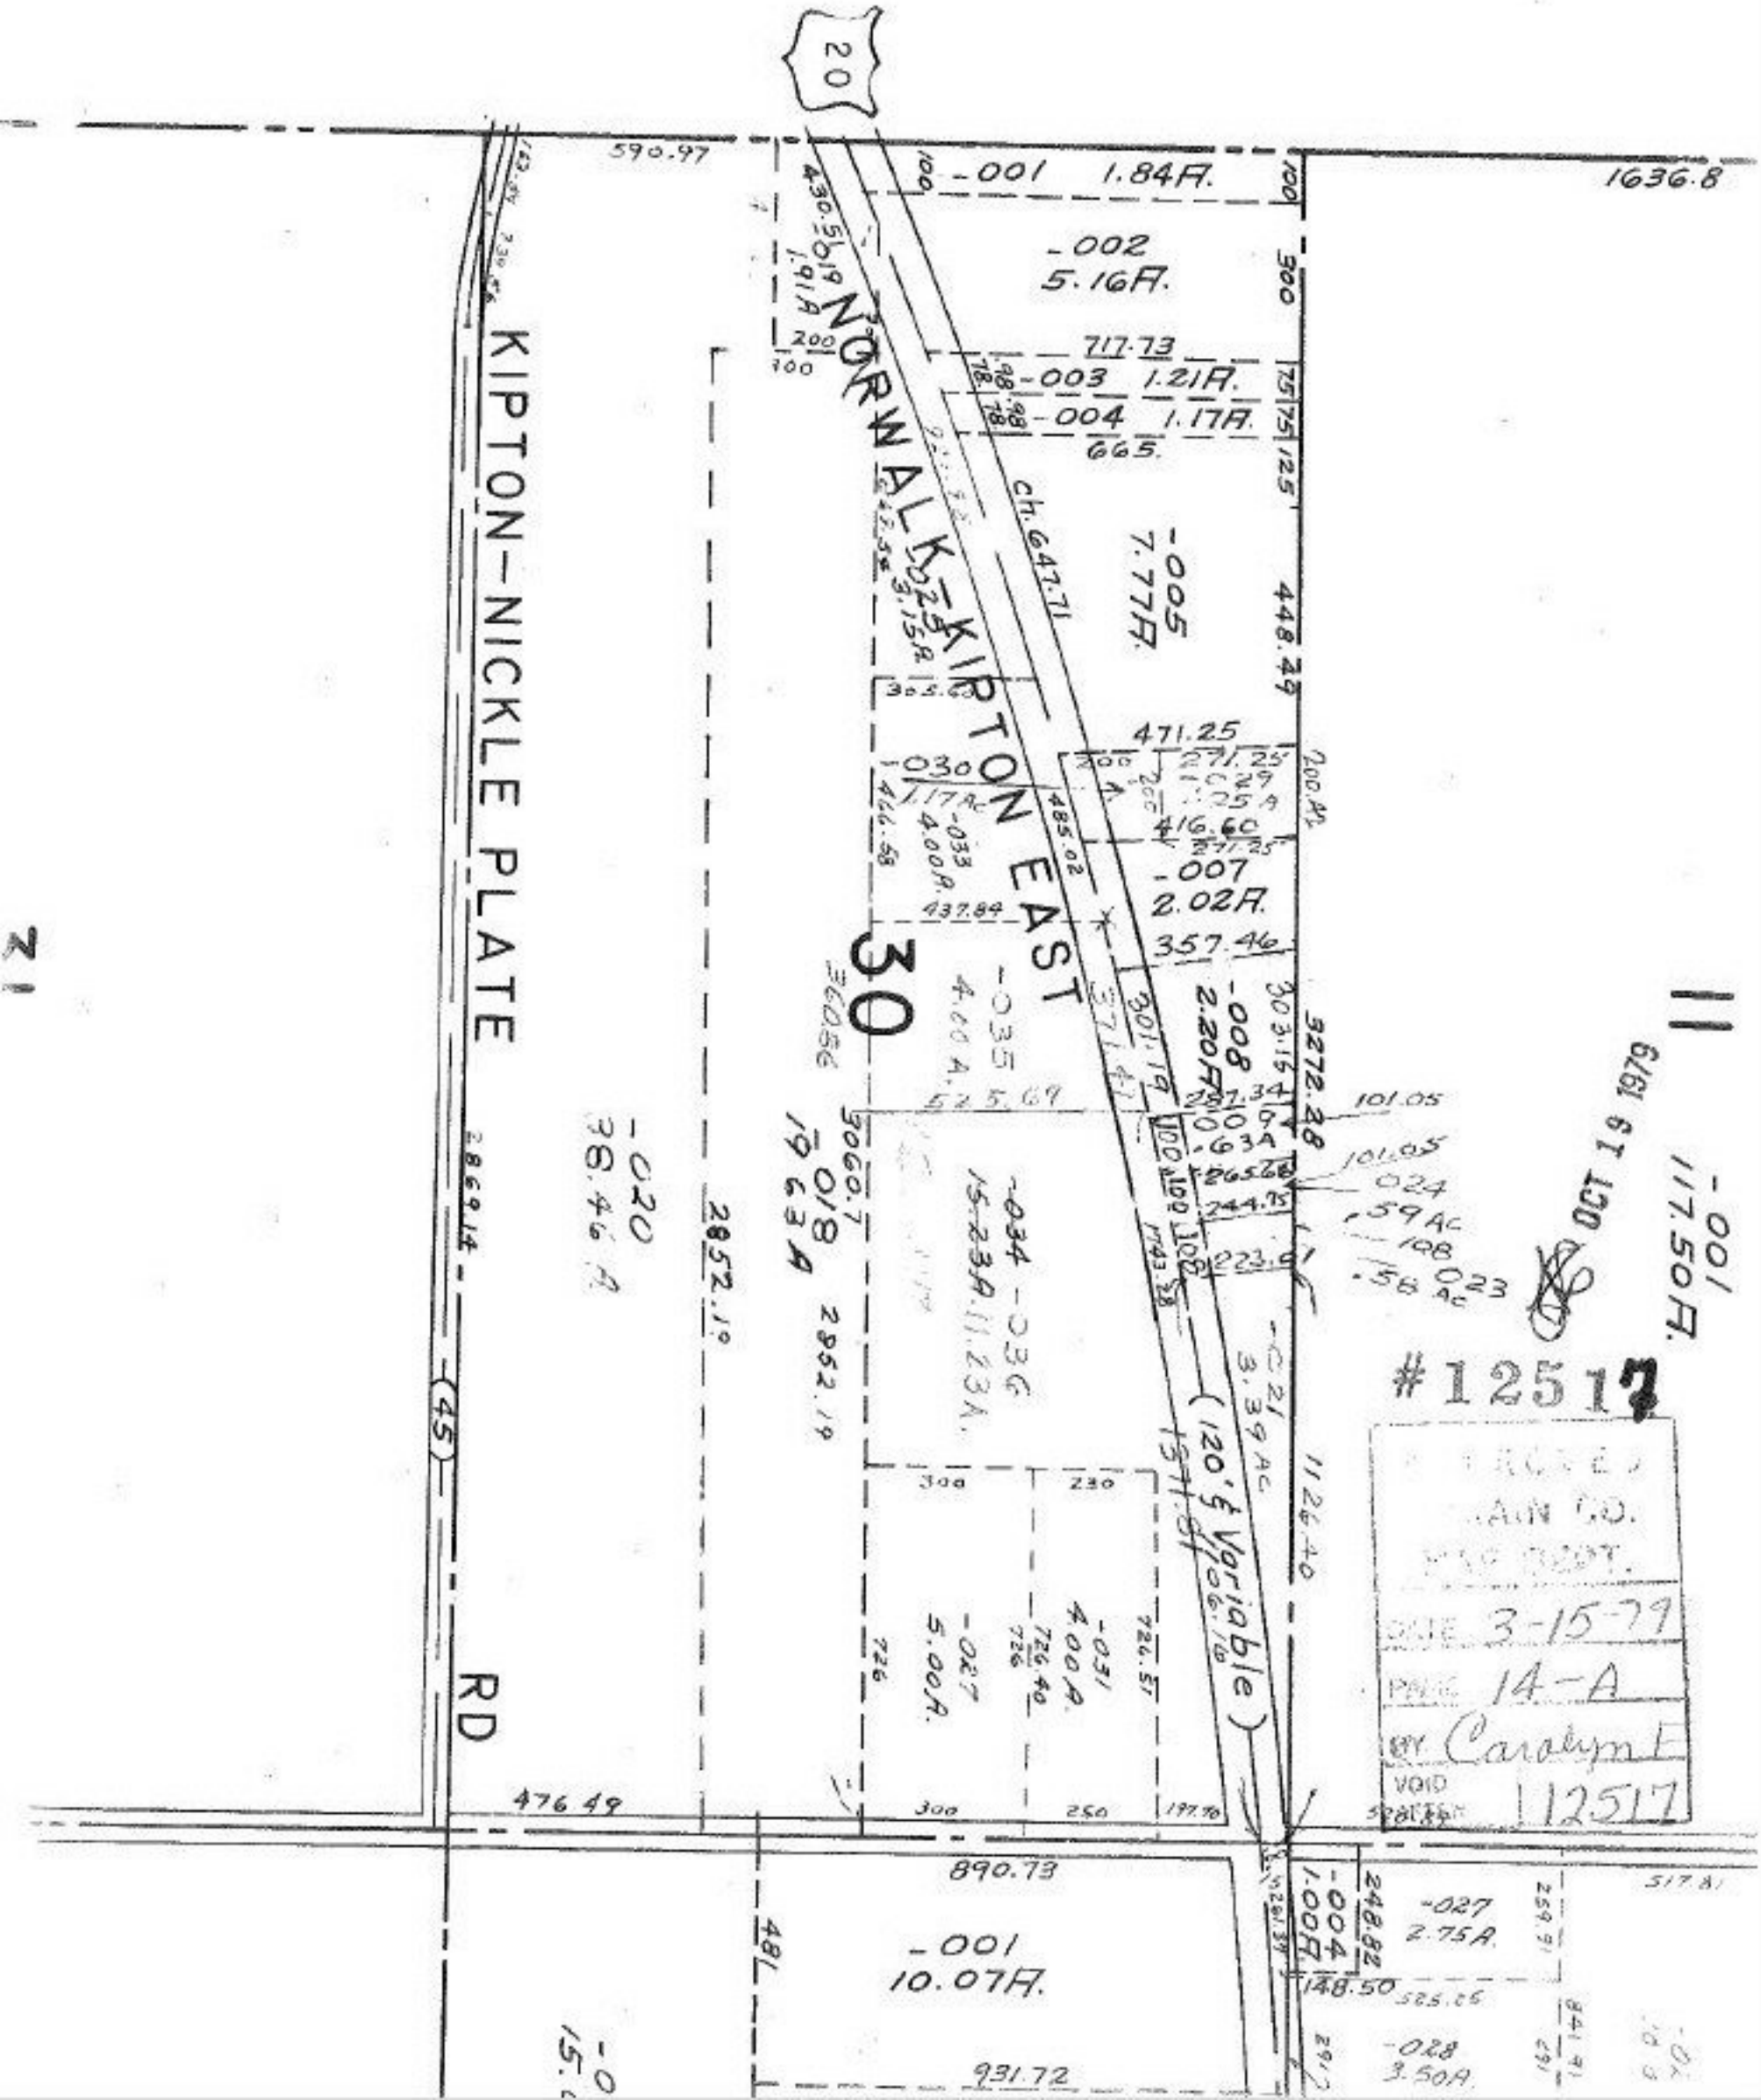

20
590.97
1636.8
-001 1.84A.
-002 5.16A.
717.73
-003 1.21A.
-004 1.17A.
665.
-005 7.77A.
448.49
471.25
-030 1.17Ac
-033 4.00A.
416.60
-007 2.02A.
357.46
-008 2.20A.
-035 4.00A.
525.69
-034 15.23A.
-036 11.23A.
-020 38.46A.
2852.19
3060.7
-018 19.63A
-021 3.39Ac
-001 117.50A.
KIPTON-NICKLE PLATE RD
NORWALK-KIPTON EAST
30
(120' ℄ Variable)
11
OCT 19 1979
#12517
DATE 3-15-79
PAGE 14-A
BY Carolyn F
VOID 12517
476.49
890.73
-001 10.07A.
931.72
-004 1.00A.
-027 2.75A.
-028 3.50A.