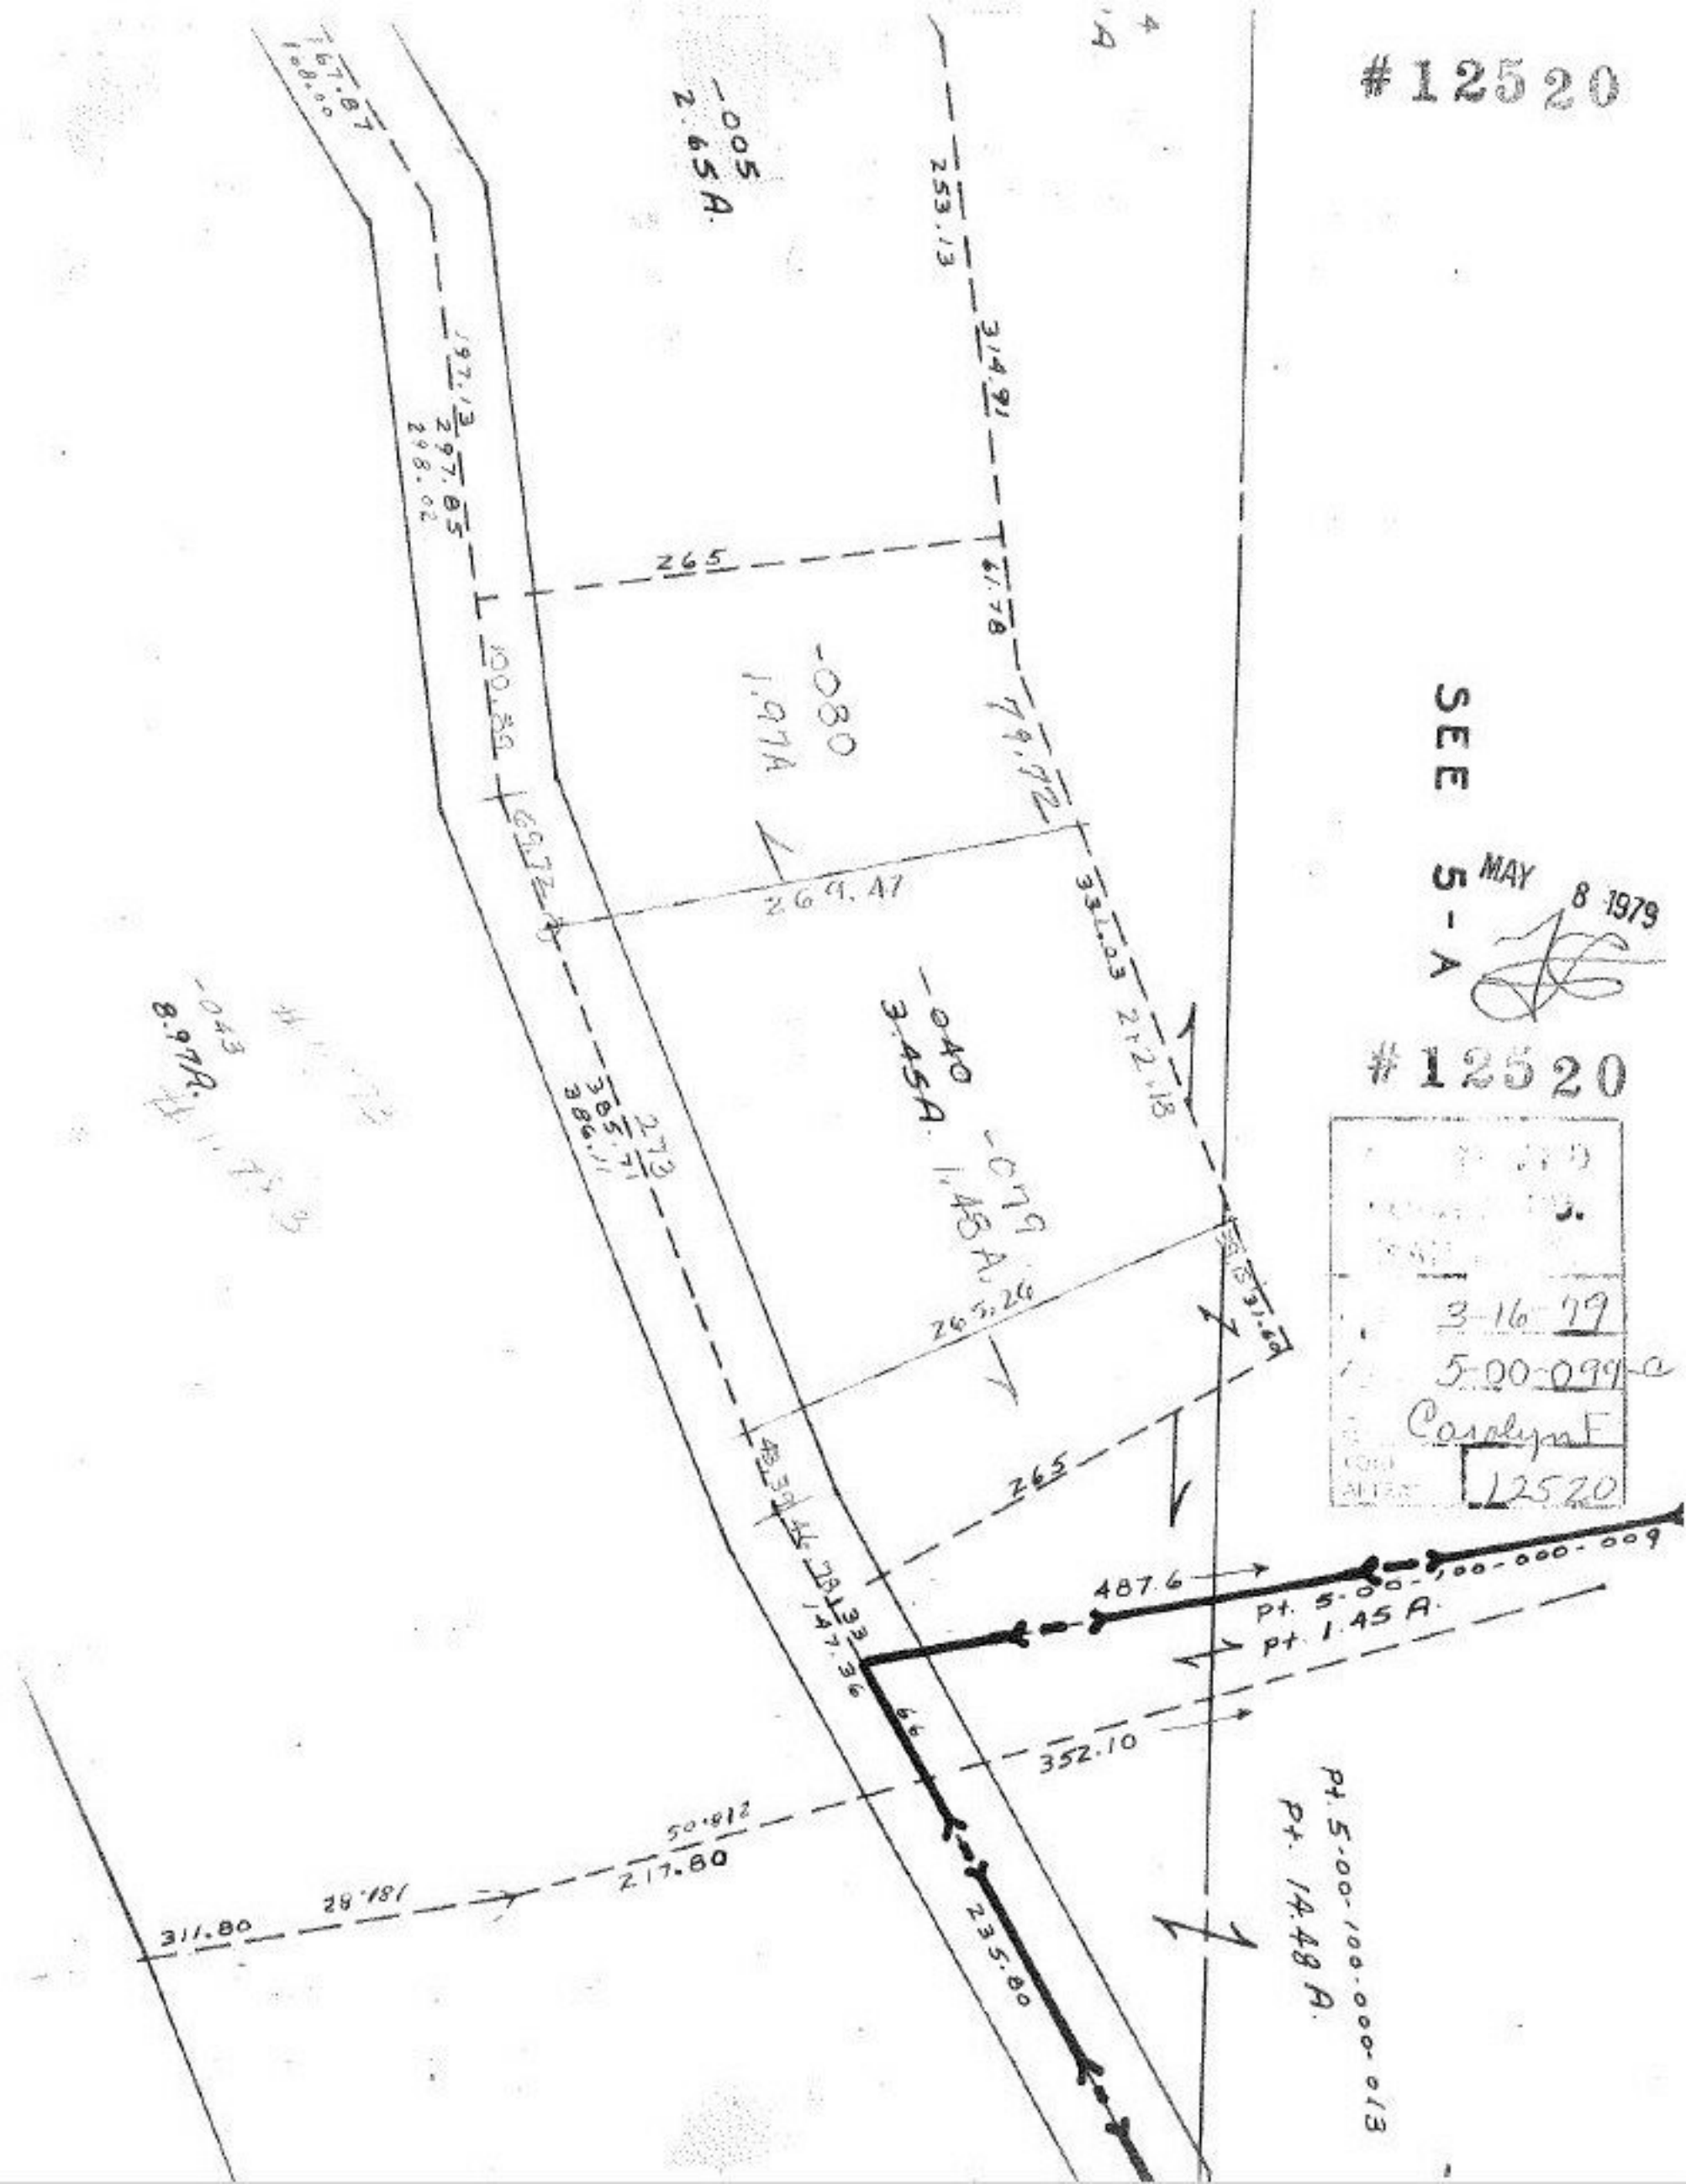

#12520
SEE 5-A
MAY 8 1979
#12520
3-16-79
5-00-099-a
Carolyn F
12520
-005
2.65A.
253.13
314.91
265
61.78
79.72
-080
1.97A
269.47
331.03
212.18
-040
3.45A.
-079
1.48A.
265.26
265
487.6
Pt. 5-00-100-000-009
Pt. 1.45 A.
352.10
Pt. 5-00-100-000-013
Pt. 14.48 A.
235.80
217.80
311.80
-043
8.97A.