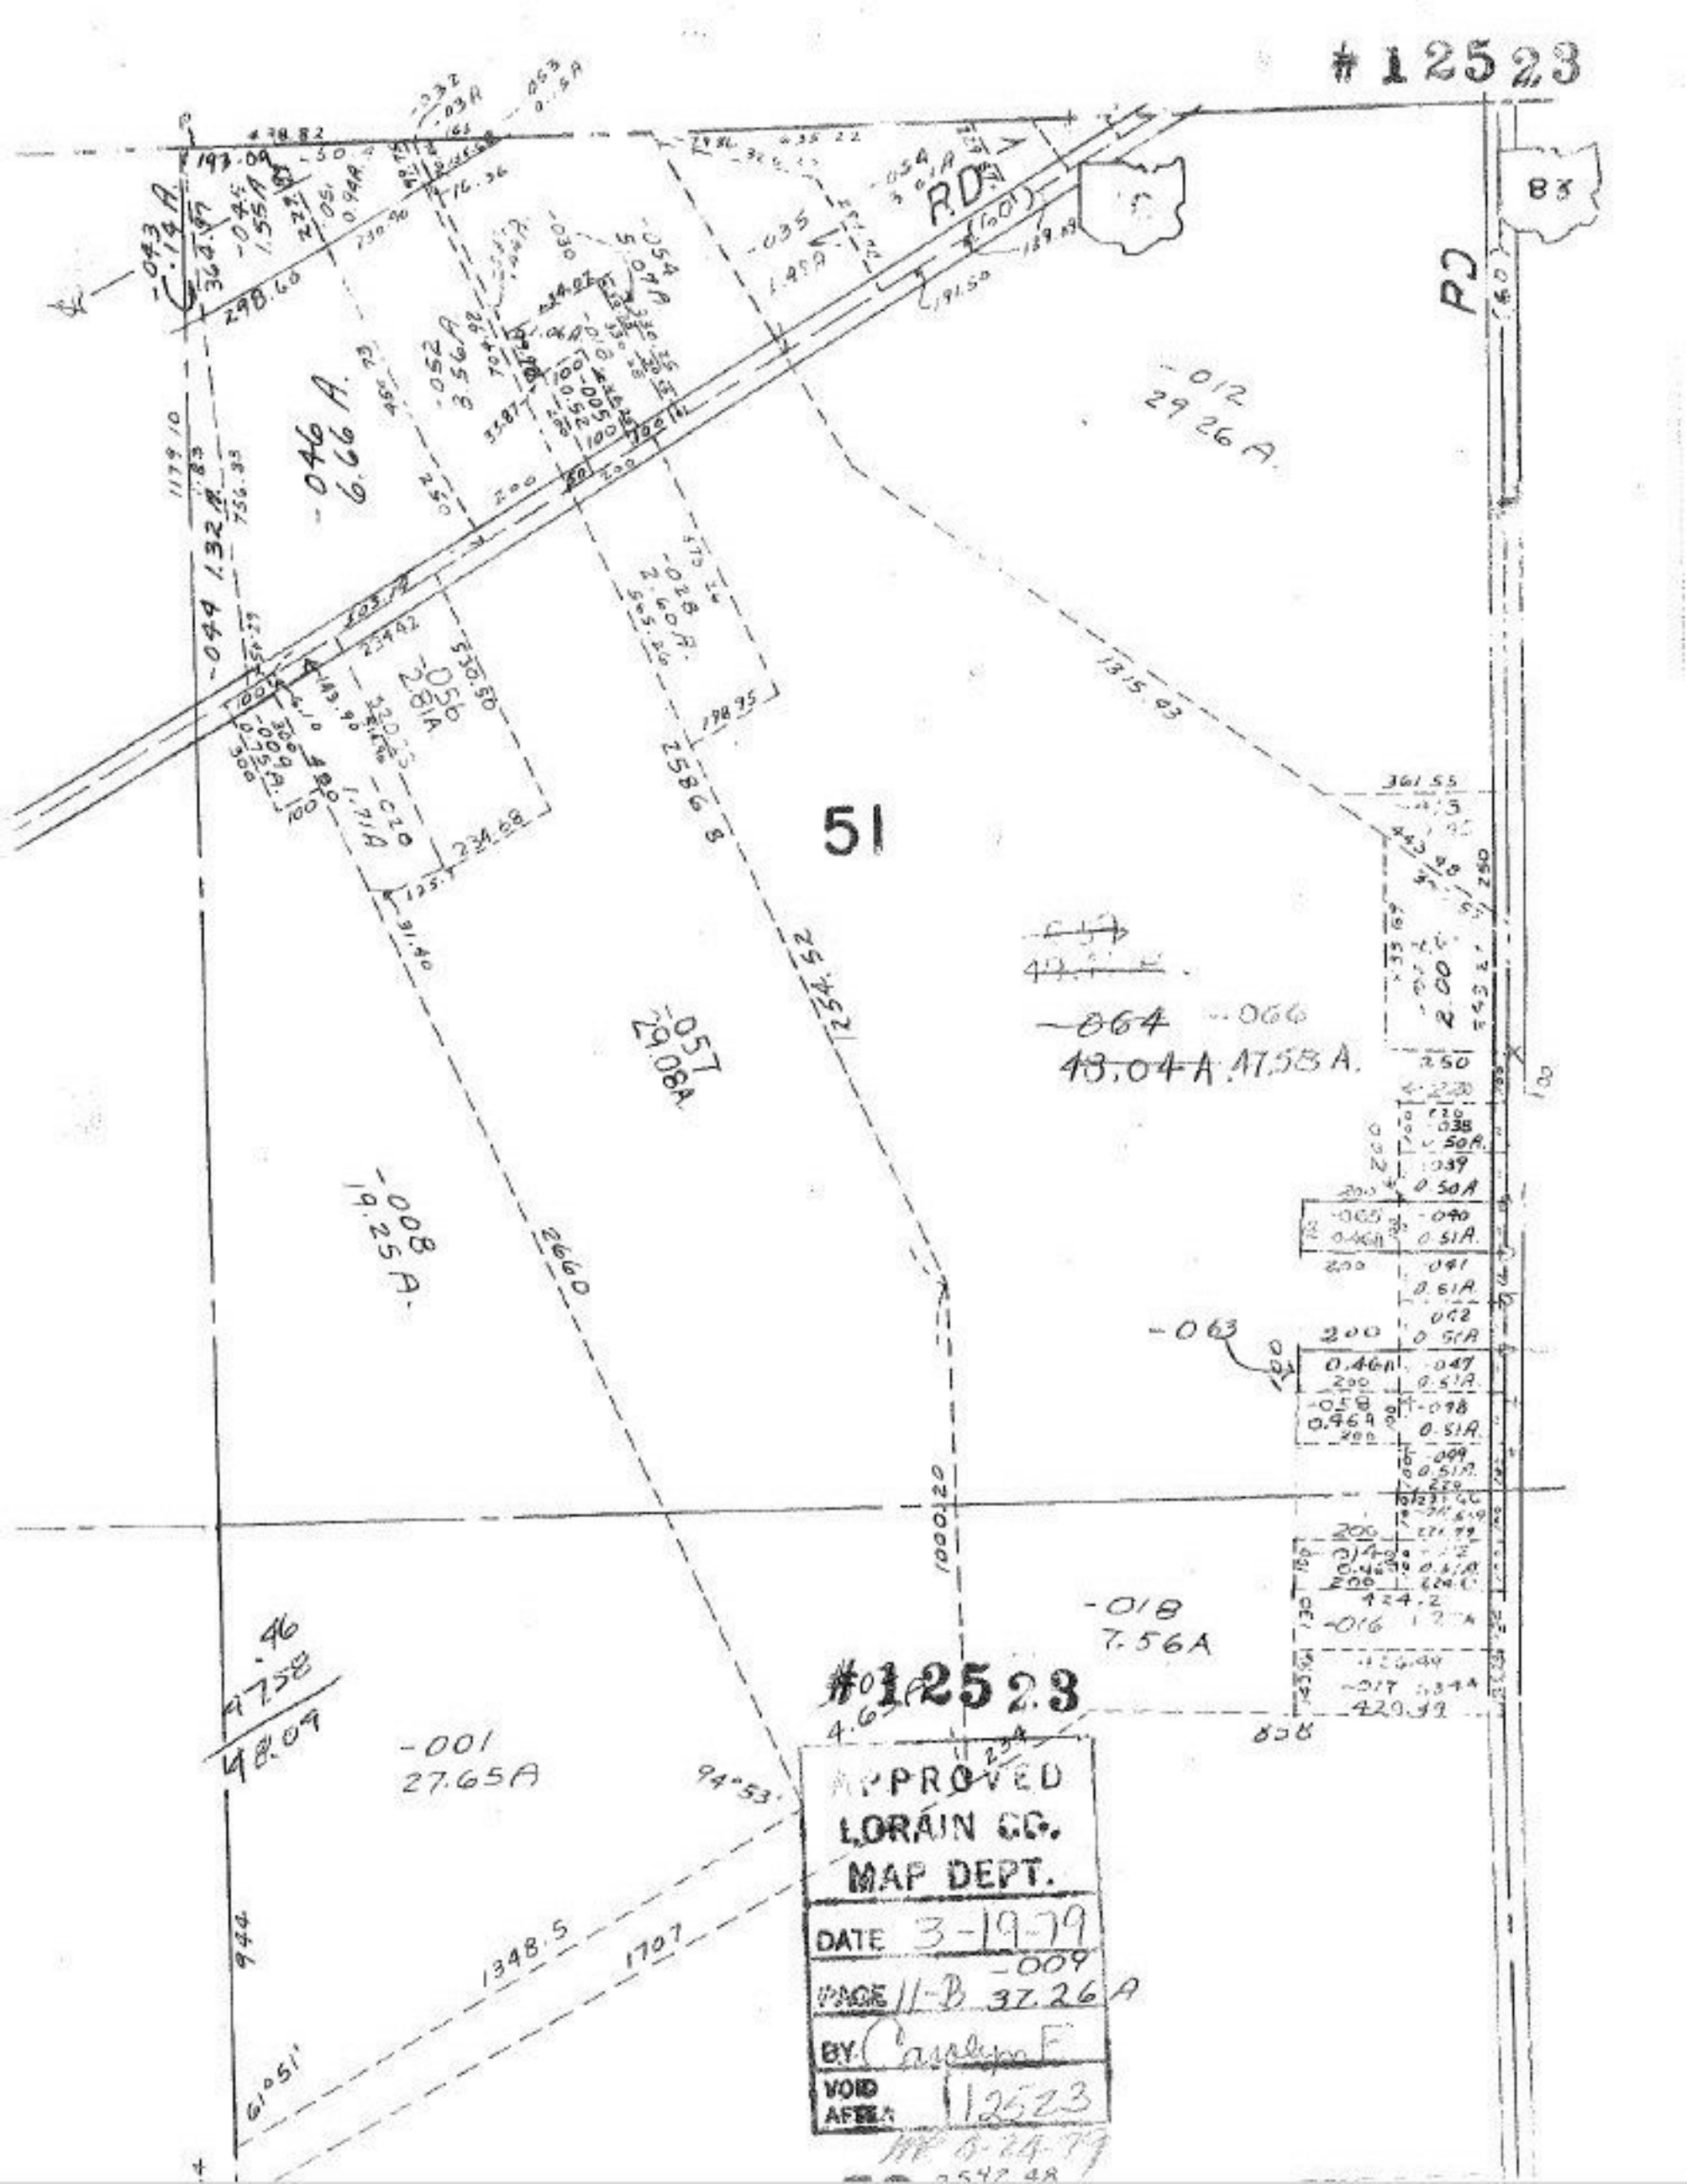
#12523
RD
RD
83
51
-012
29.26 A.
-046
6.66 A.
-044 1.32 A.
-056
2.81A
-057
29.08A
-008
19.25 A.
-064
-066
48.04 A
47.58 A.
-063
-018
7.56A
-001
27.65A
#12523
APPROVED
LORAIN CO.
MAP DEPT.
DATE 3-19-79
PAGE 11-B
-009
37.26 A
BY Carolyn F
VOID AFTER 12523
6-24-79