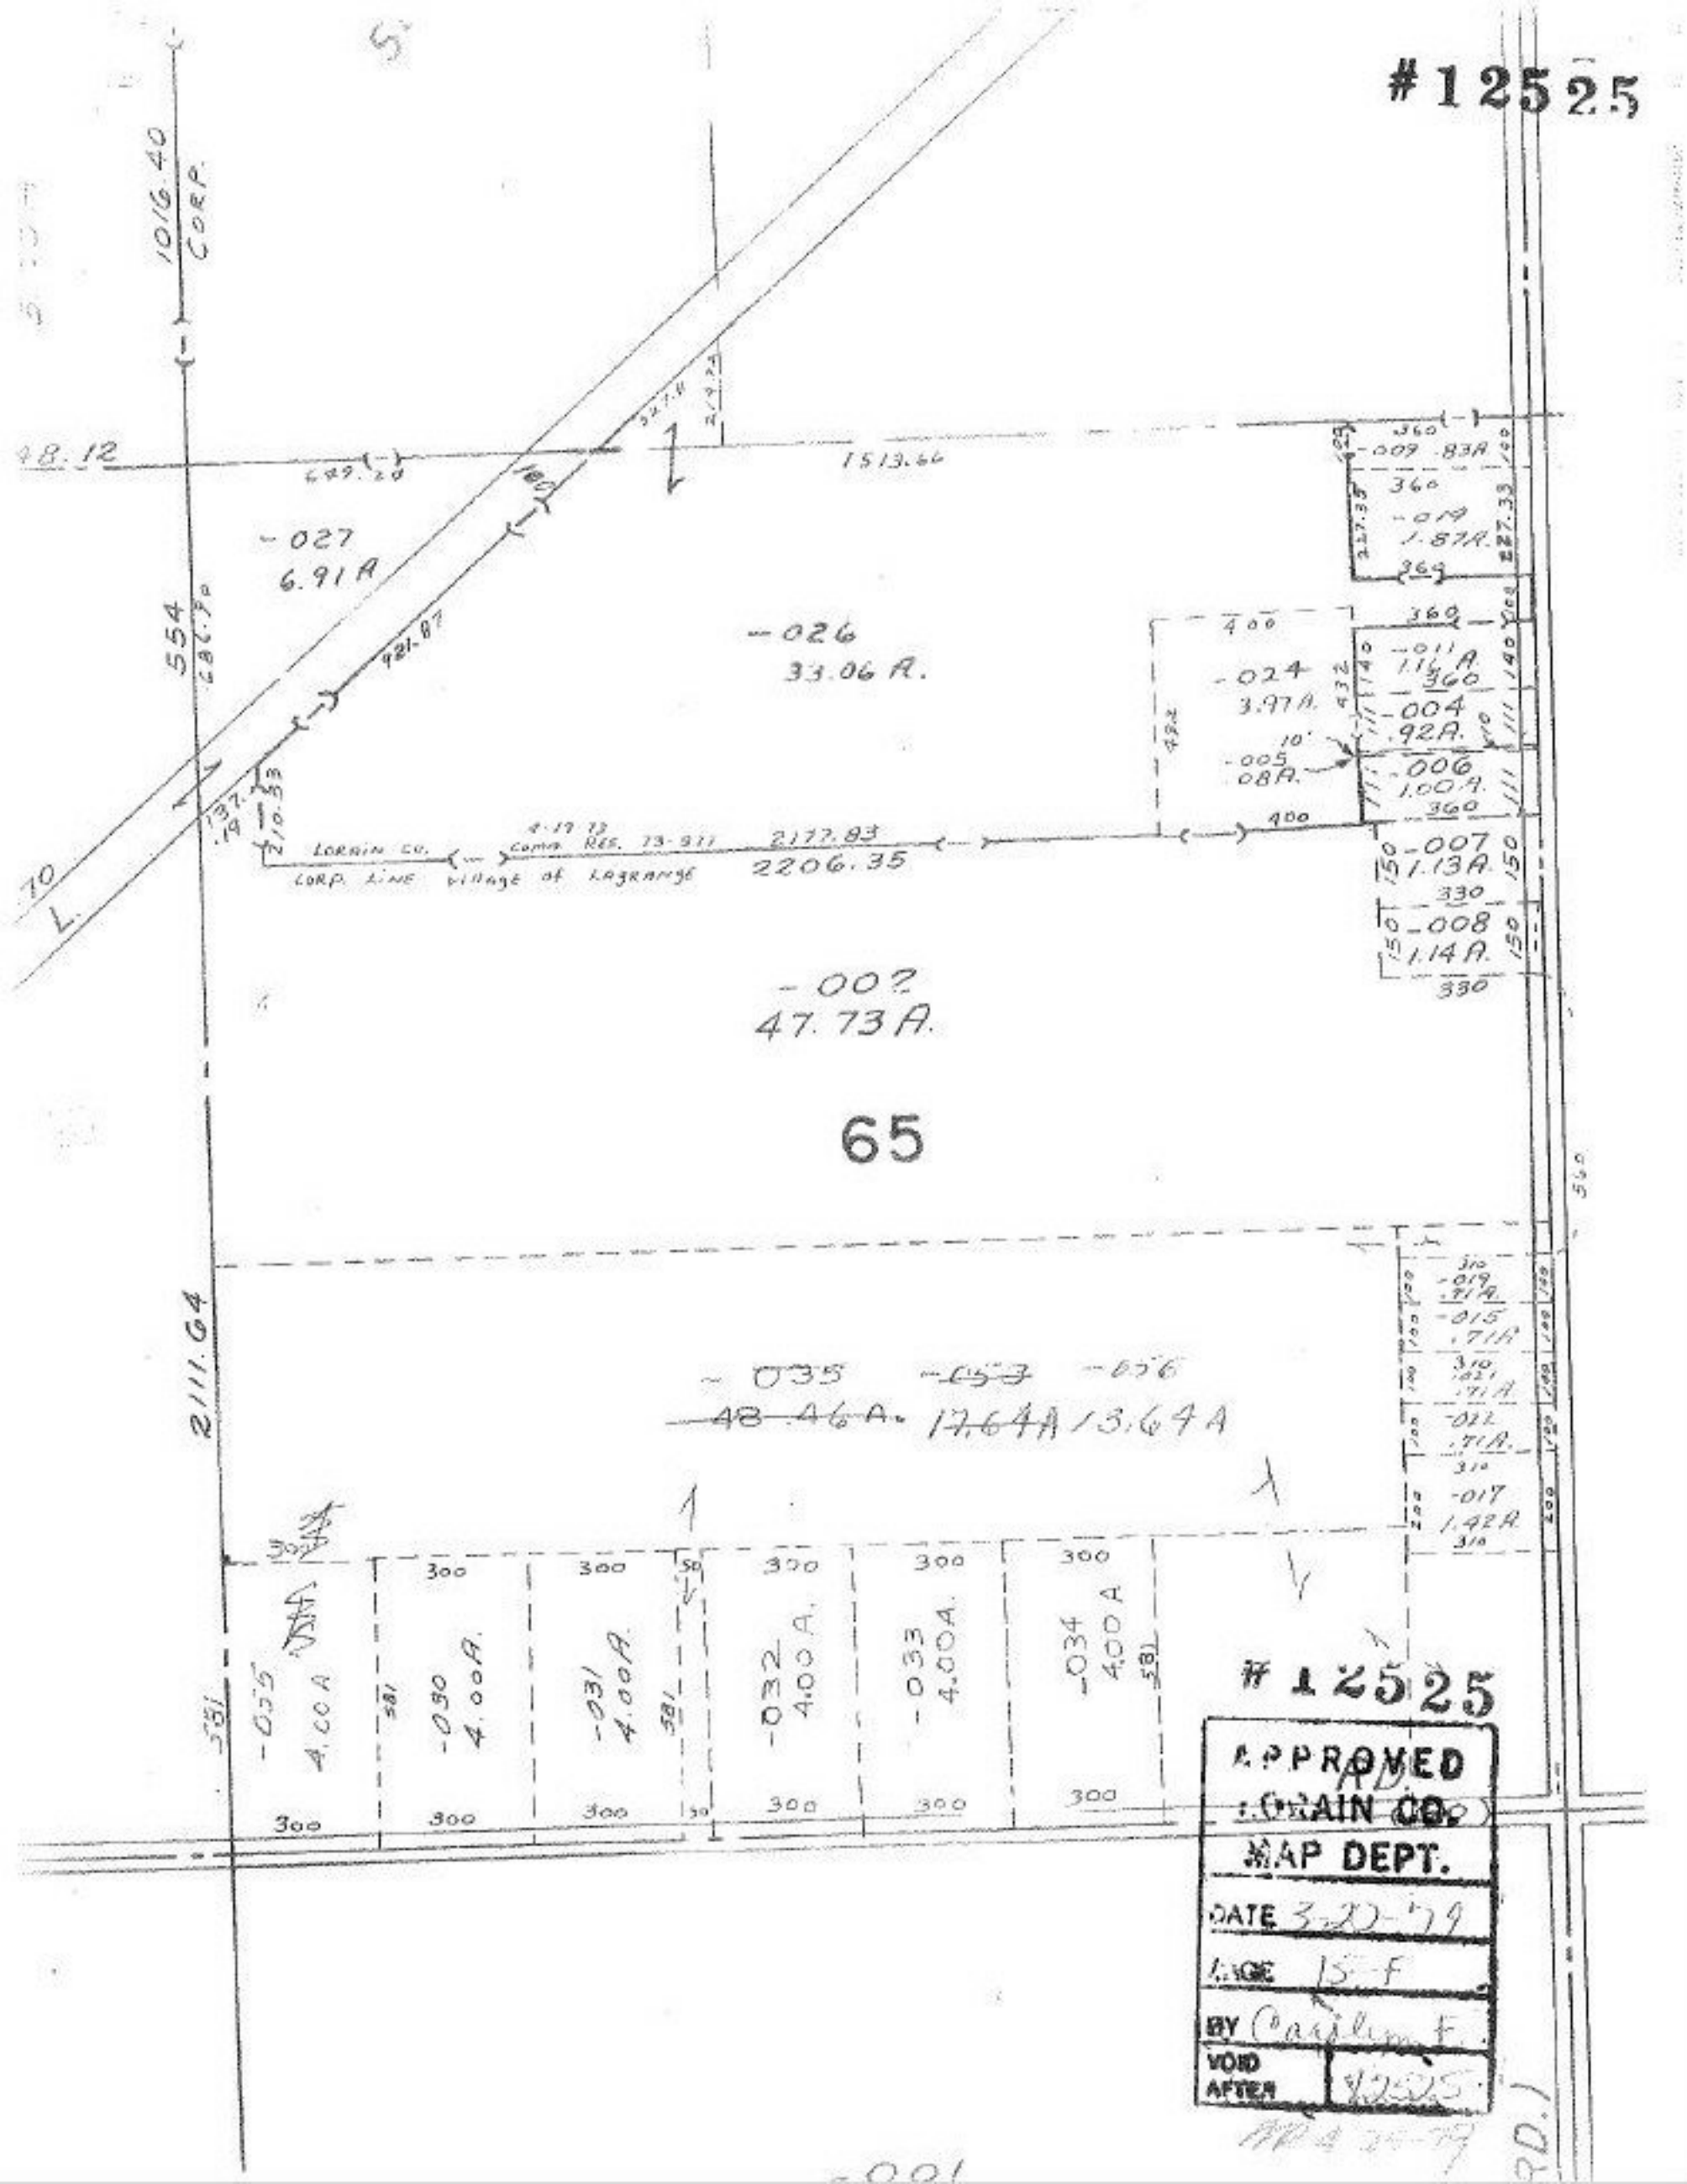
#12525
1016.40
CORP.
48.12
1513.66
-027
6.91 A
-026
33.06 A.
554
-024
3.97 A.
-005
.08 A.
-004
.92 A.
-006
1.00 A.
-007
1.13 A.
-008
1.14 A.
-009 .83 A.
-019
1.87 A.
-011
1.16 A.
LORAIN CO.
CORP. LINE
Village of LAGRANGE
2177.83
2206.35
-002
47.73 A.
65
2111.64
-035
-053
-056
48.46 A.
17.64 A
13.64 A
-035
4.00 A
-030
4.00 A.
-031
4.00 A.
-032
4.00 A.
-033
4.00 A.
-034
4.00 A
-017
1.42 A.
-019
.71 A.
-015
.71 A
-022
.71 A.
#12525
APPROVED
LORAIN CO.
MAP DEPT.
DATE 3-20-79
PAGE 15-F
BY Carolyn F.
VOID AFTER 12525