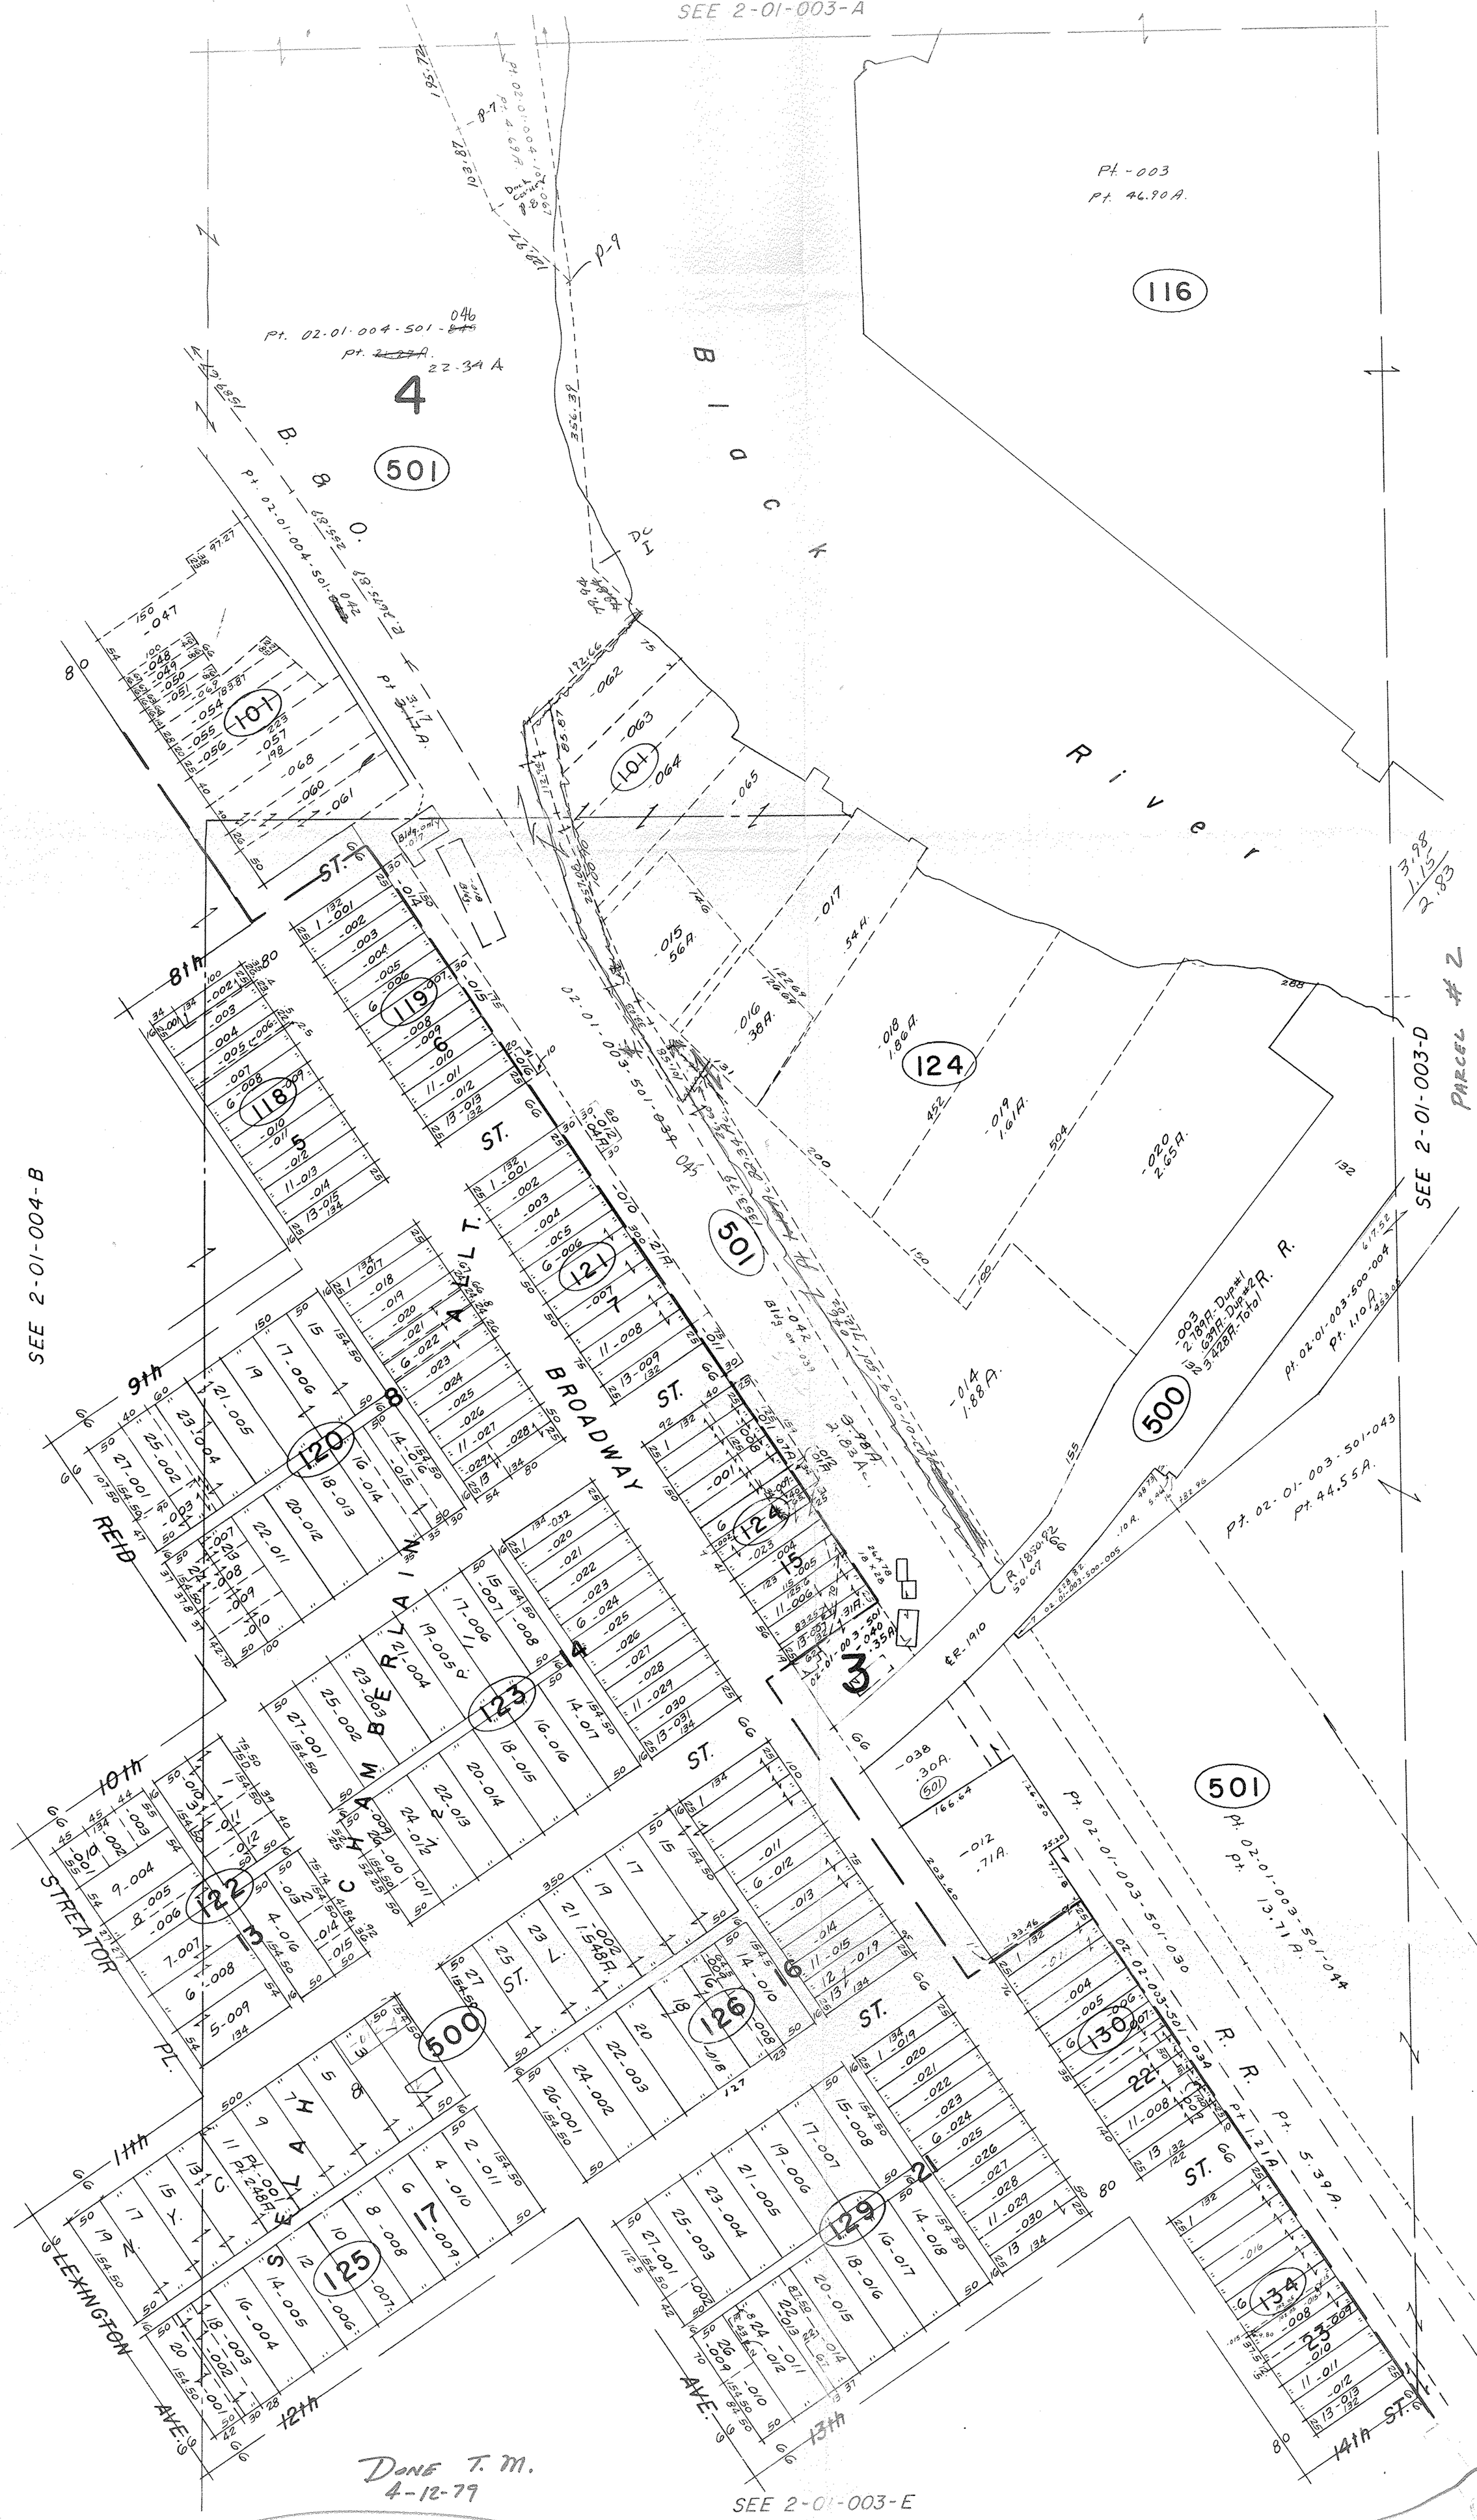
SEE 2-01-003-A
Black River
116
Pt. -003
Pt. 46.90 A.
501
4
Pt. 02-01-004-501-046
Pt. 22.34 A
B. & O. R.R.
SEE 2-01-004-B
SEE 2-01-003-D
PARCEL #2
BROADWAY
ST.
8th
9th
10th
11th
12th
13th
14th
REID
STREATOR
PL.
LEXINGTON
AVE.
SEE 2-01-003-E
DONE T. M.
4-12-79
#12543
APPROVED
LORAIN CO.
MAP DEPT.
DATE 3-26-79
PAGE 2-01-003-C
BY T. McGain
VOID AFTER