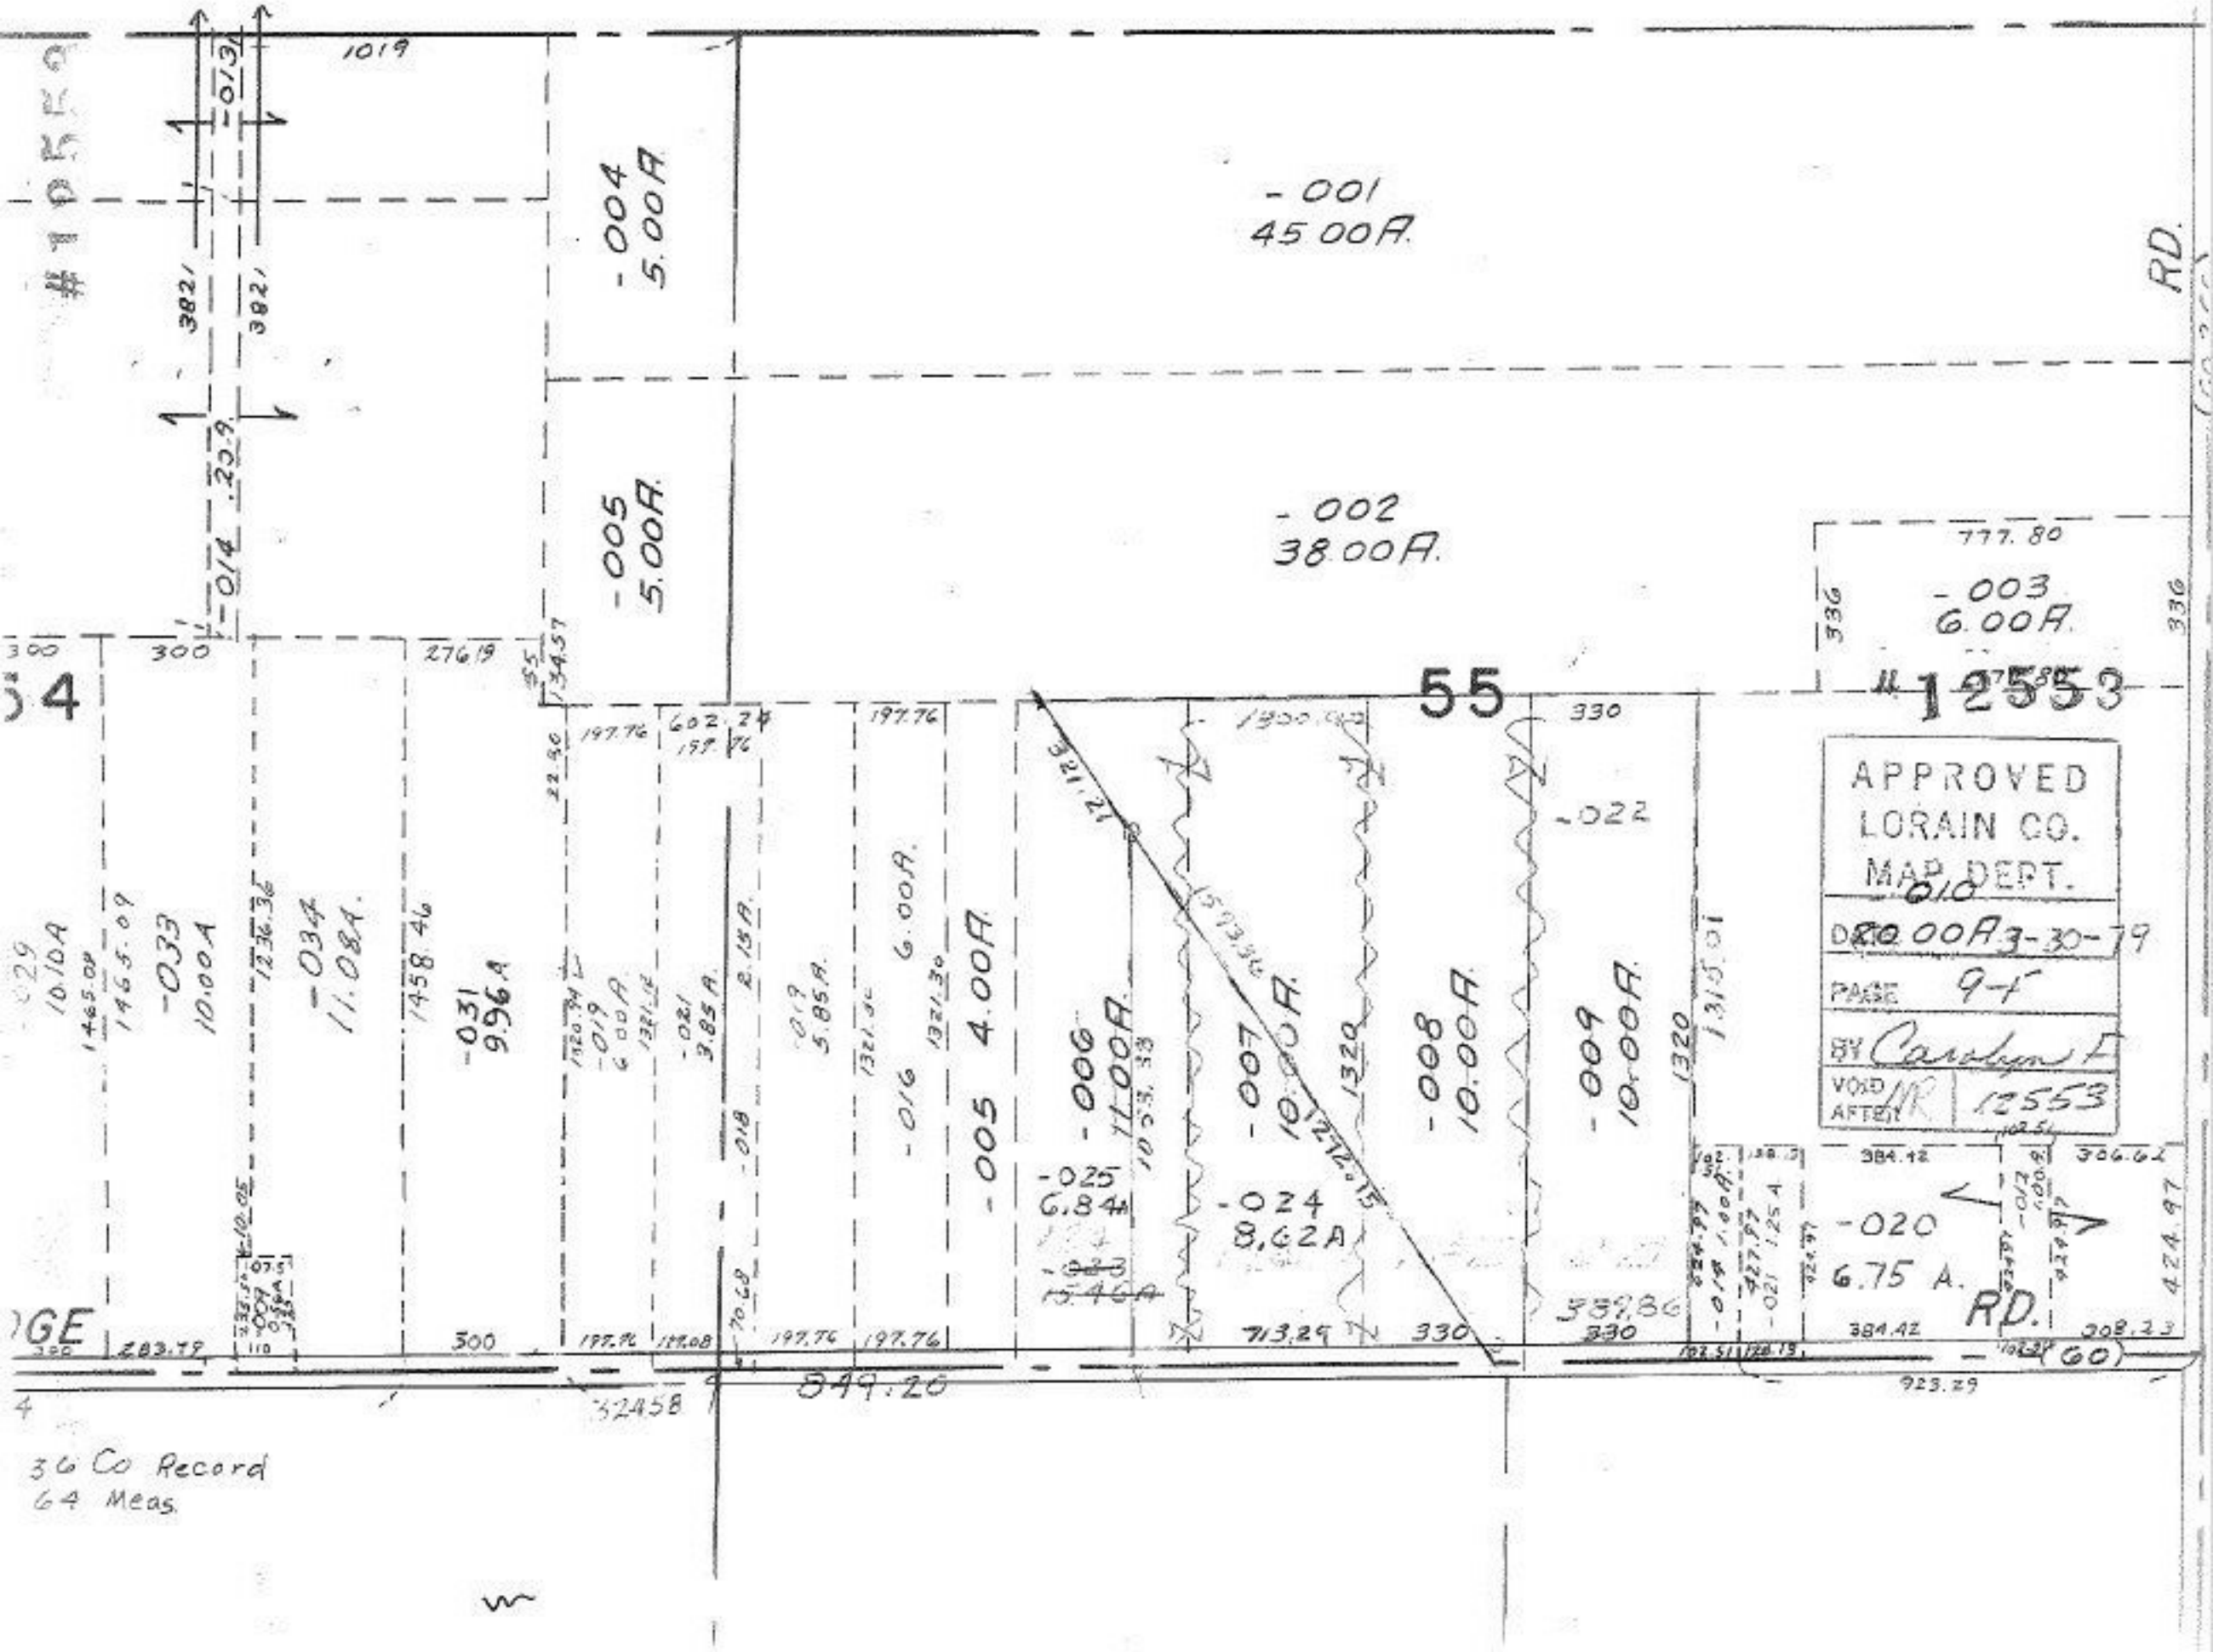

-001
45.00A.
-002
38.00A.
-003
6.00A.
-004
5.00A
-005
5.00A.
-006
11.00A.
-007
10.00A.
-008
10.00A.
-009
10.00A.
-020
6.75 A.
-021
3.85 A.
-022
-024
8.62A
-025
6.84A
-031
9.96A
-033
10.00A
-034
11.08A.
-005 4.00A.
-016
6.00A.
-019
6.00A.
-020
6.75 A.
55
#12553
RD.
RD.
849.20
36 Co Record
64 Meas.
APPROVED
LORAIN CO.
MAP DEPT.
DATE 3-30-79
PAGE 9-F
BY Carolyn F
VOID AFTER 12553