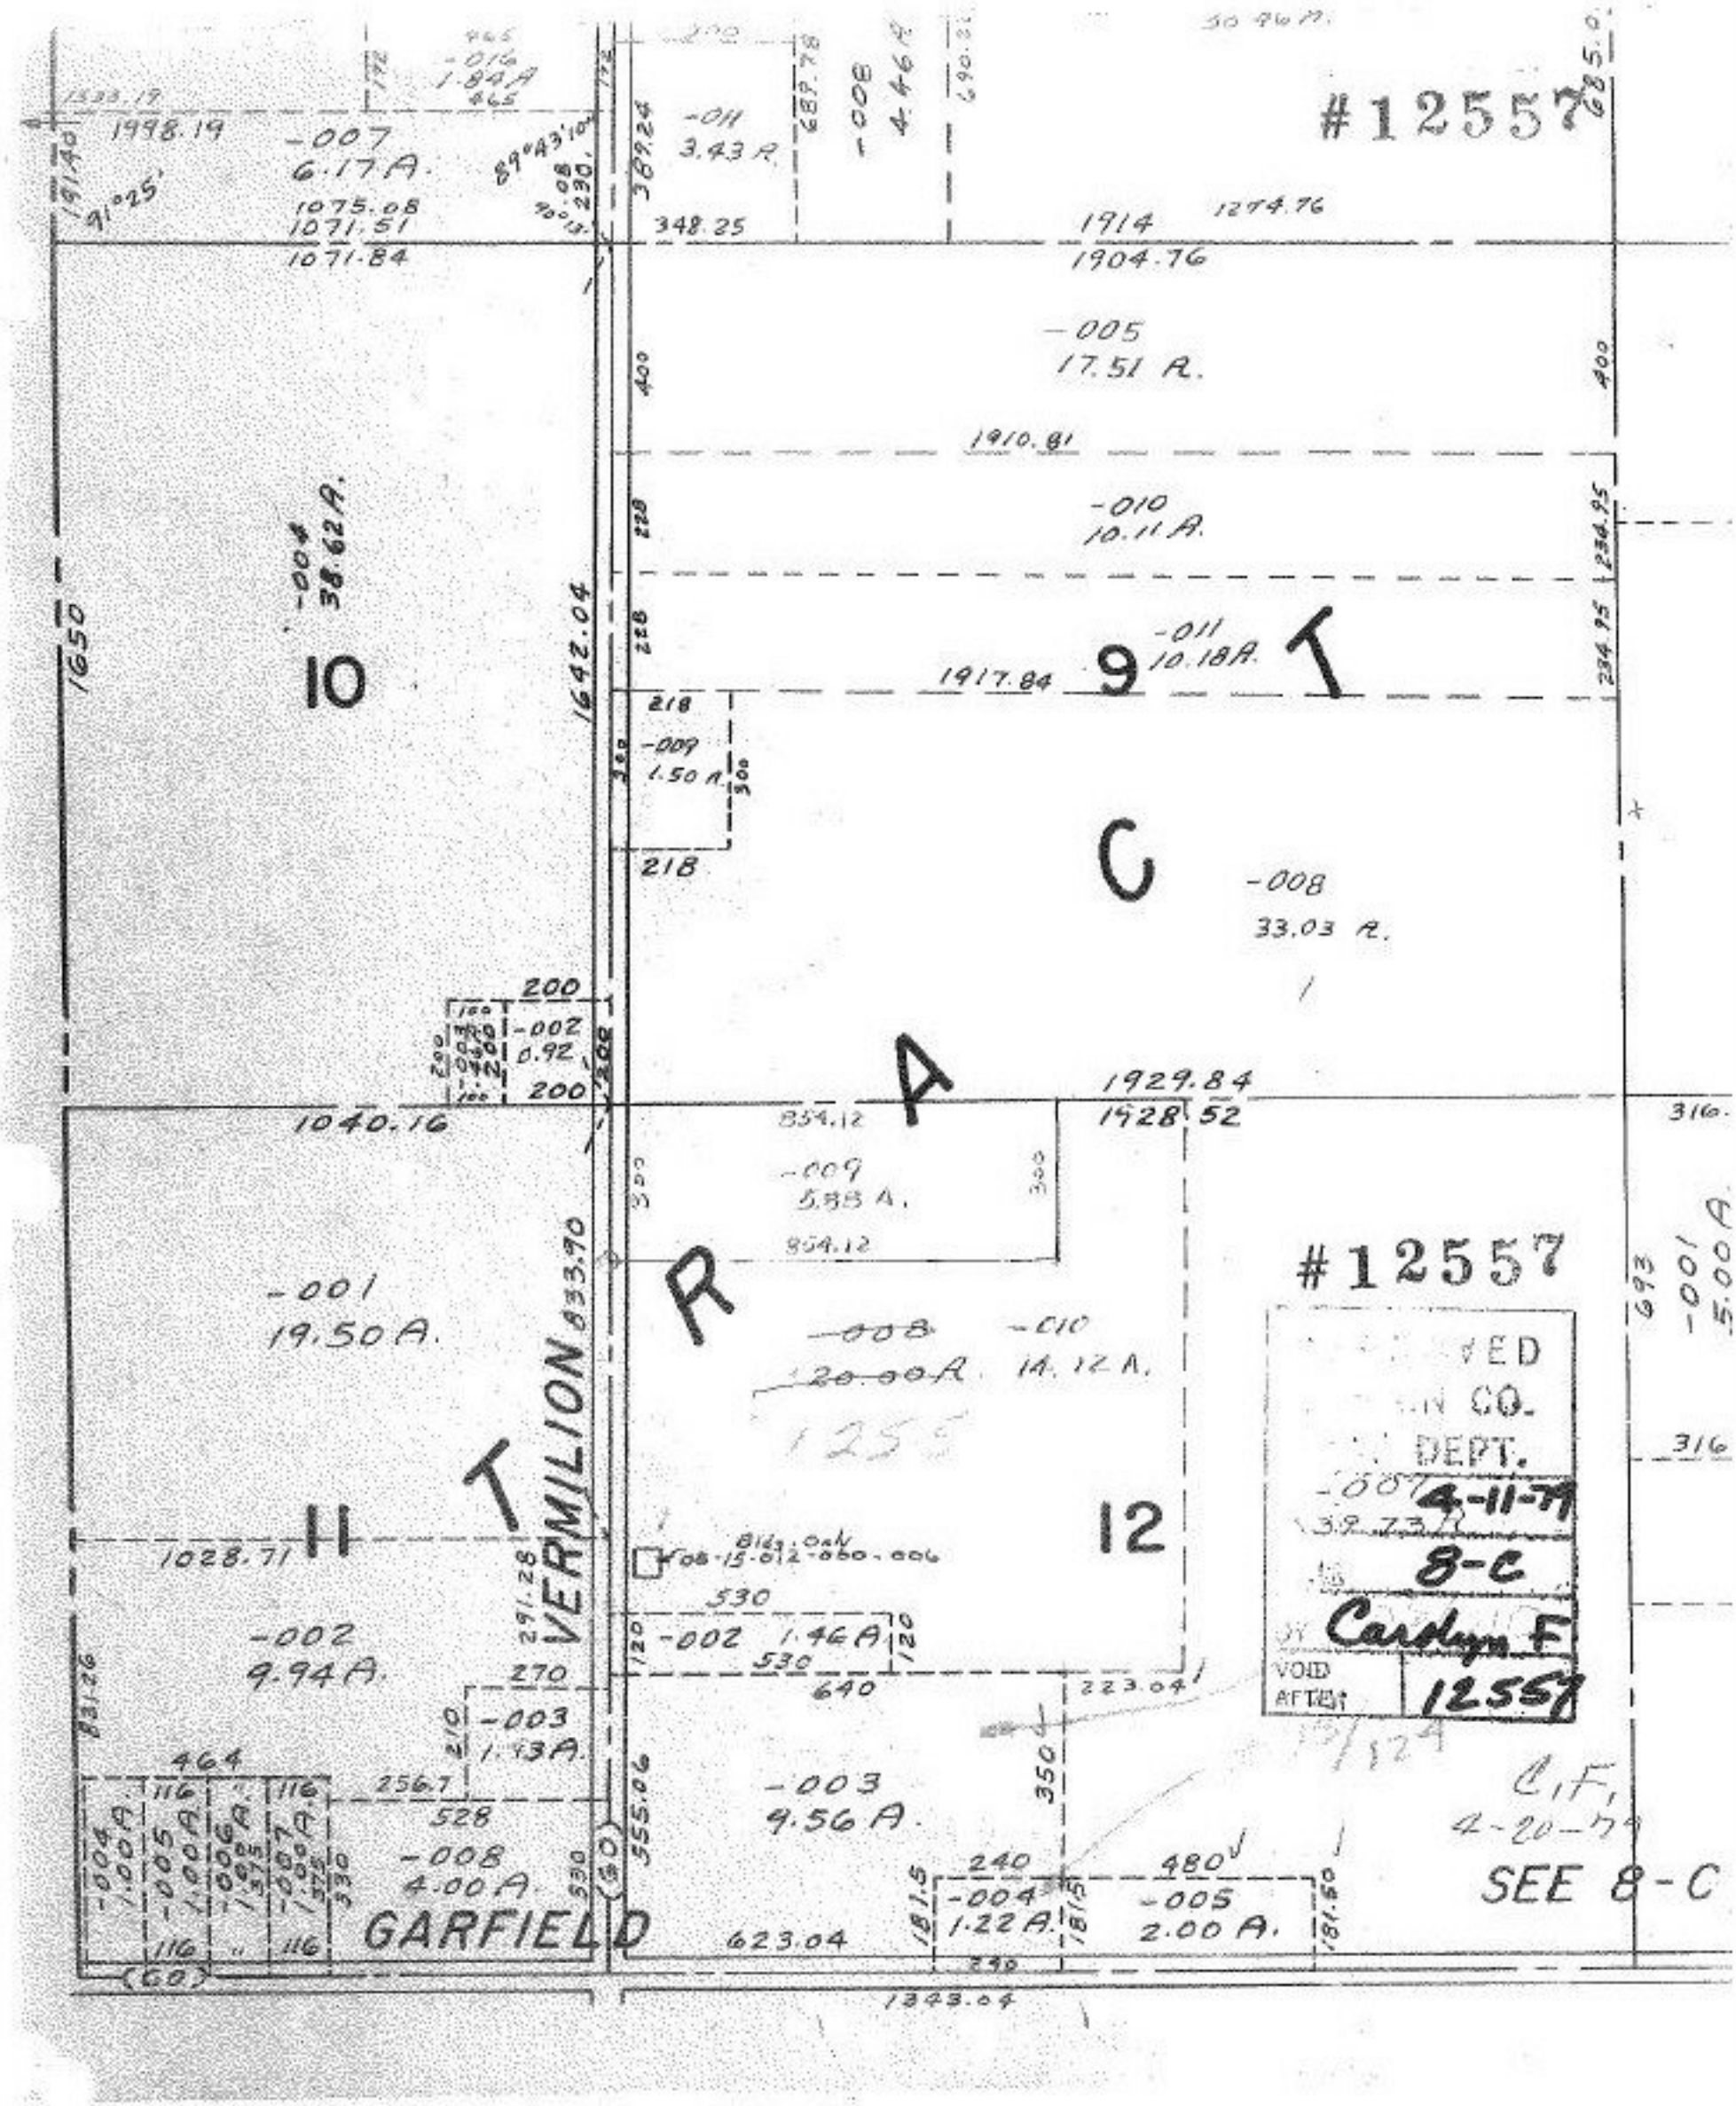
#12557
-007
6.17 A.
1998.19
1075.08
1071.51
1071.84
-011
3.43 A.
-008
4.46 A.
1914
1904.76
1274.76
-005
17.51 A.
1910.81
-010
10.11 A.
-004
38.62 A.
10
1650
1642.04
-011
10.18 A.
9
1917.84
-009
1.50 A.
C
-008
33.03 A.
-002
0.92
A
1929.84
1928.52
1040.16
-009
5.88 A.
854.12
-001
19.50 A.
VERMILION
833.90
R
-008
20.00 A.
-010
14.12 A.
#12557
11
12
1028.71
-002
9.94 A.
-002
1.46 A.
-003
1.43 A.
-003
9.56 A.
-008
4.00 A.
GARFIELD
-004
1.22 A.
-005
2.00 A.
623.04
1343.04
-001
5.00 A.
4-11-79
8-C
Carolyn F
12557
C.F.
4-20-79
SEE 8-C