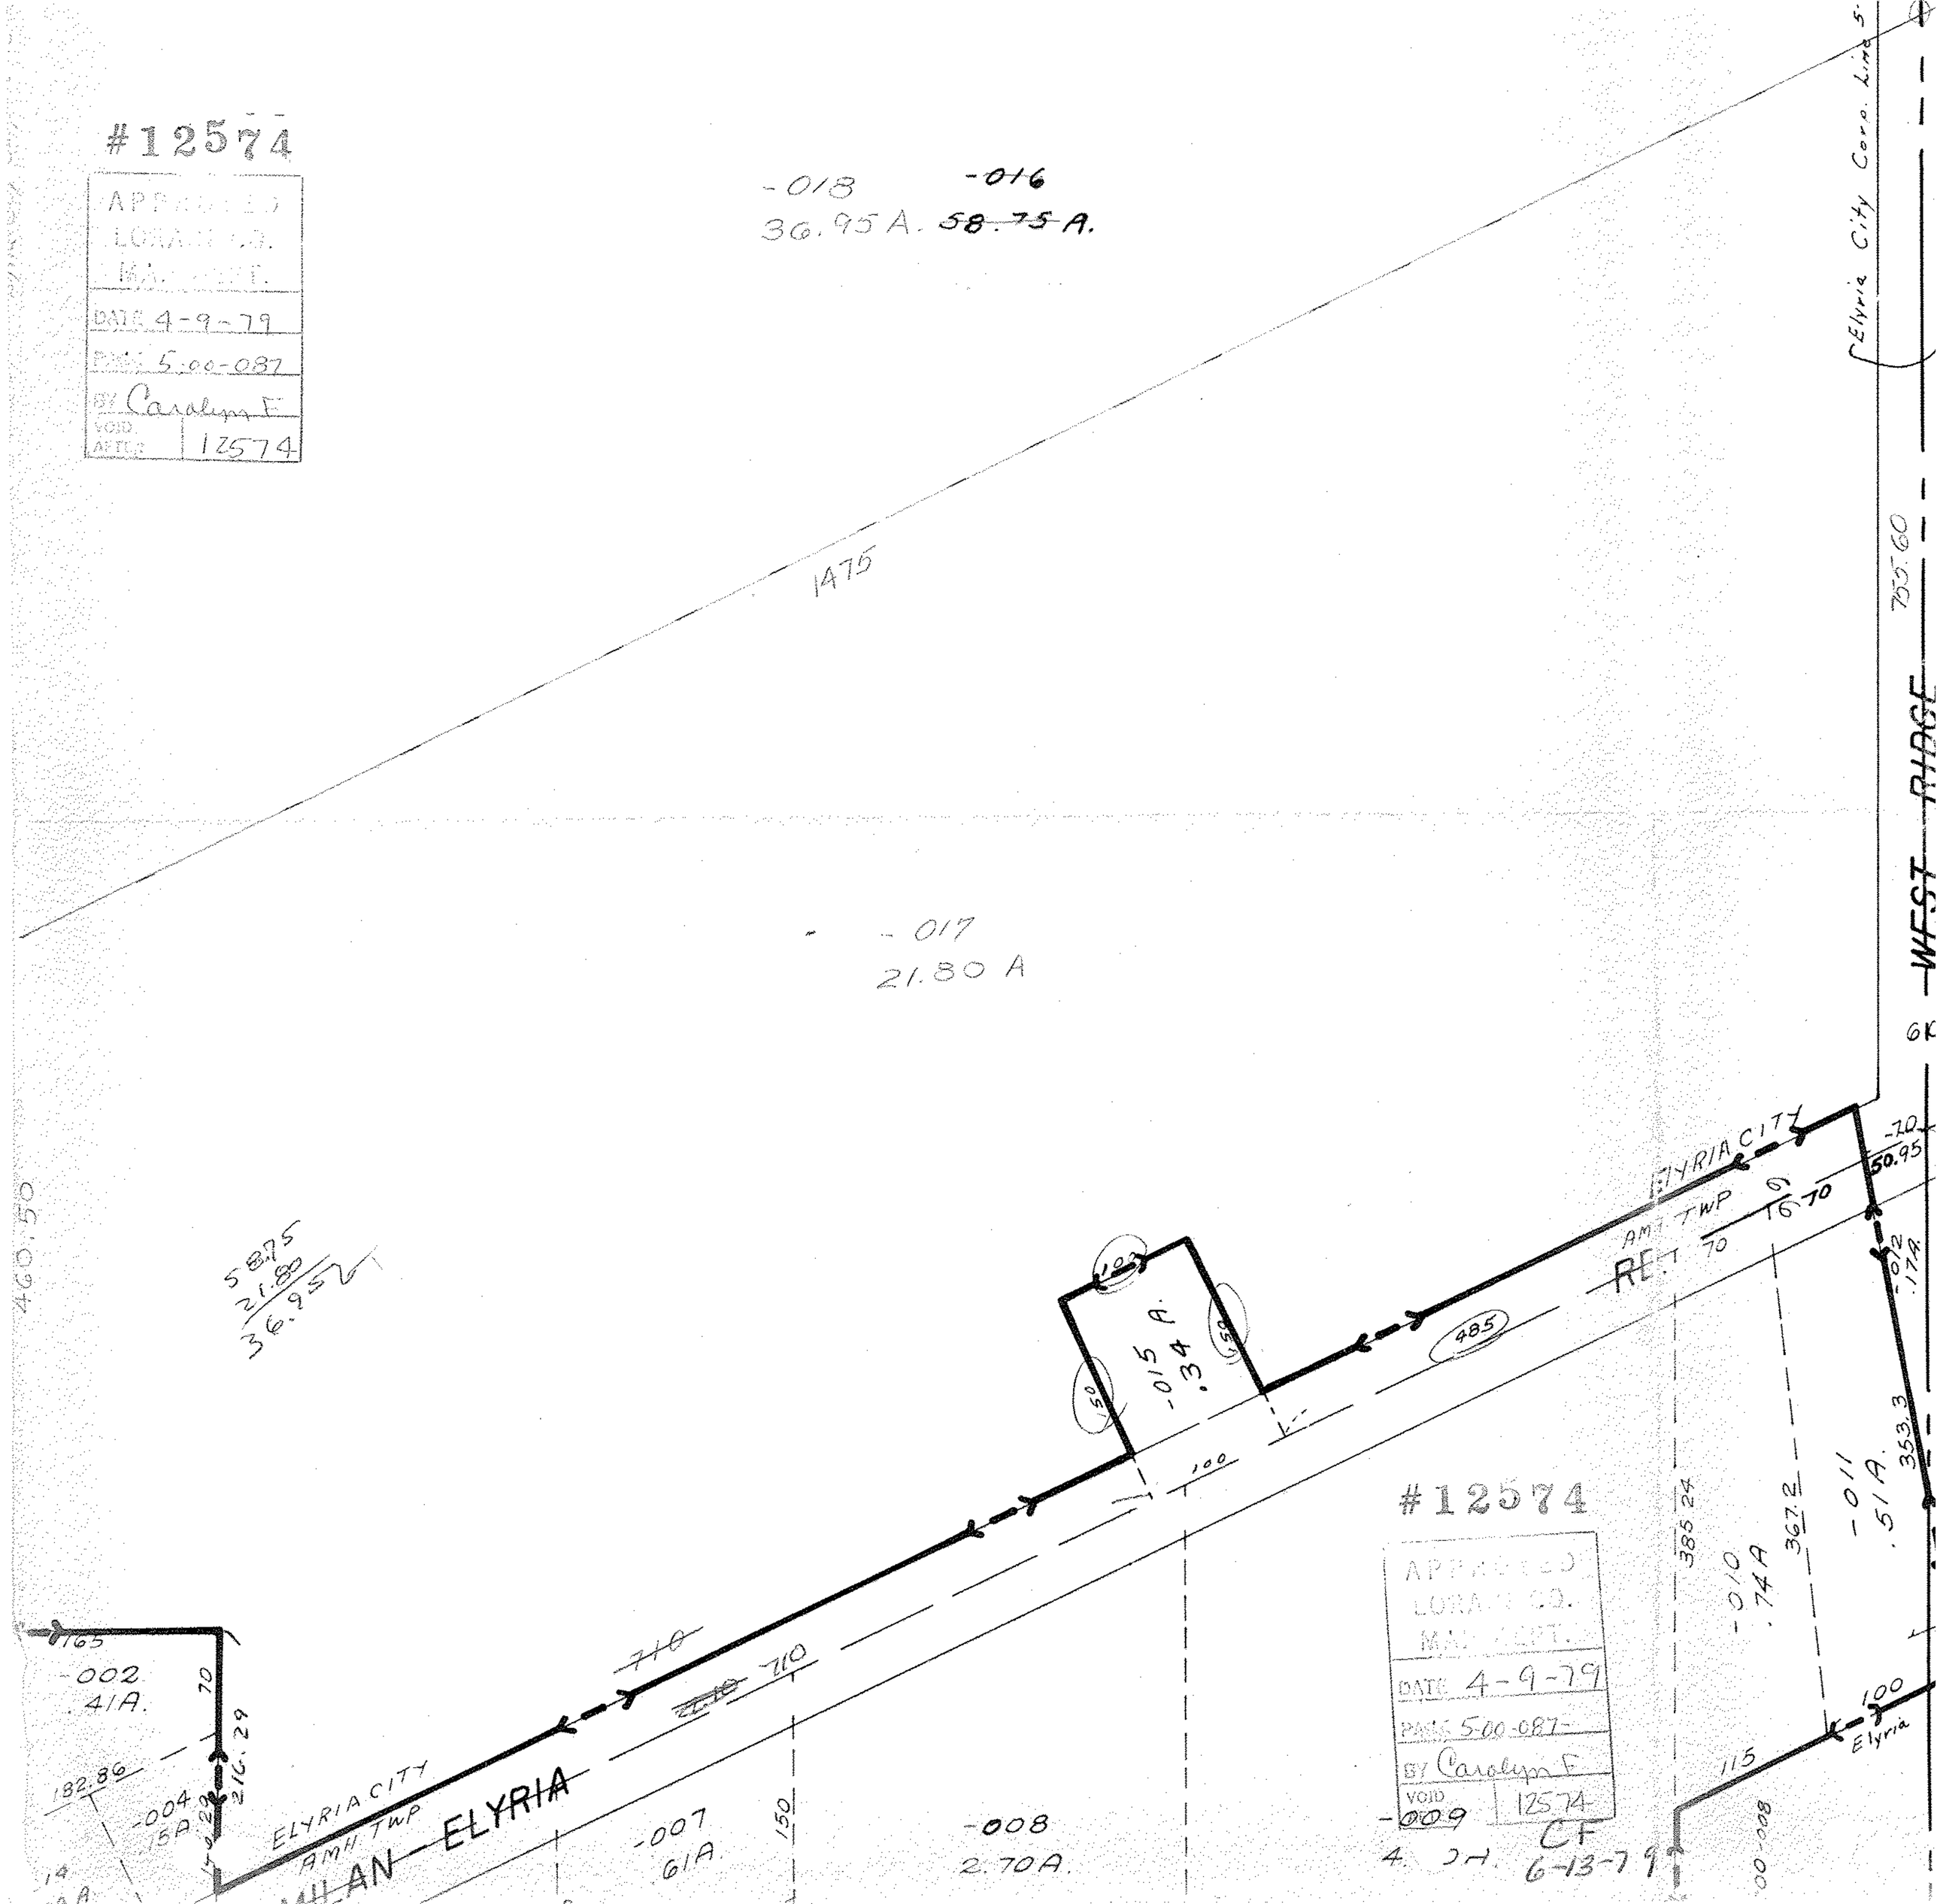

#12574
APPROVED
LORAIN CO.
MAP DEPT.
DATE 4-9-79
PAGE 5-00-087
BY Carolyn F
VOID AFTER 12574
-018
36.95 A.
-016
58.75 A.
1475
-017
21.80 A
Elyria City Corp. Line 5
755.60
WEST RIDGE
ELYRIA CITY
AMH TWP
RE
-015
.34 A.
485
100
-002
.41A.
-004
.15A
182.86
216.29
ELYRIA CITY
AMH TWP
MILAN - ELYRIA
-007
.61A.
-008
2.70A.
-009
4.
CF
6-13-79
-010
.74A
385.24
367.2
-011
.51A.
353.3
-012
.17A.
50.95
-70
Elyria
115
100
460.50
58.75
21.80
36.95