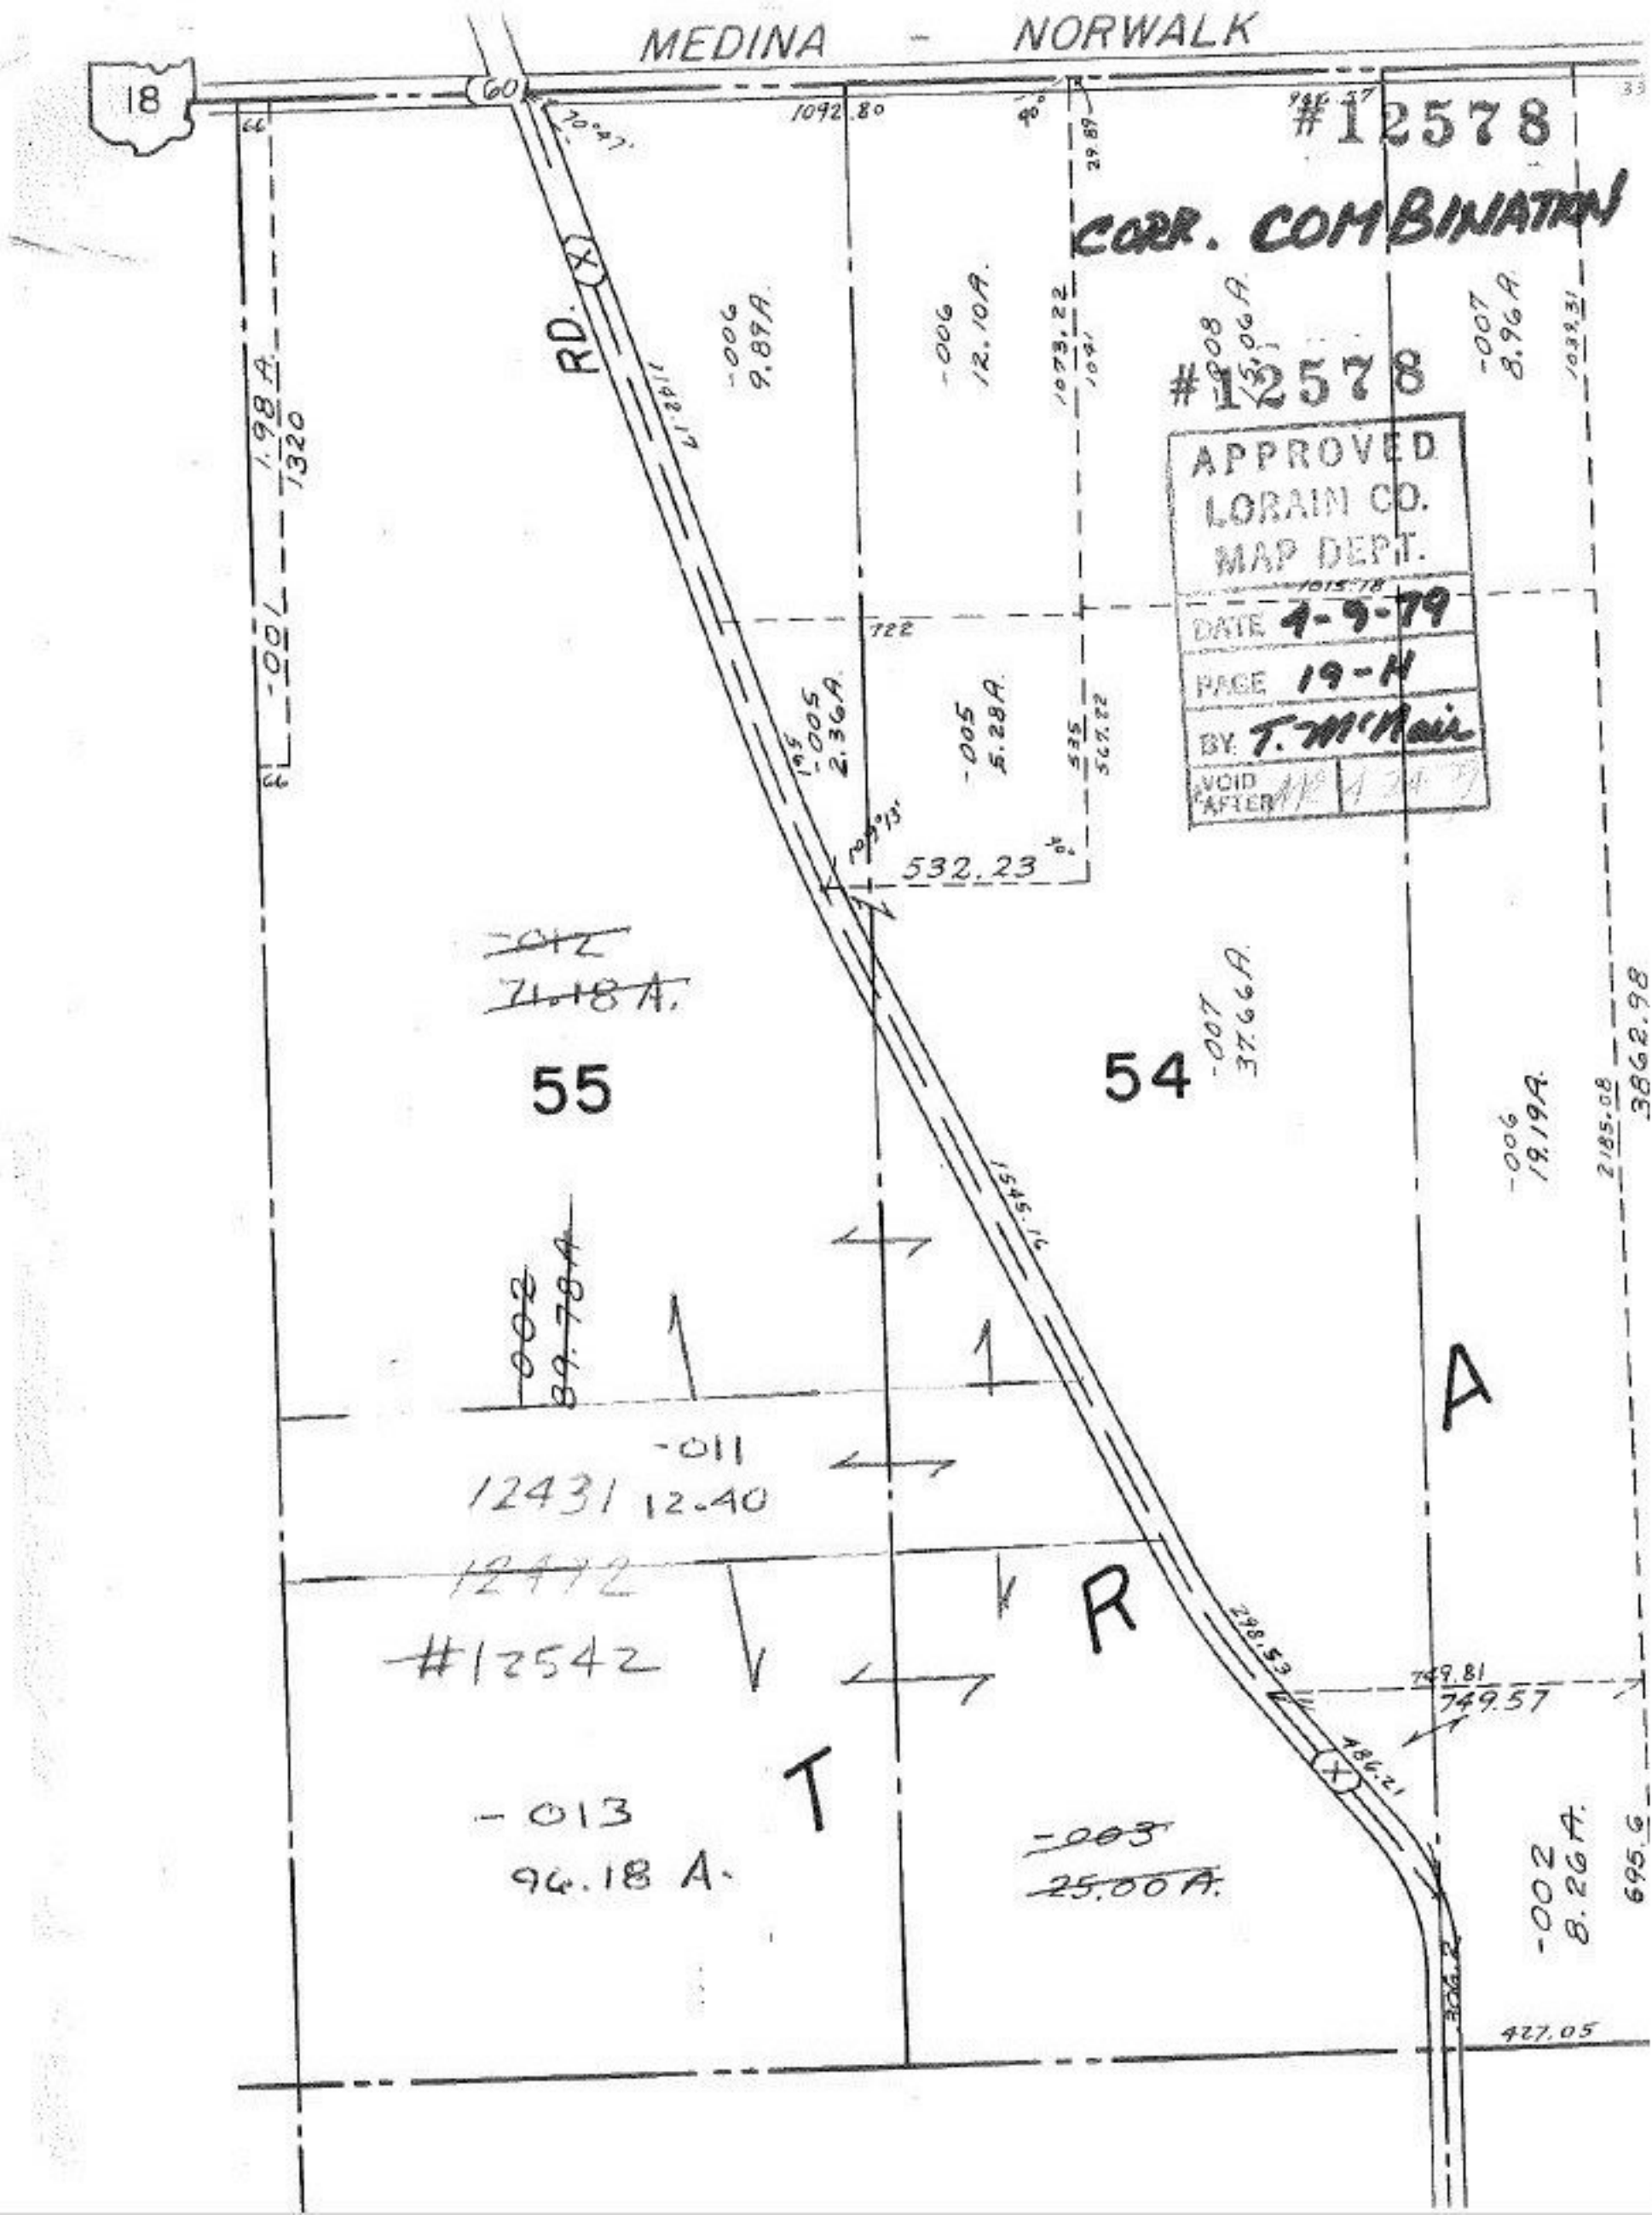
MEDINA - NORWALK
18
60
#12578
CORR. COMBINATION
RD.
-006
9.89A.
-006
12.10A.
-008
15.06A.
-007
8.96A.
#12578
APPROVED
LORAIN CO.
MAP DEPT.
DATE 4-9-79
PAGE 19-H
BY T. McNair
VOID AFTER
1.98 A.
1320
-001
-005
2.36A.
-005
5.28A.
532.23
~~-012~~
~~71.18 A.~~
55
54
-007
37.66A.
-006
19.19A.
3862.98
2185.08
1545.16
~~-002~~
~~89.78A~~
-011
12431 12.40
~~12472~~
#12542
-013
96.18 A.
~~-003~~
~~25.00 A.~~
T
R
A
298.53
749.81
749.57
486.21
-002
8.26A.
695.6
427.05