#12583

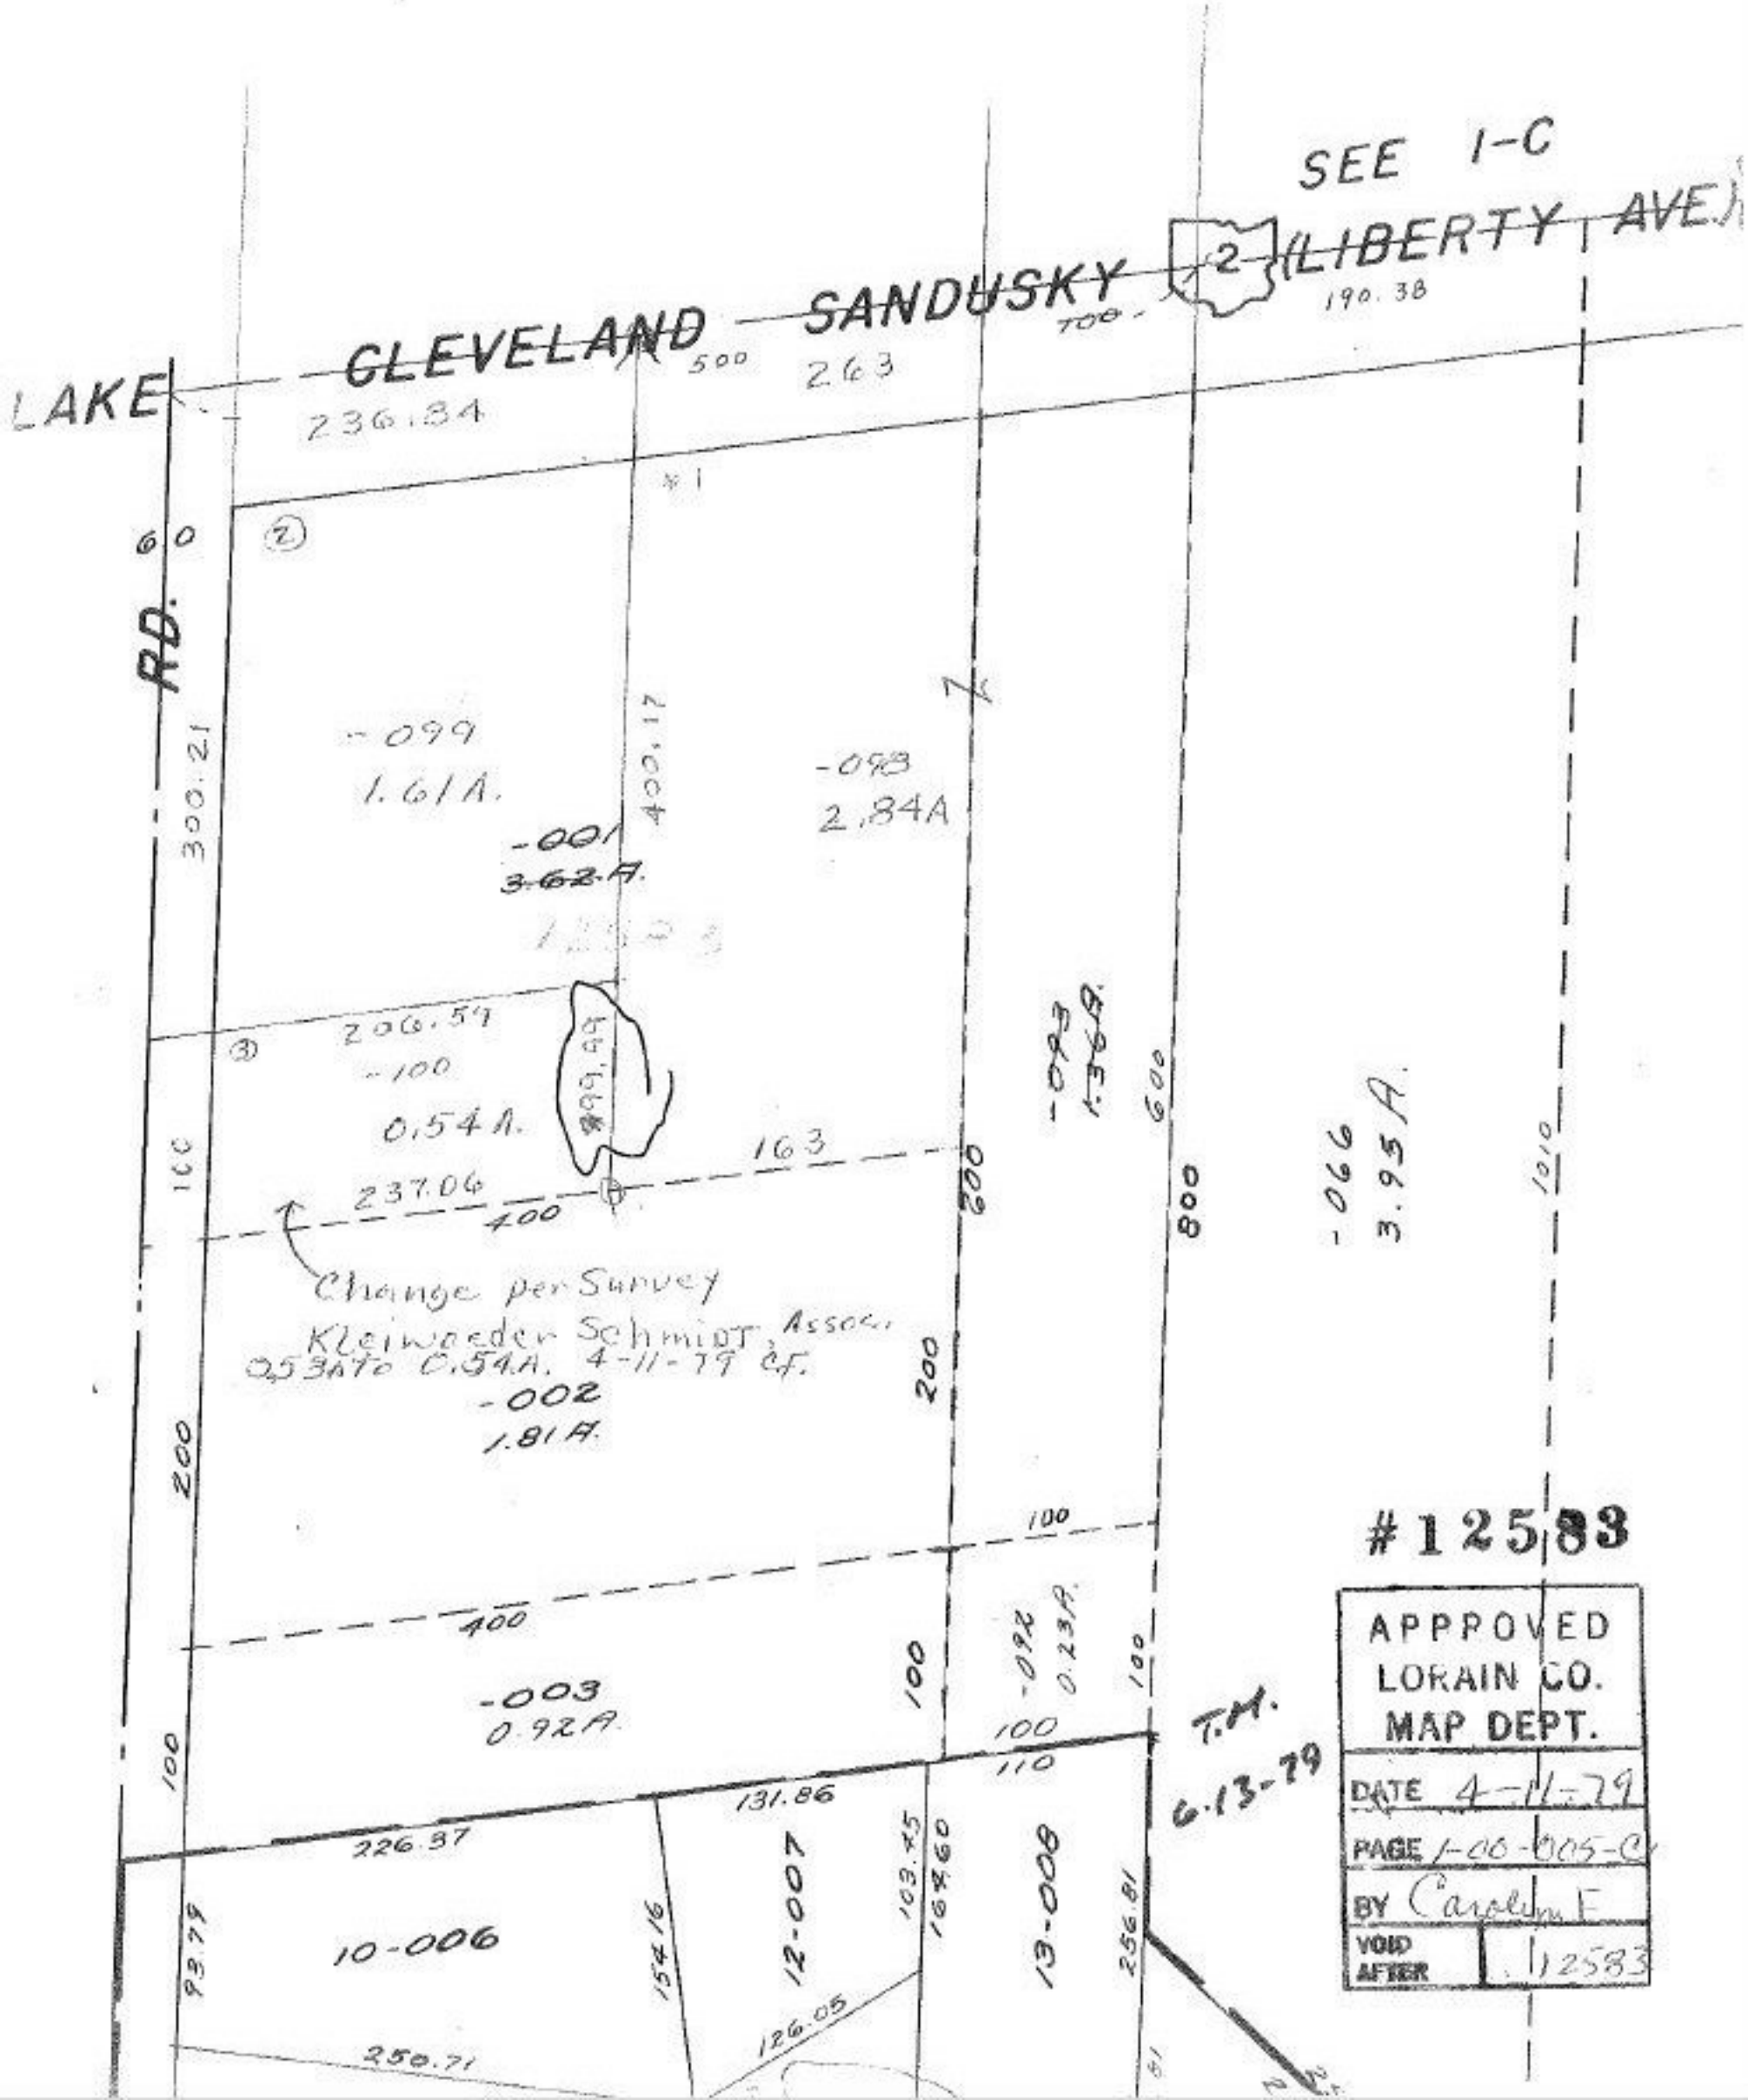

#12583

APPROVED
LORAIN CO.
MAP DEPT.

DATE 4-11-79
PAGE 1-00-005-C
BY Carolyn F
VOID AFTER 12583