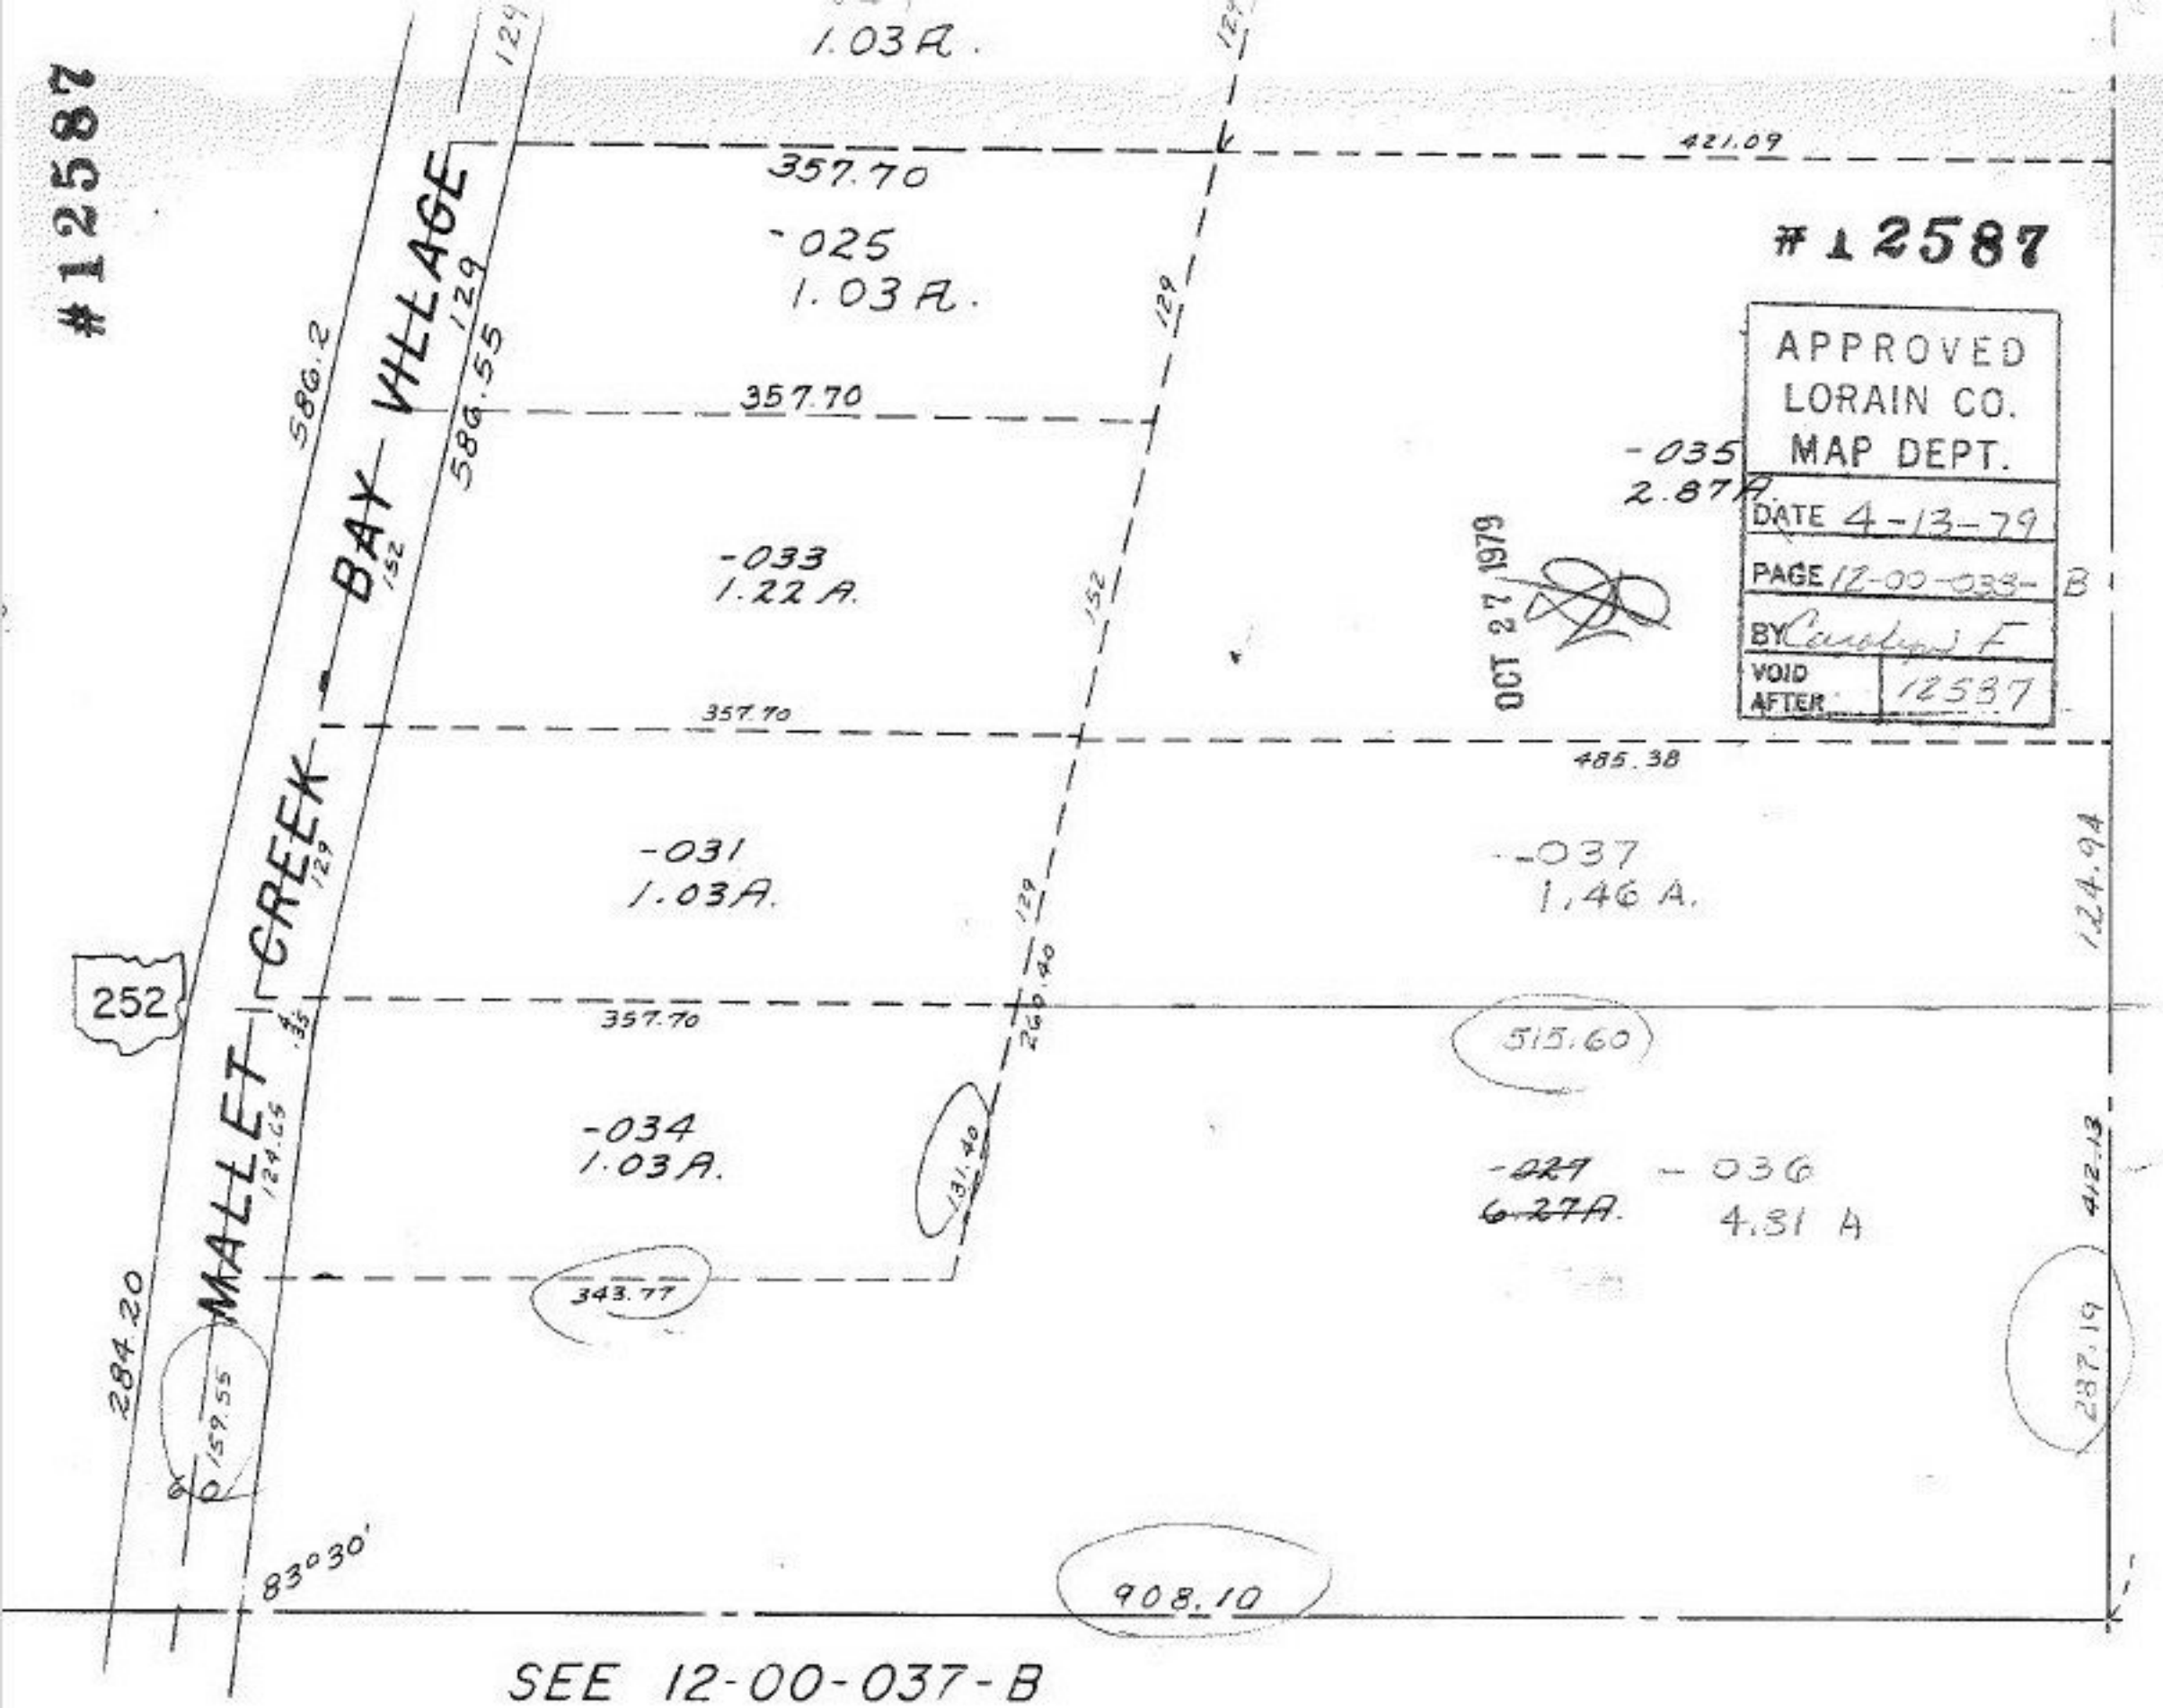

#12587
1.03A.
357.70
-025
1.03A.
421.09
#12587
APPROVED
LORAIN CO.
MAP DEPT.
DATE 4-13-79
PAGE 12-00-033-B
BY Carolyn F
VOID AFTER 12587
OCT 27 1979
-035
2.87A.
586.2
586.55
MALLET CREEK - BAY VILLAGE
129
152
357.70
-033
1.22A.
357.70
485.38
-031
1.03A.
-037
1.46A.
124.94
252
357.70
260.40
515.60
-034
1.03A.
131.40
-027
6.27A.
-036
4.31A
412.13
343.77
284.20
159.55
287.19
83°30'
908.10
SEE 12-00-037-B