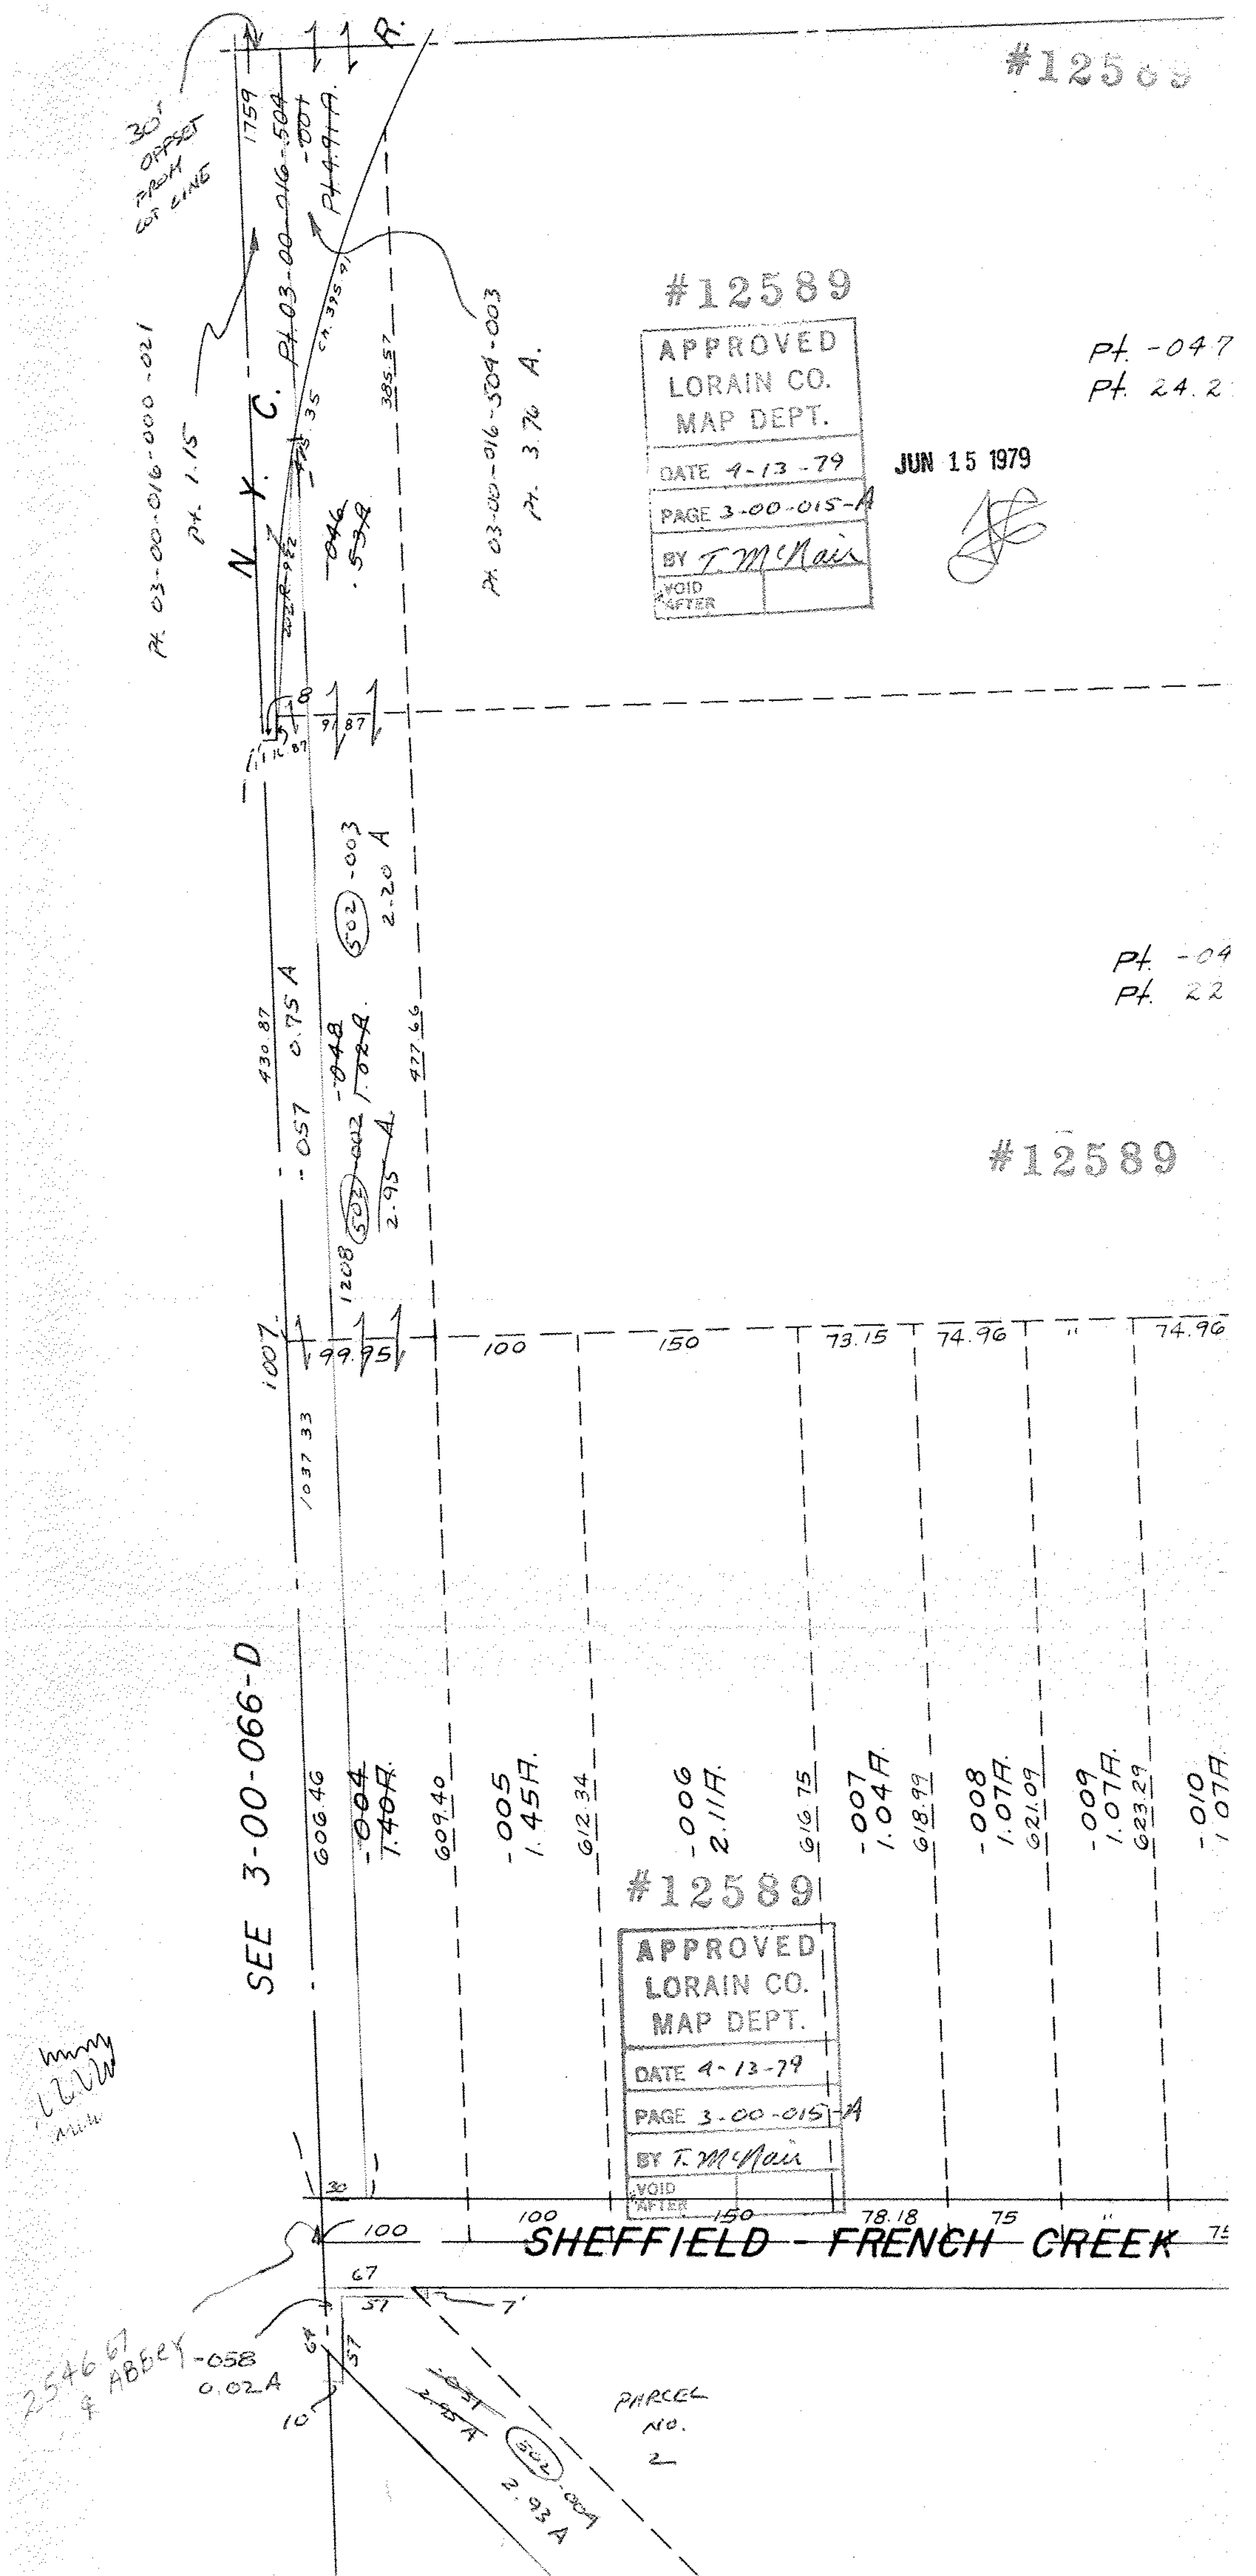

#12589
30' OFFSET FROM COT LINE
N. Y. C. R.
Pt. 03-00-016-000-021
Pt. 1.15
Pt. 03-00-016-504-001
Pt. 4.91 A.
Pt. 03-00-016-504-003
Pt. 3.76 A.
#12589
APPROVED
LORAIN CO.
MAP DEPT.
DATE 4-13-79
PAGE 3-00-015-A
BY T. McNair
VOID AFTER
JUN 15 1979
Pt. -047
Pt. 24.2
Pt. -04
Pt. 22
#12589
SEE 3-00-066-D
#12589
APPROVED
LORAIN CO.
MAP DEPT.
DATE 4-13-79
PAGE 3-00-015-A
BY T. McNair
VOID AFTER
SHEFFIELD - FRENCH CREEK
2546.67 ℄ ABBEY
-058
0.02 A
PARCEL NO. 2