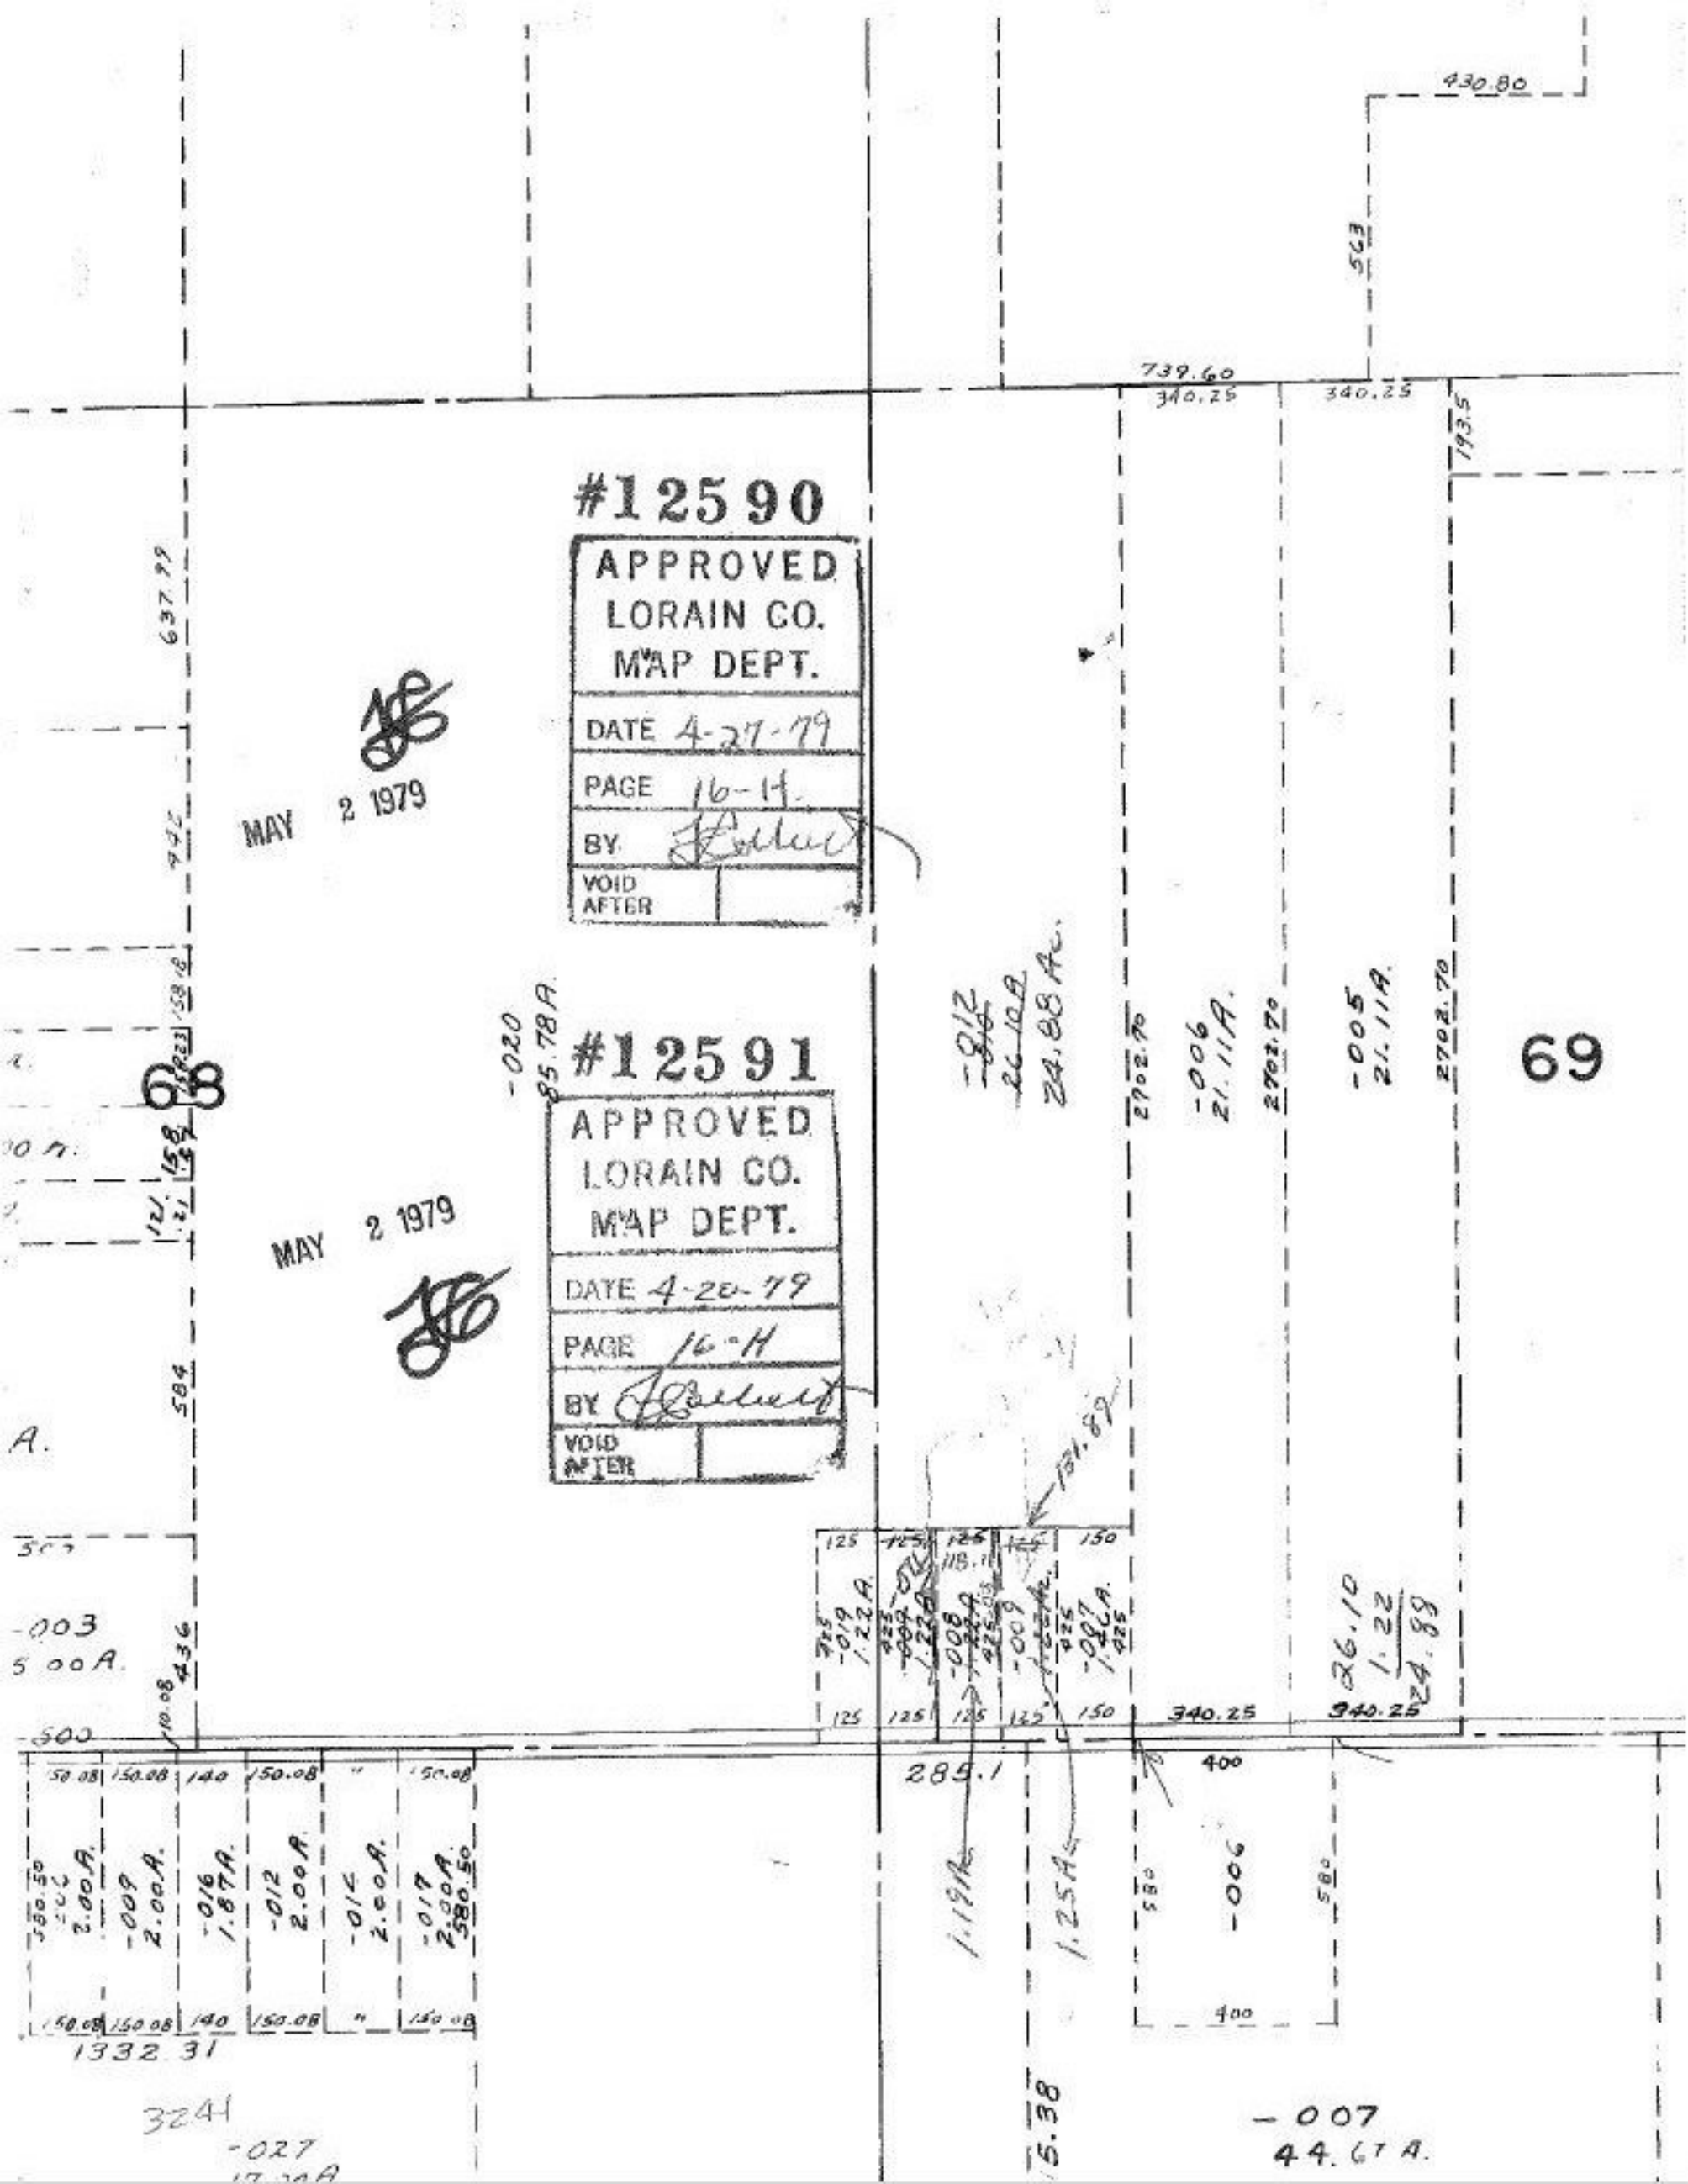

#12590
APPROVED
LORAIN CO.
MAP DEPT.
DATE 4-27-79
PAGE 16-H.
BY
VOID AFTER
MAY 2 1979
#12591
APPROVED
LORAIN CO.
MAP DEPT.
DATE 4-20-79
PAGE 16-H
BY
VOID AFTER
MAY 2 1979
68
69
430.80
563
739.60
340.25
340.25
193.5
637.99
-020
85.78A.
-012
26.10A
24.88 Ac.
2702.70
-006
21.11A.
2702.70
-005
21.11A.
2702.70
-003
5.00A.
436
-500
125
125
125
125
150
-019
1.22A.
-008
-009
-007
1.46A.
131.89
26.10
1.22
24.88
340.25
340.25
285.1
400
1.19A
1.25A
-006
580
580
400
150.08
150.08
140
150.08
150.08
-009
2.00A.
-016
1.87A.
-012
2.00A.
-014
2.00A.
-017
2.00A.
580.50
1332.31
3241
-027
-007
44.67 A.