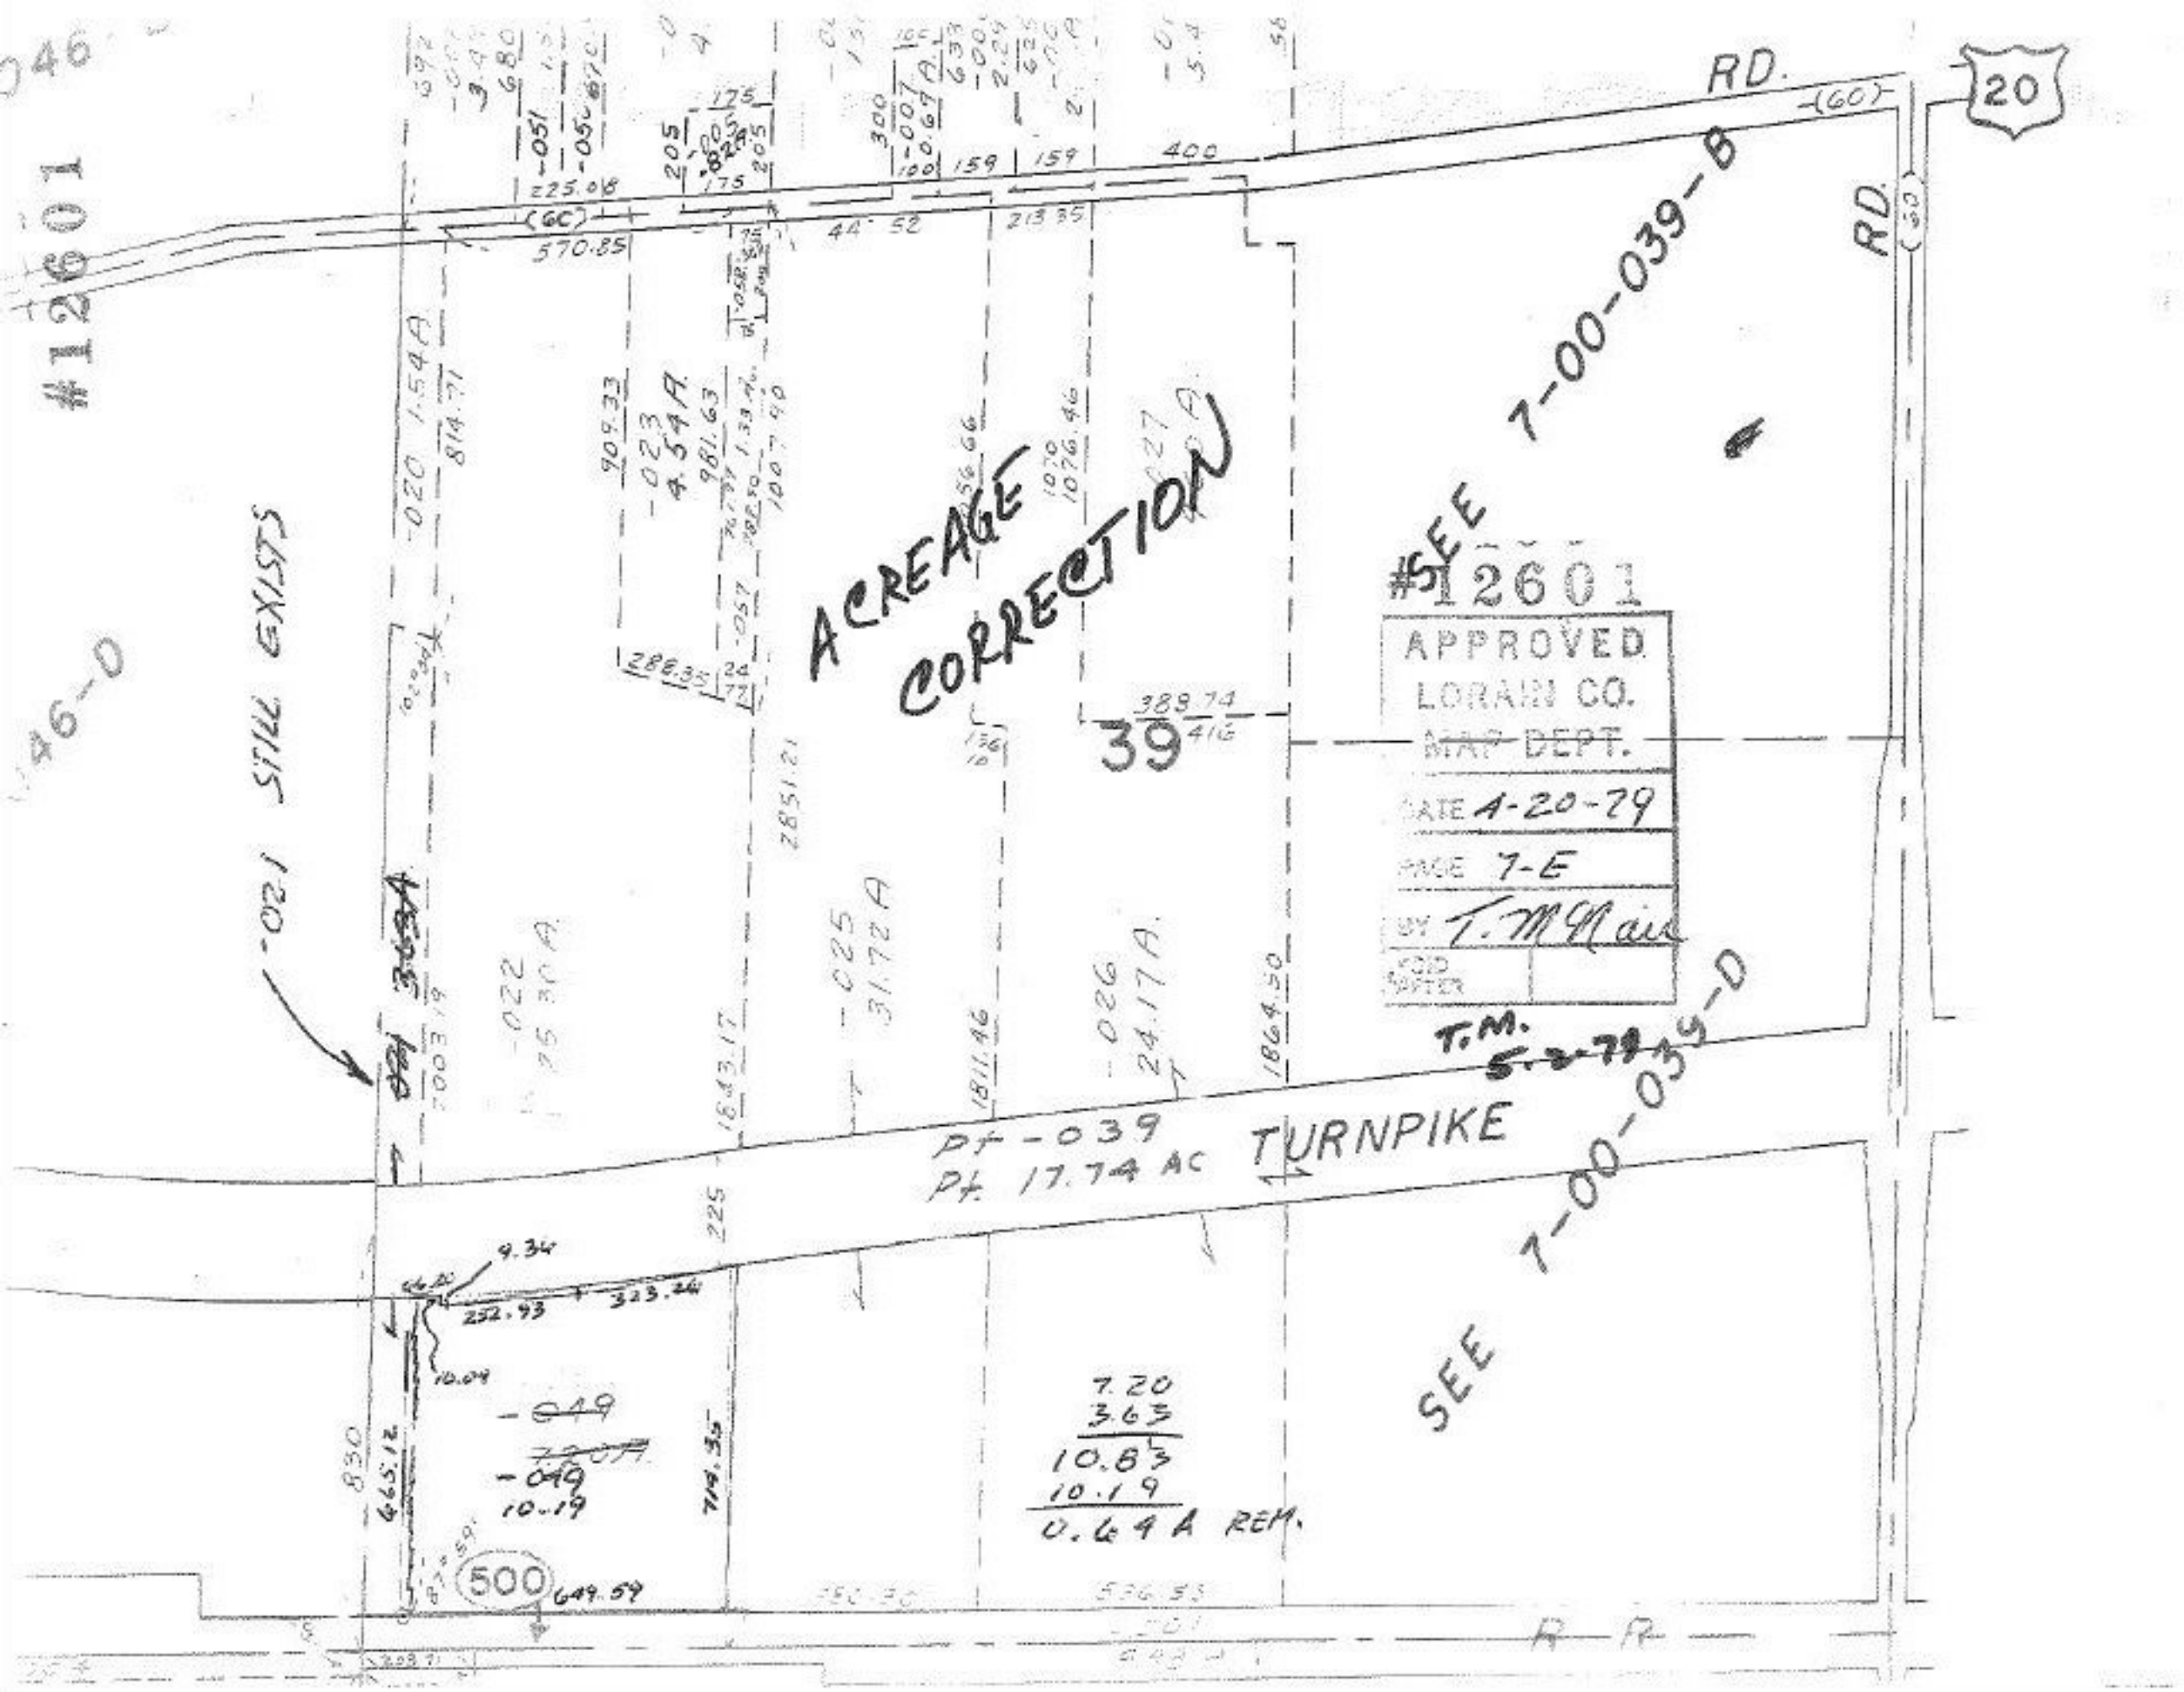

#12601
RD.
20
RD.
ACREAGE CORRECTION
SEE 7-00-039-B
#12601
APPROVED
LORAIN CO.
MAP DEPT.
DATE 4-20-79
PAGE 7-E
BY T. McNair
VOID AFTER
T.M. 5-2-79
39
STILL EXISTS
-021
-022
25.30 A
-025
31.72 A
-026
24.17 A
-023
4.54 A
-020
1.54 A
-049
10.19
7.20
3.63
10.83
10.19
0.64 A REM.
Pt -039
Pt. 17.74 AC
TURNPIKE
SEE 7-00-039-D
500
649.59