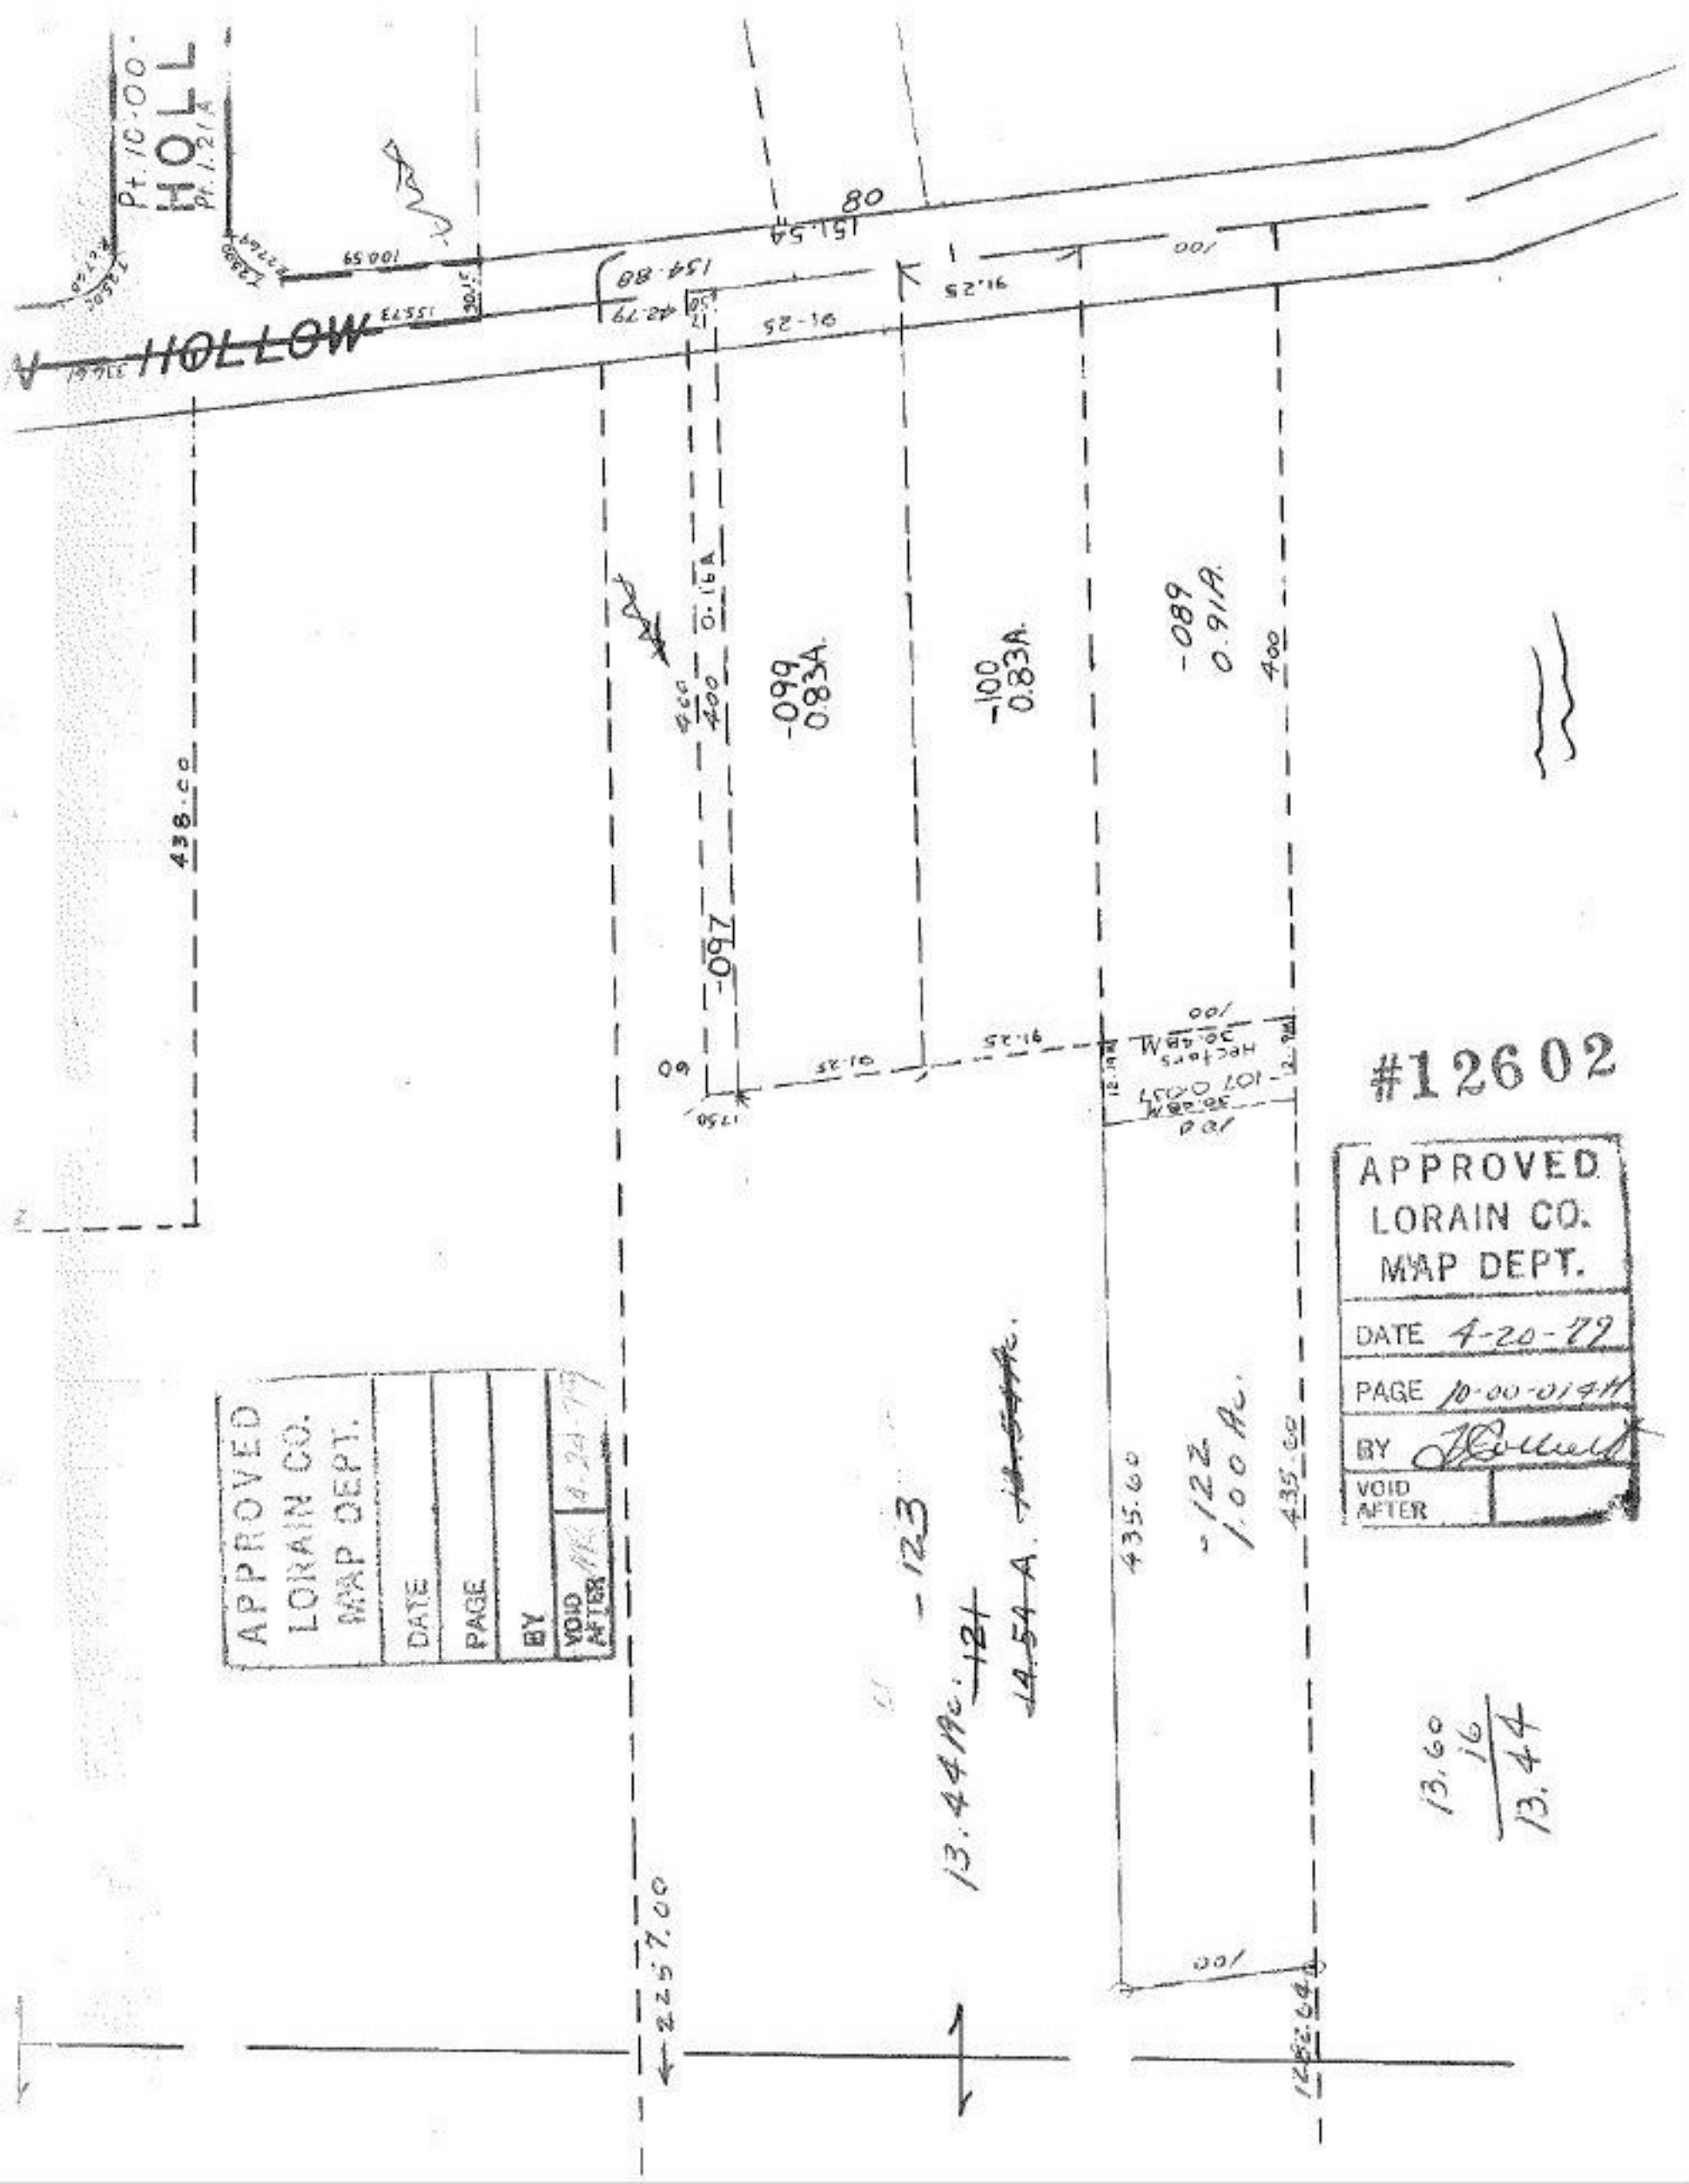

Pt. 10-00-
HOLL
Pt. 1.21A
HOLLOW
80
151.54
154.88
42.79
91.25
100.59
100
438.00
-099
0.83A
-100
0.83A
-089
0.91A
400
0.16A
-097
60
91.25
Hectors
30.48M
107.0037
-123
13.44Ac.
14.54A
-122
1.00Ac.
435.60
13.60
16
13.44
2257.00
1282.64
#12602
APPROVED
LORAIN CO.
MAP DEPT.
DATE 4-20-79
PAGE 10-00-014H
BY
VOID AFTER
APPROVED
LORAIN CO.
MAP DEPT.
DATE
PAGE
BY
VOID AFTER
4-24-79