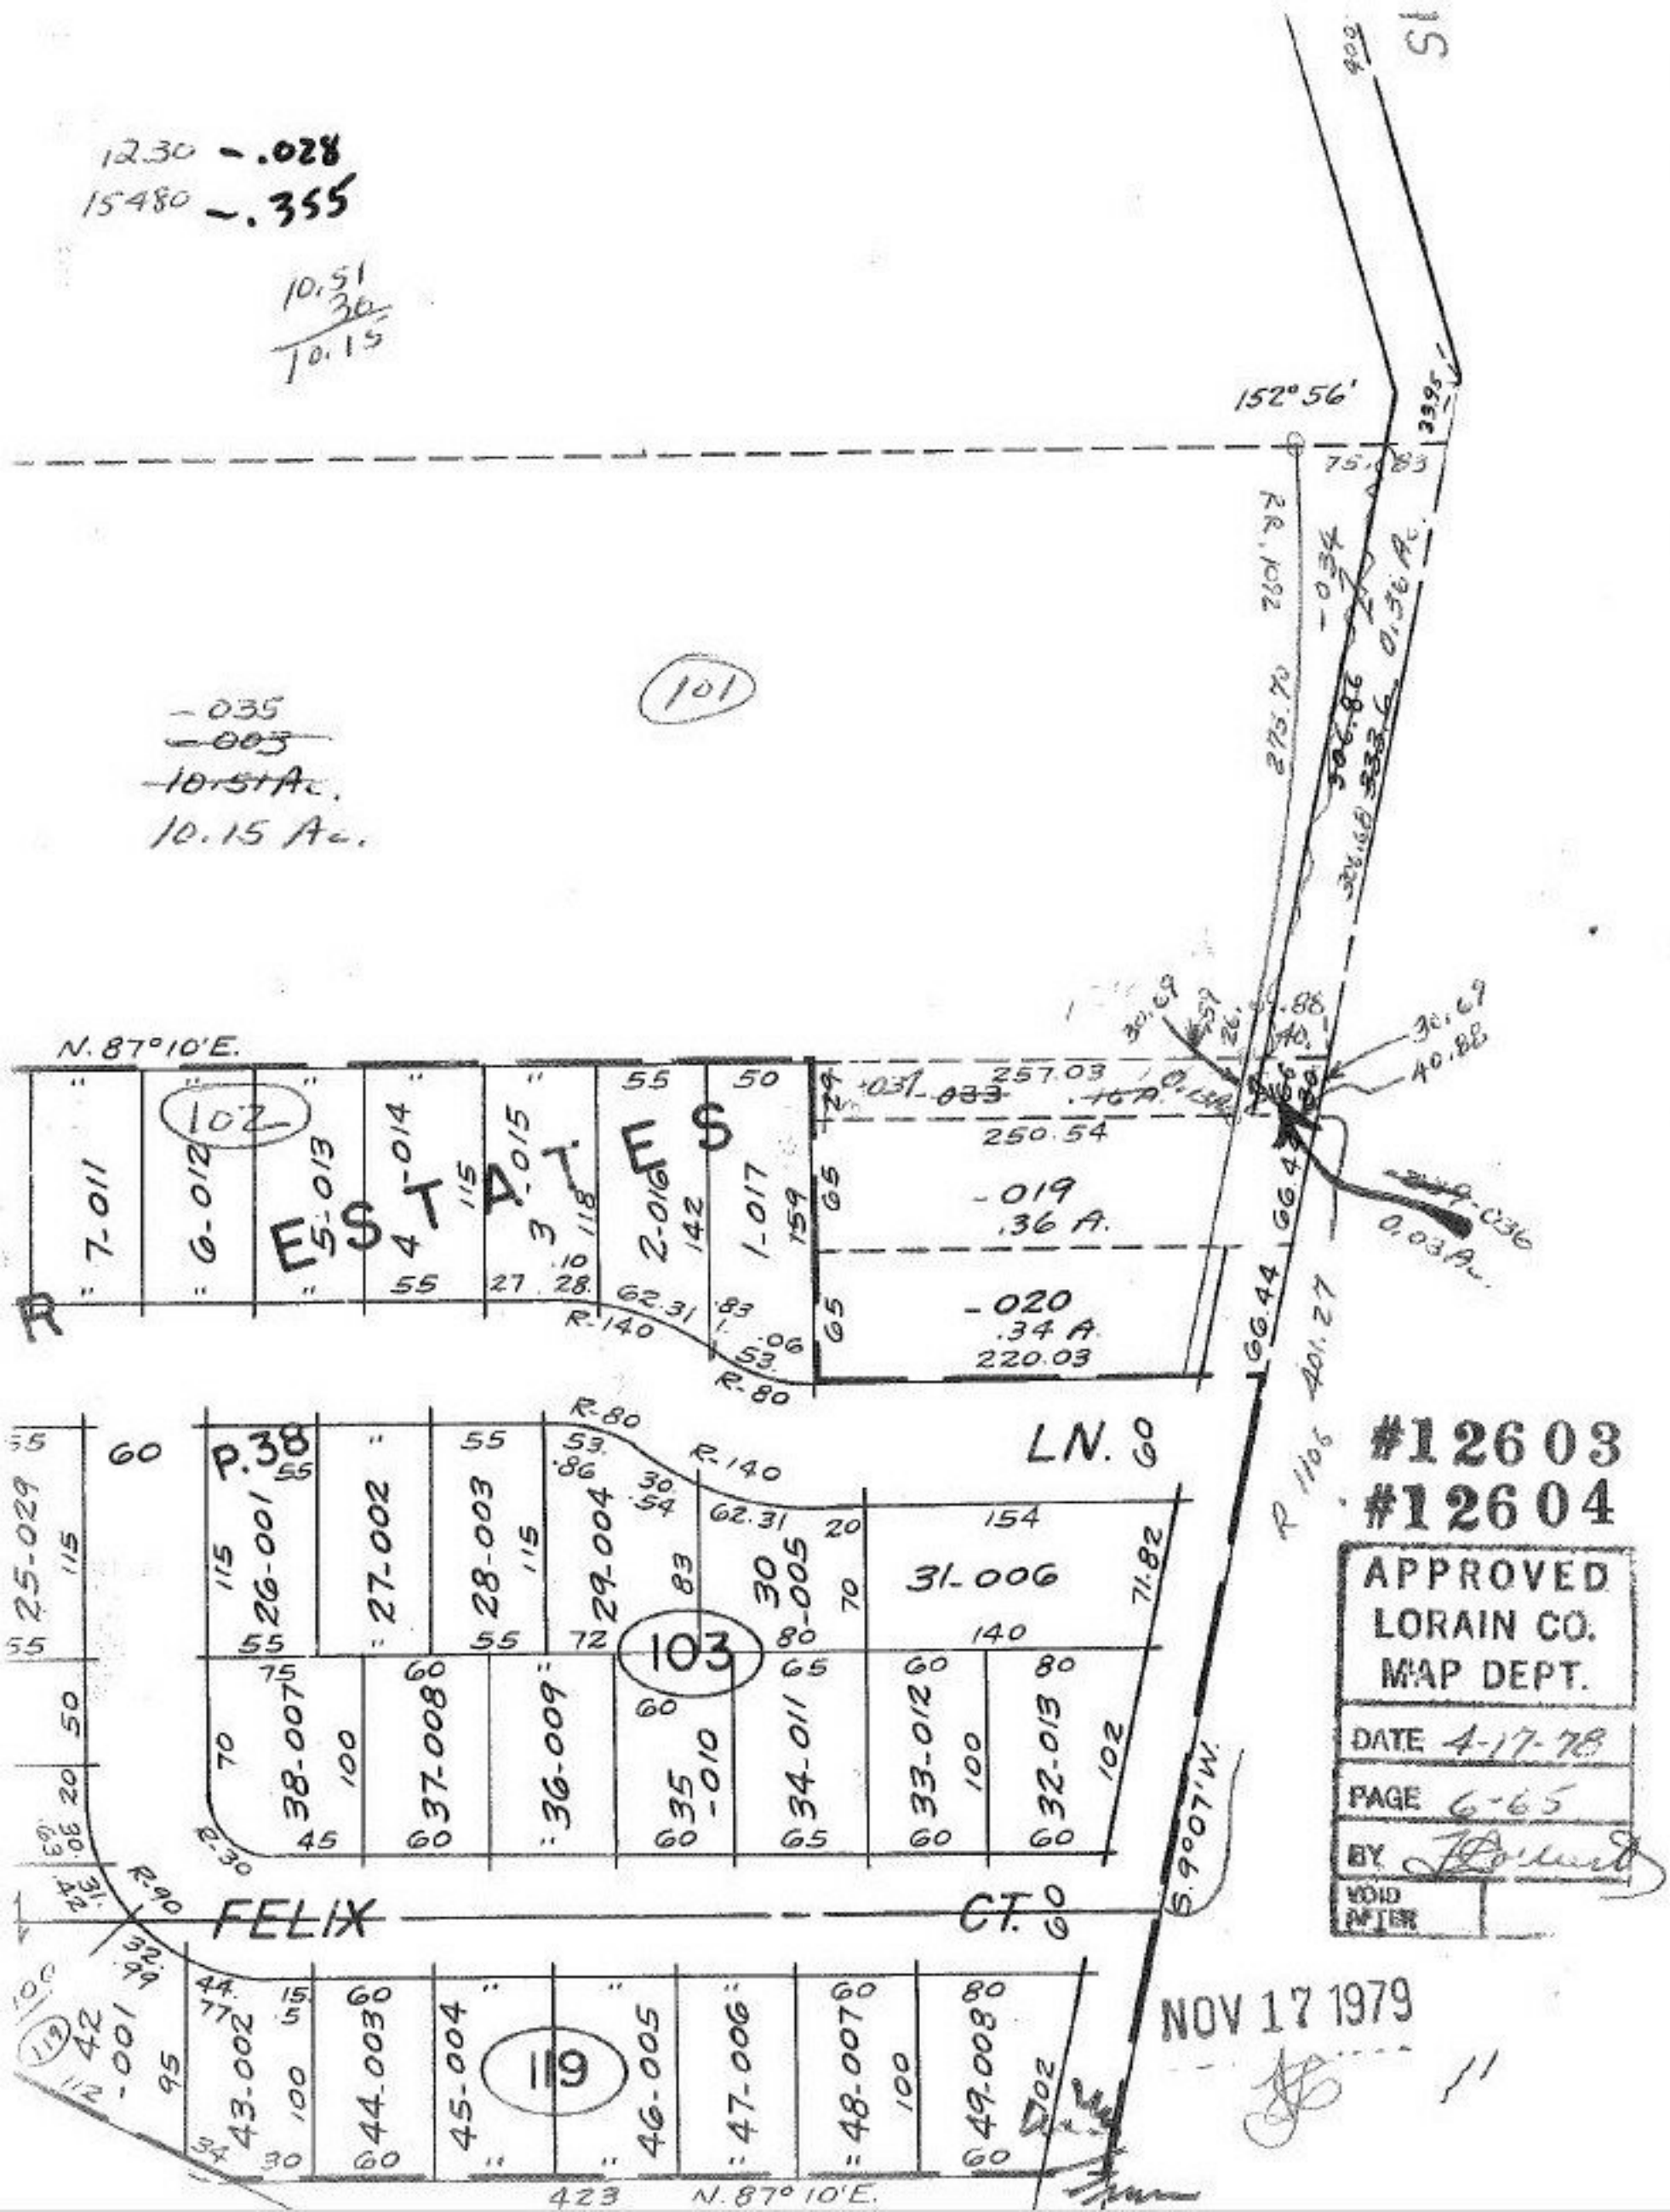


#12603
#12604

APPROVED
LORAIN CO.
MAP DEPT.

DATE 4-17-78
PAGE 6-65
BY
VOID AFTER

NOV 17 1979