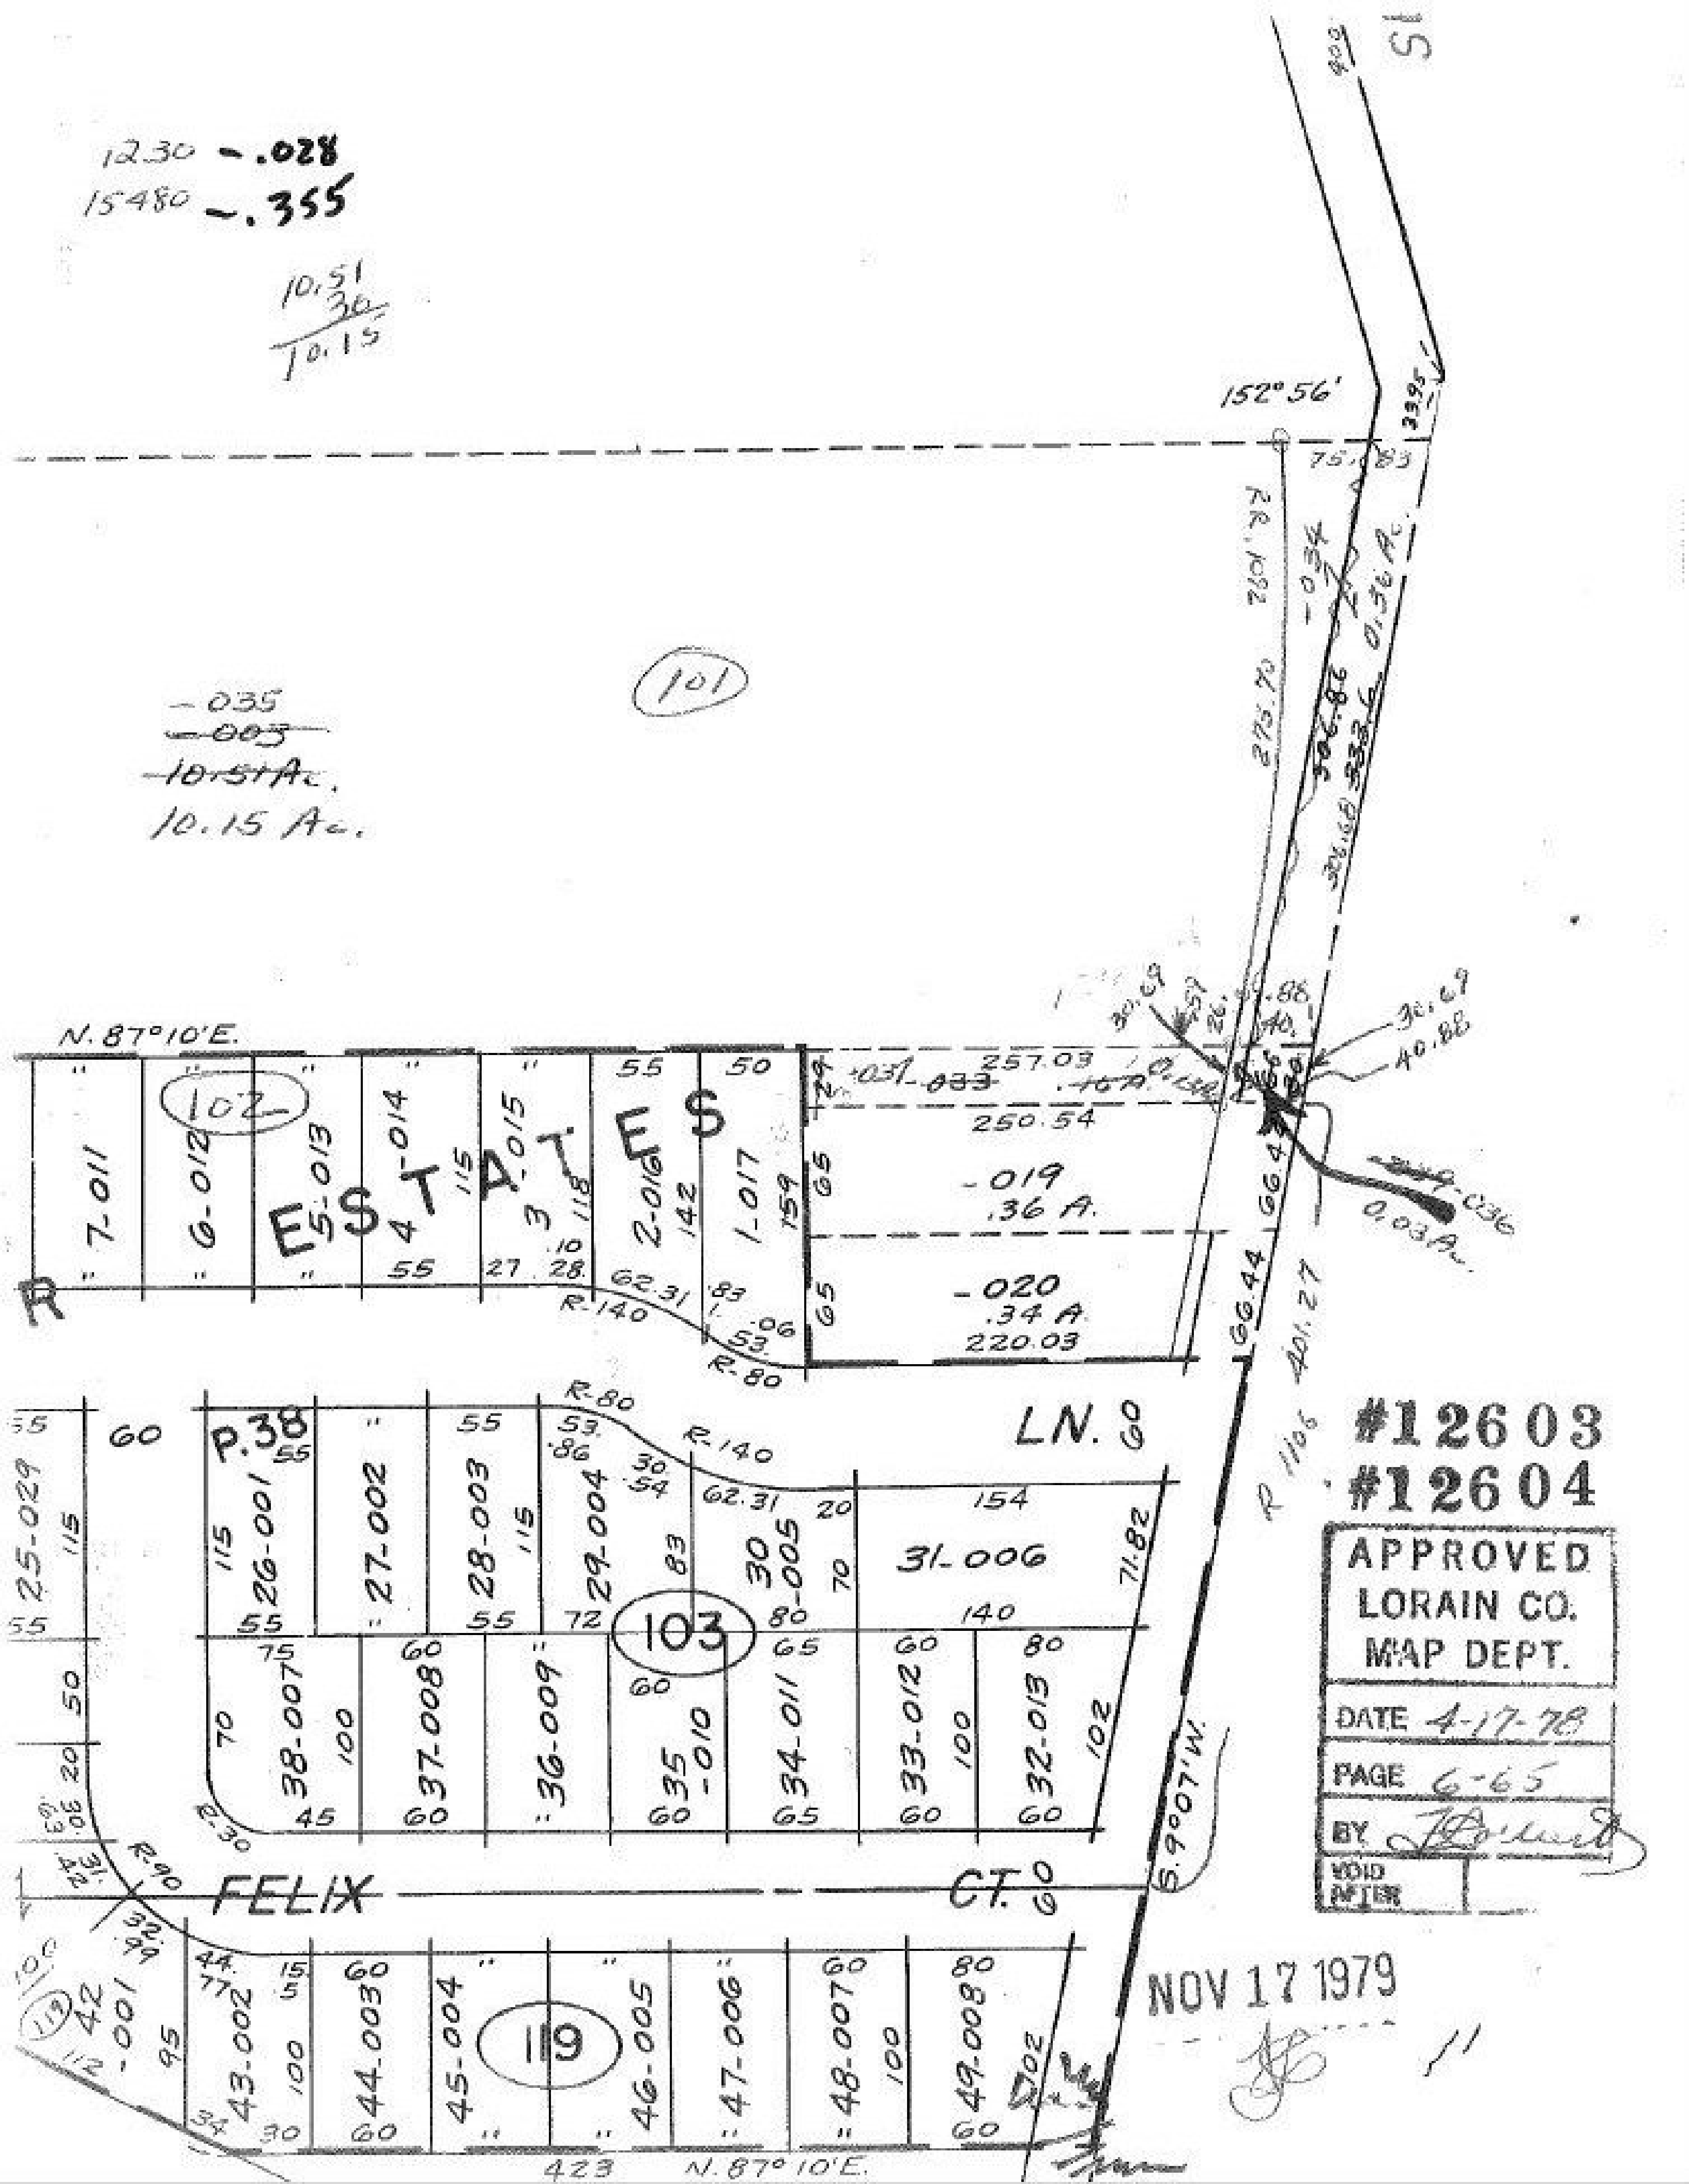

1230 -.028
15480 -.355
10.51
.36
10.15
152°56'
75.83
3395
-034
0.36 Ac.
275.70
306.86
333.6
306.60
101
-035
-003
10.51 Ac.
10.15 Ac.
N.87°10'E.
102
ESTATES
7-011
6-012
5-013
4-014
3-015
2-016
1-017
55
50
115
118
142
159
27.28
62.31
R.140
R.80
53.
257.03
250.54
-031
-033
.46 A.
-019
.36 A.
-020
.34 A.
220.03
66.44
401.27
R 1106
30.69
40.88
-036
0.03 A.
LN. 60
P.38
25-029
26-001
27-002
28-003
29-004
30-005
31-006
154
140
71.82
103
38-007
37-008
36-009
35-010
34-011
33-012
32-013
102
R.30
R.90
FELIX
CT. 60
S.9°07'W.
119
42-001
43-002
44-003
45-004
46-005
47-006
48-007
49-008
423
N.87°10'E.
#12603
#12604
APPROVED
LORAIN CO.
MAP DEPT.
DATE 4-17-78
PAGE 6-65
BY
VOID AFTER
NOV 17 1979