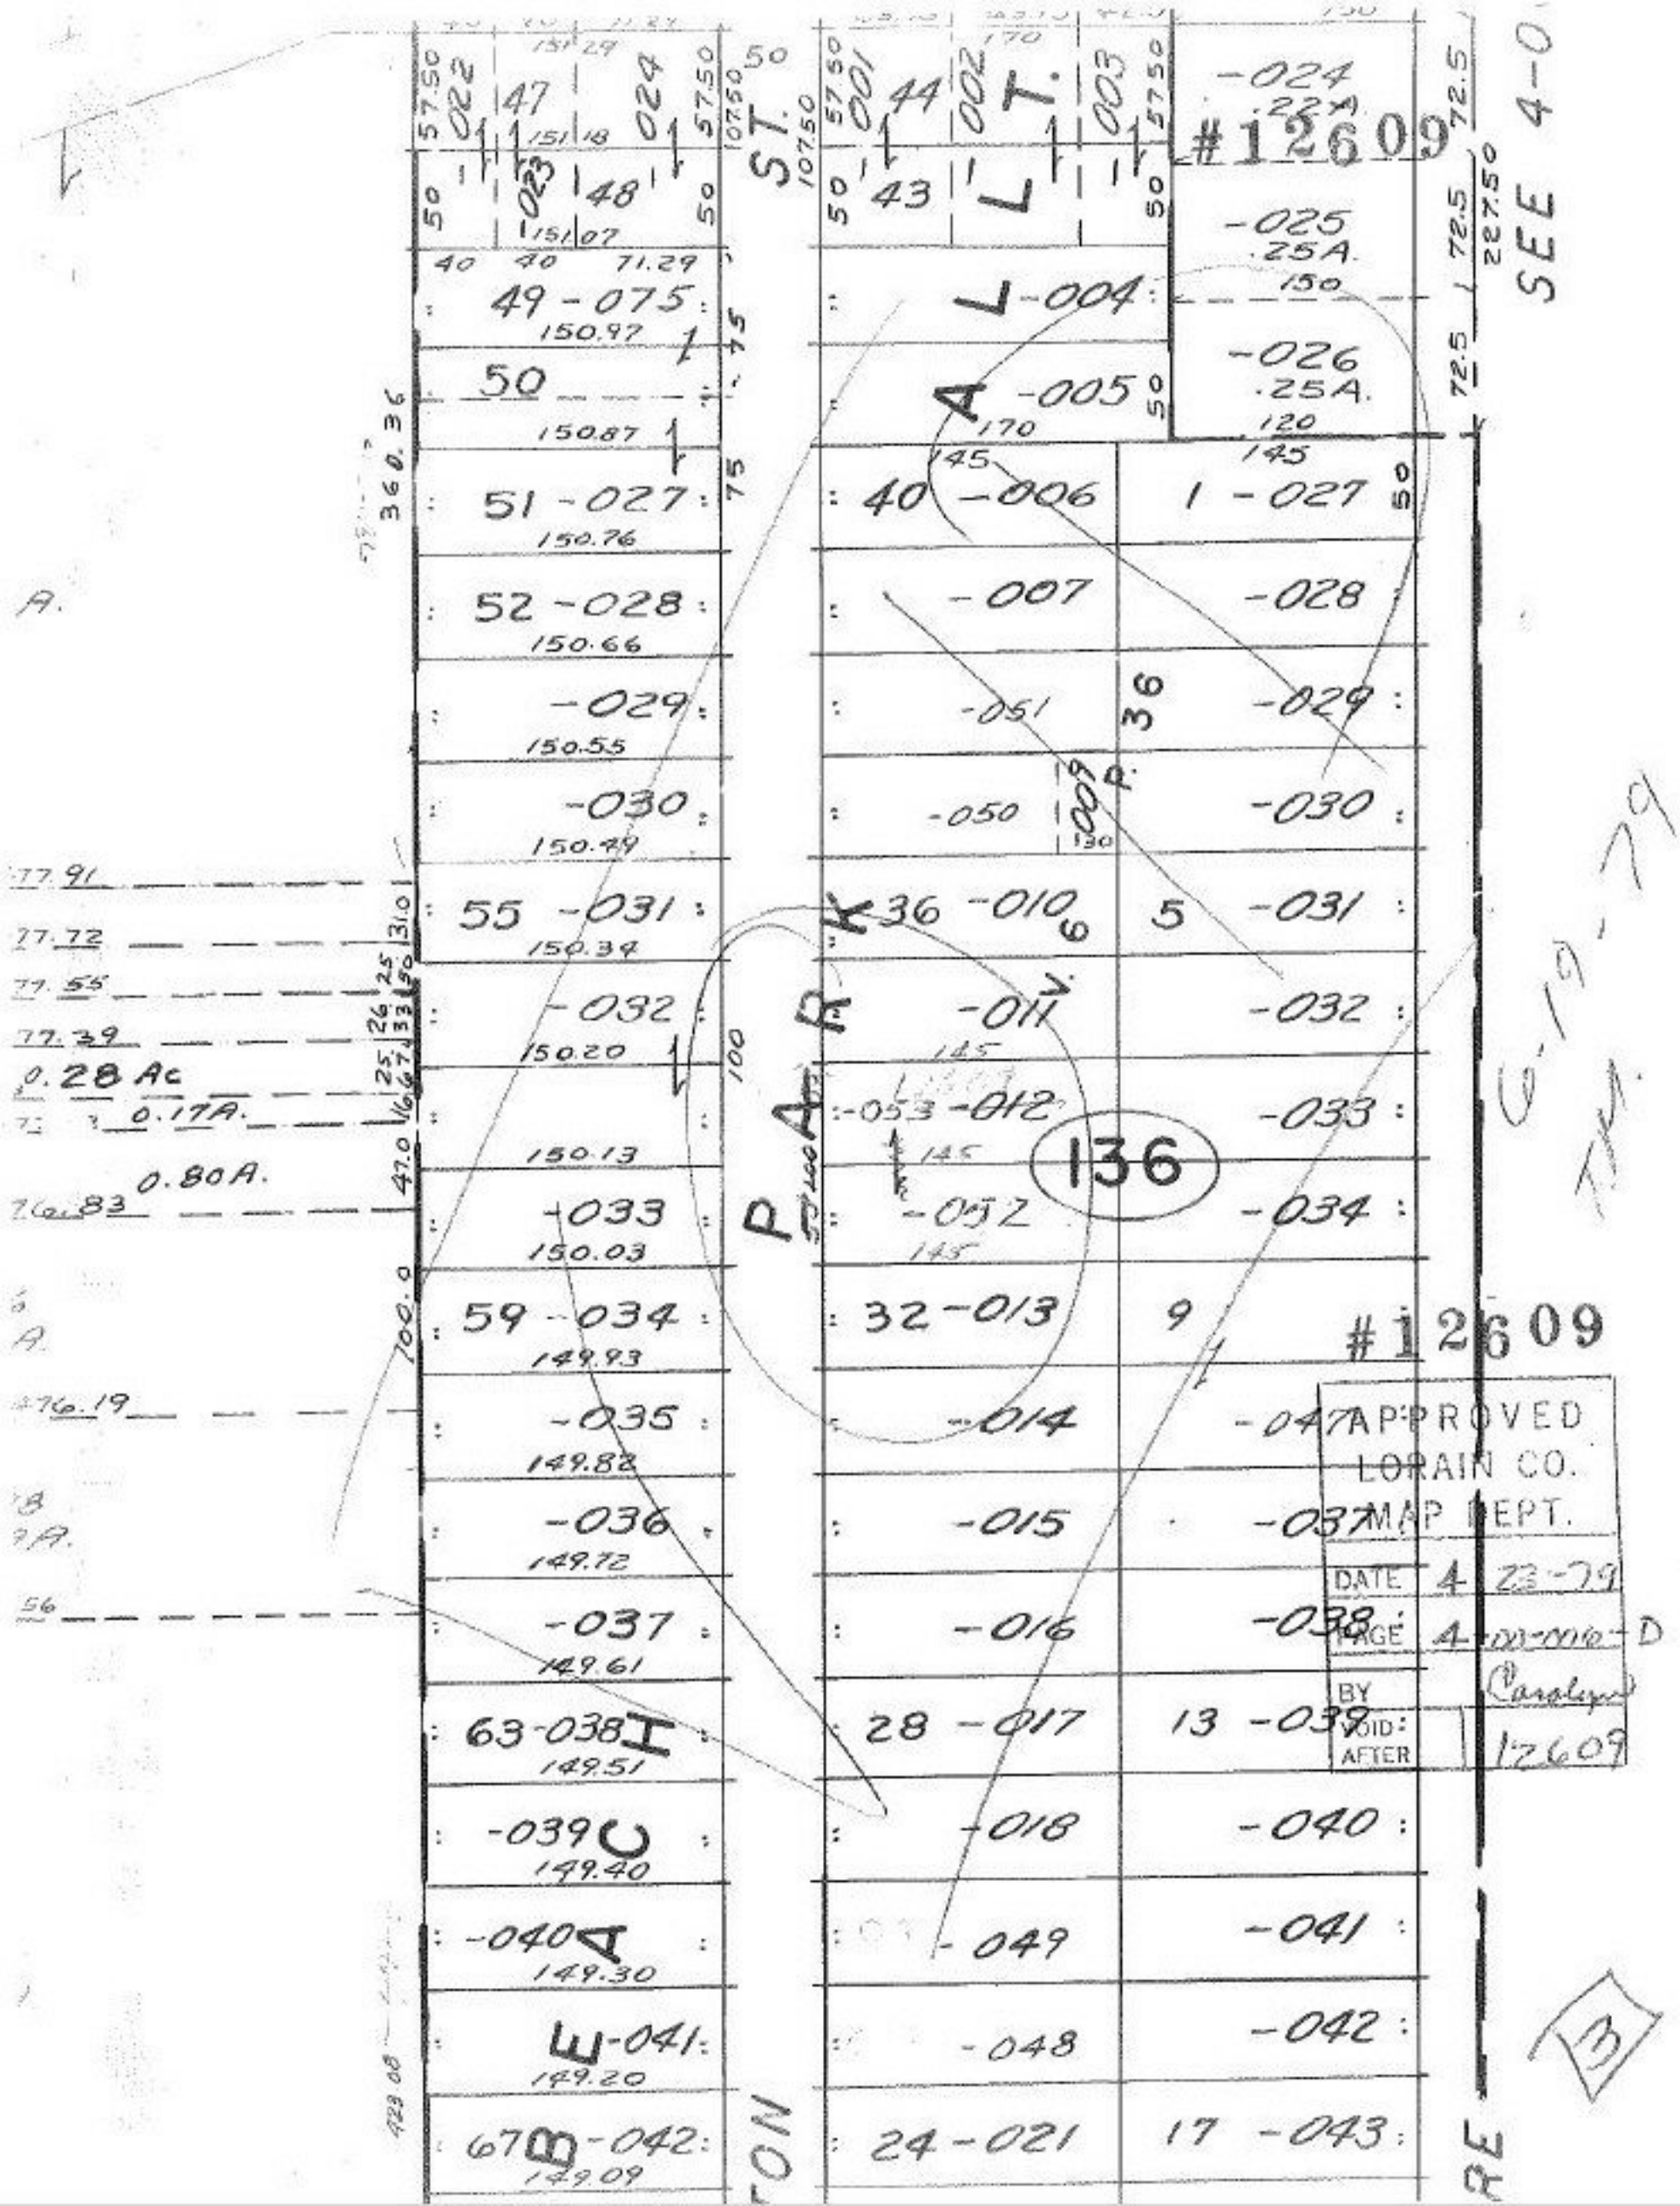

#12609
SEE 4-0
ST.
ALLT.
PARK
BEACH
136
#12609
APPROVED
LORAIN CO.
MAP DEPT.
DATE 4-23-79
PAGE 4-00-006-D
BY Carolyn
VOID AFTER 12609
3