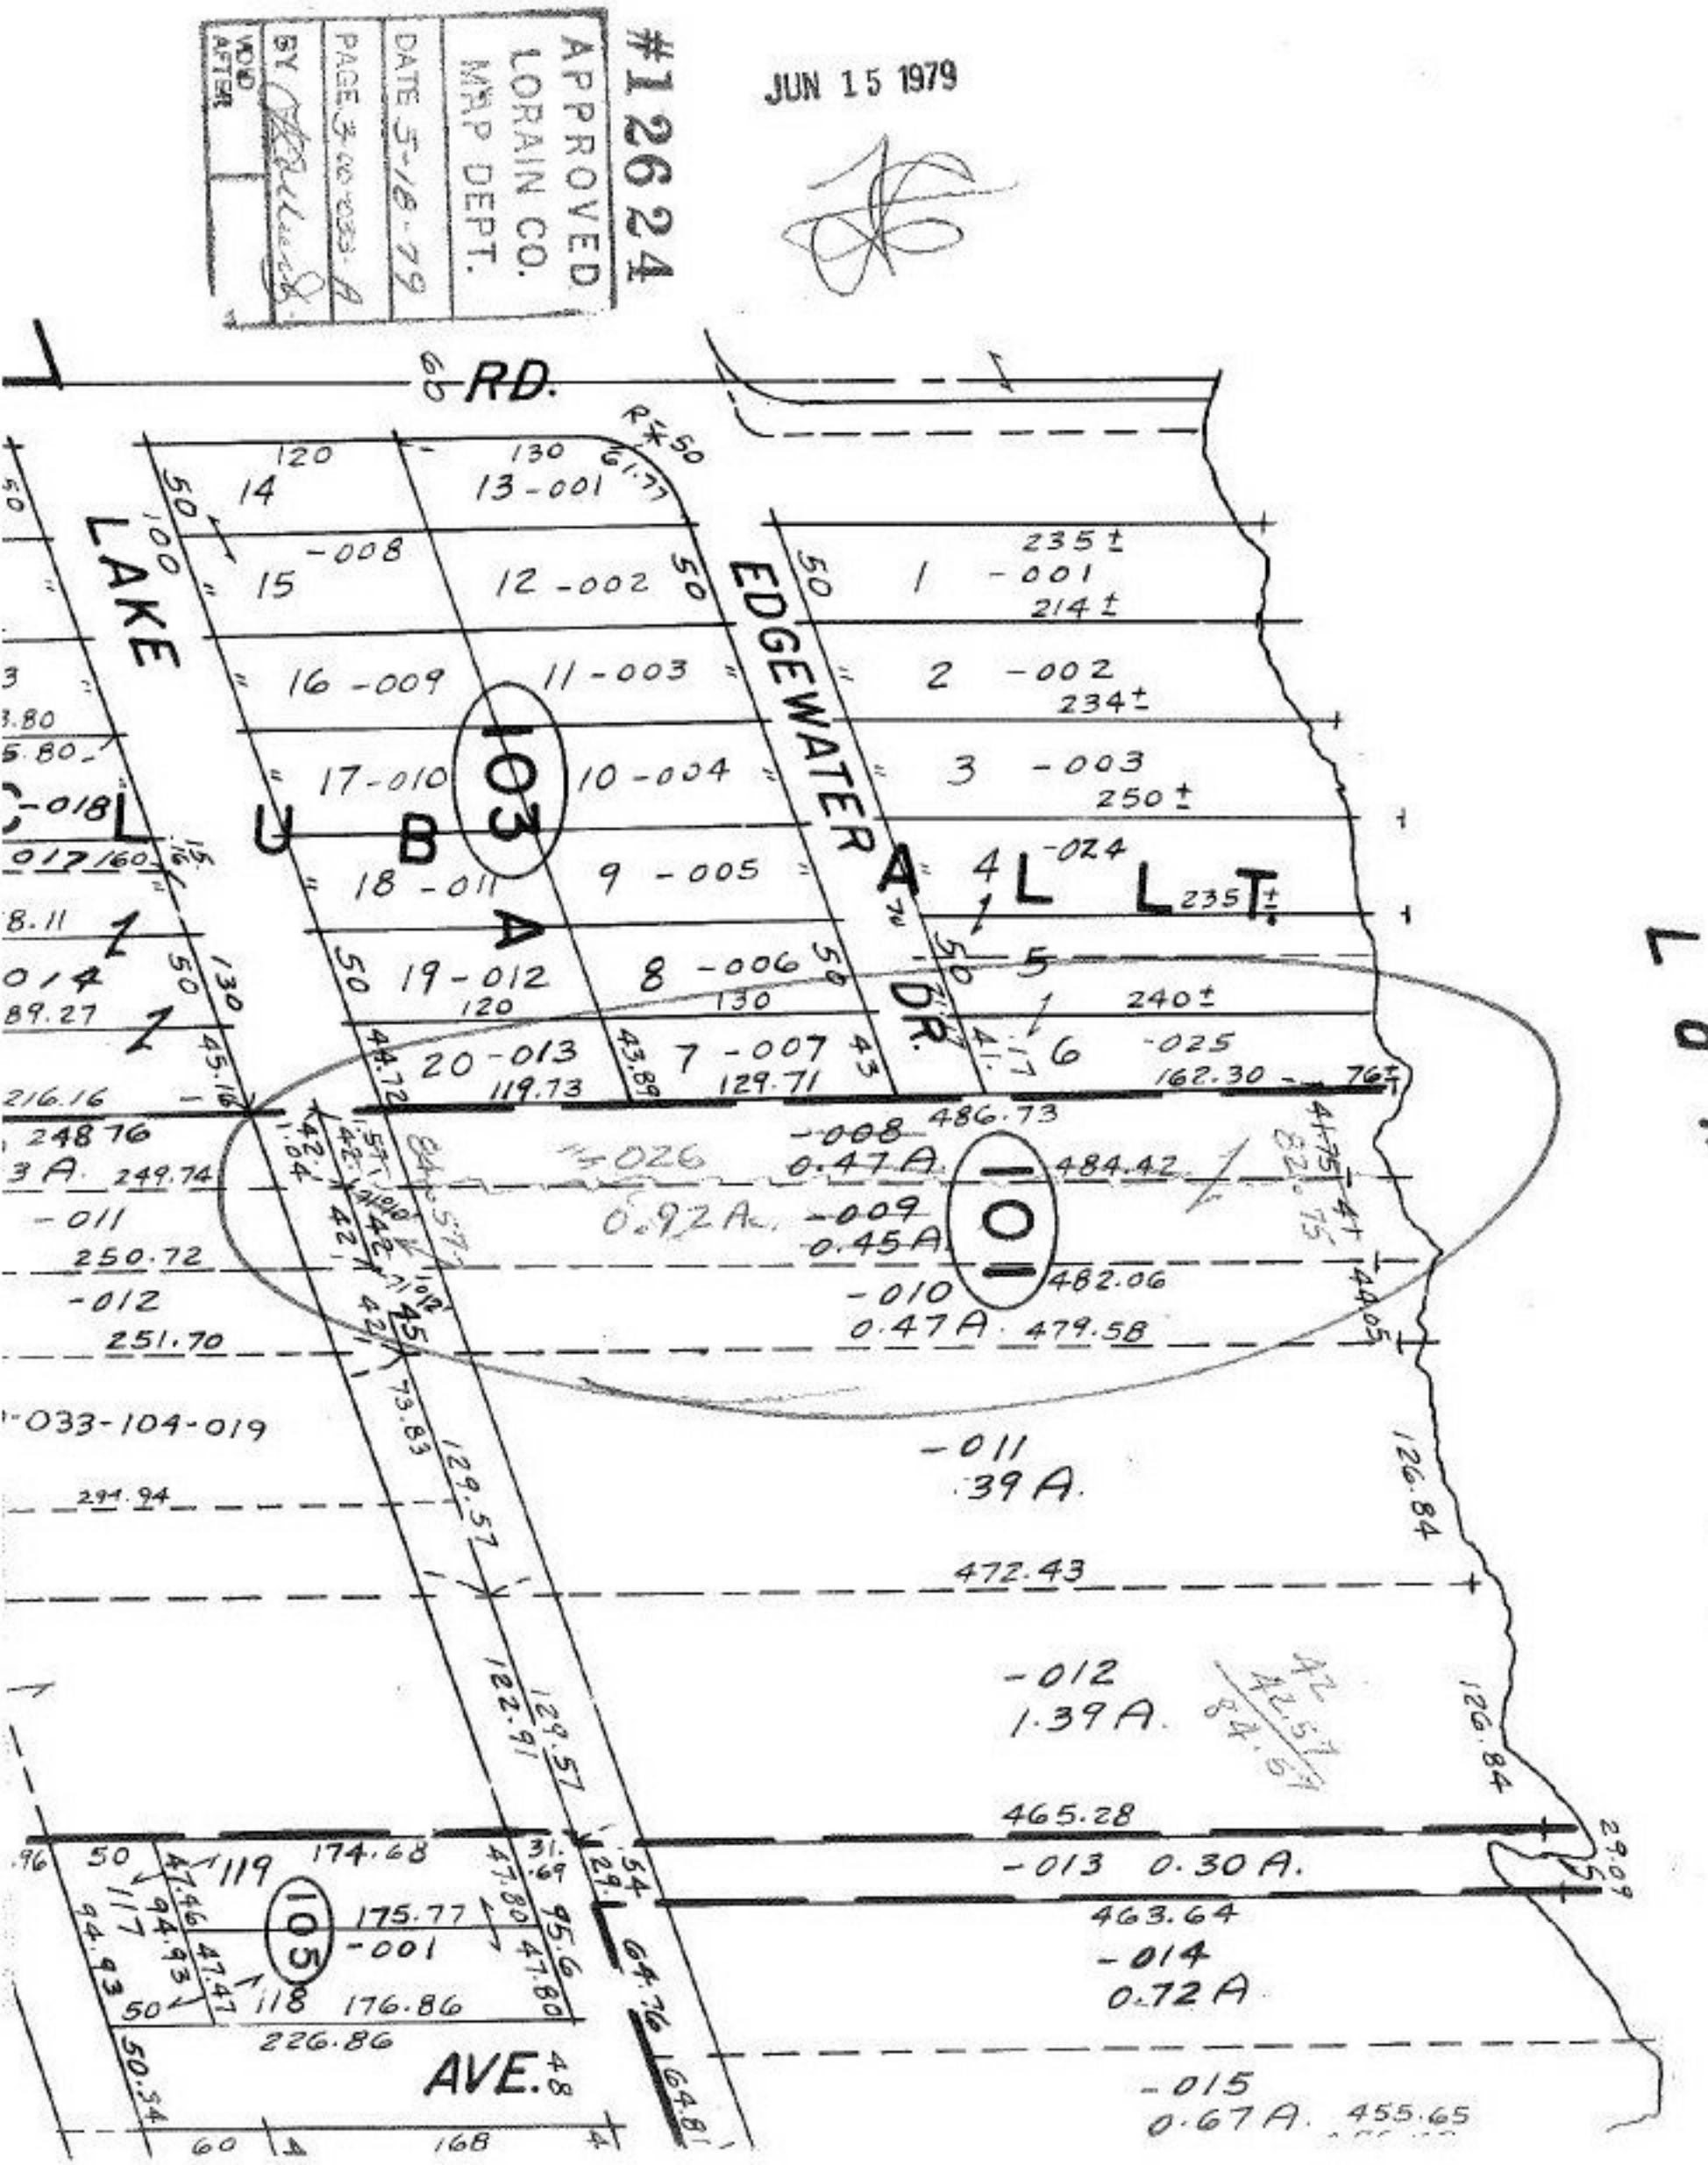

#12624
APPROVED
LORAIN CO.
MAP DEPT.
DATE 5-18-79
PAGE 3-00-033-A
BY
VOID AFTER
JUN 15 1979
RD.
LAKE
EDGEWATER
DR.
LUBA
AVE.
Lake
103
101
105
14
13-001
15-008
12-002
16-009
11-003
17-010
10-004
18-011
9-005
19-012
8-006
20-013
7-007
1 -001
2 -002
3 -003
4 -024
5
6 -025
-008
0.47A
-009
0.45A
-010
0.47A
-011
.39A
-012
1.39A
-013 0.30A
-014
0.72A
-015
0.67A
-026
0.92A
-033-104-019
-001
-018
-011
-012
-013
-014
-015