-037-A

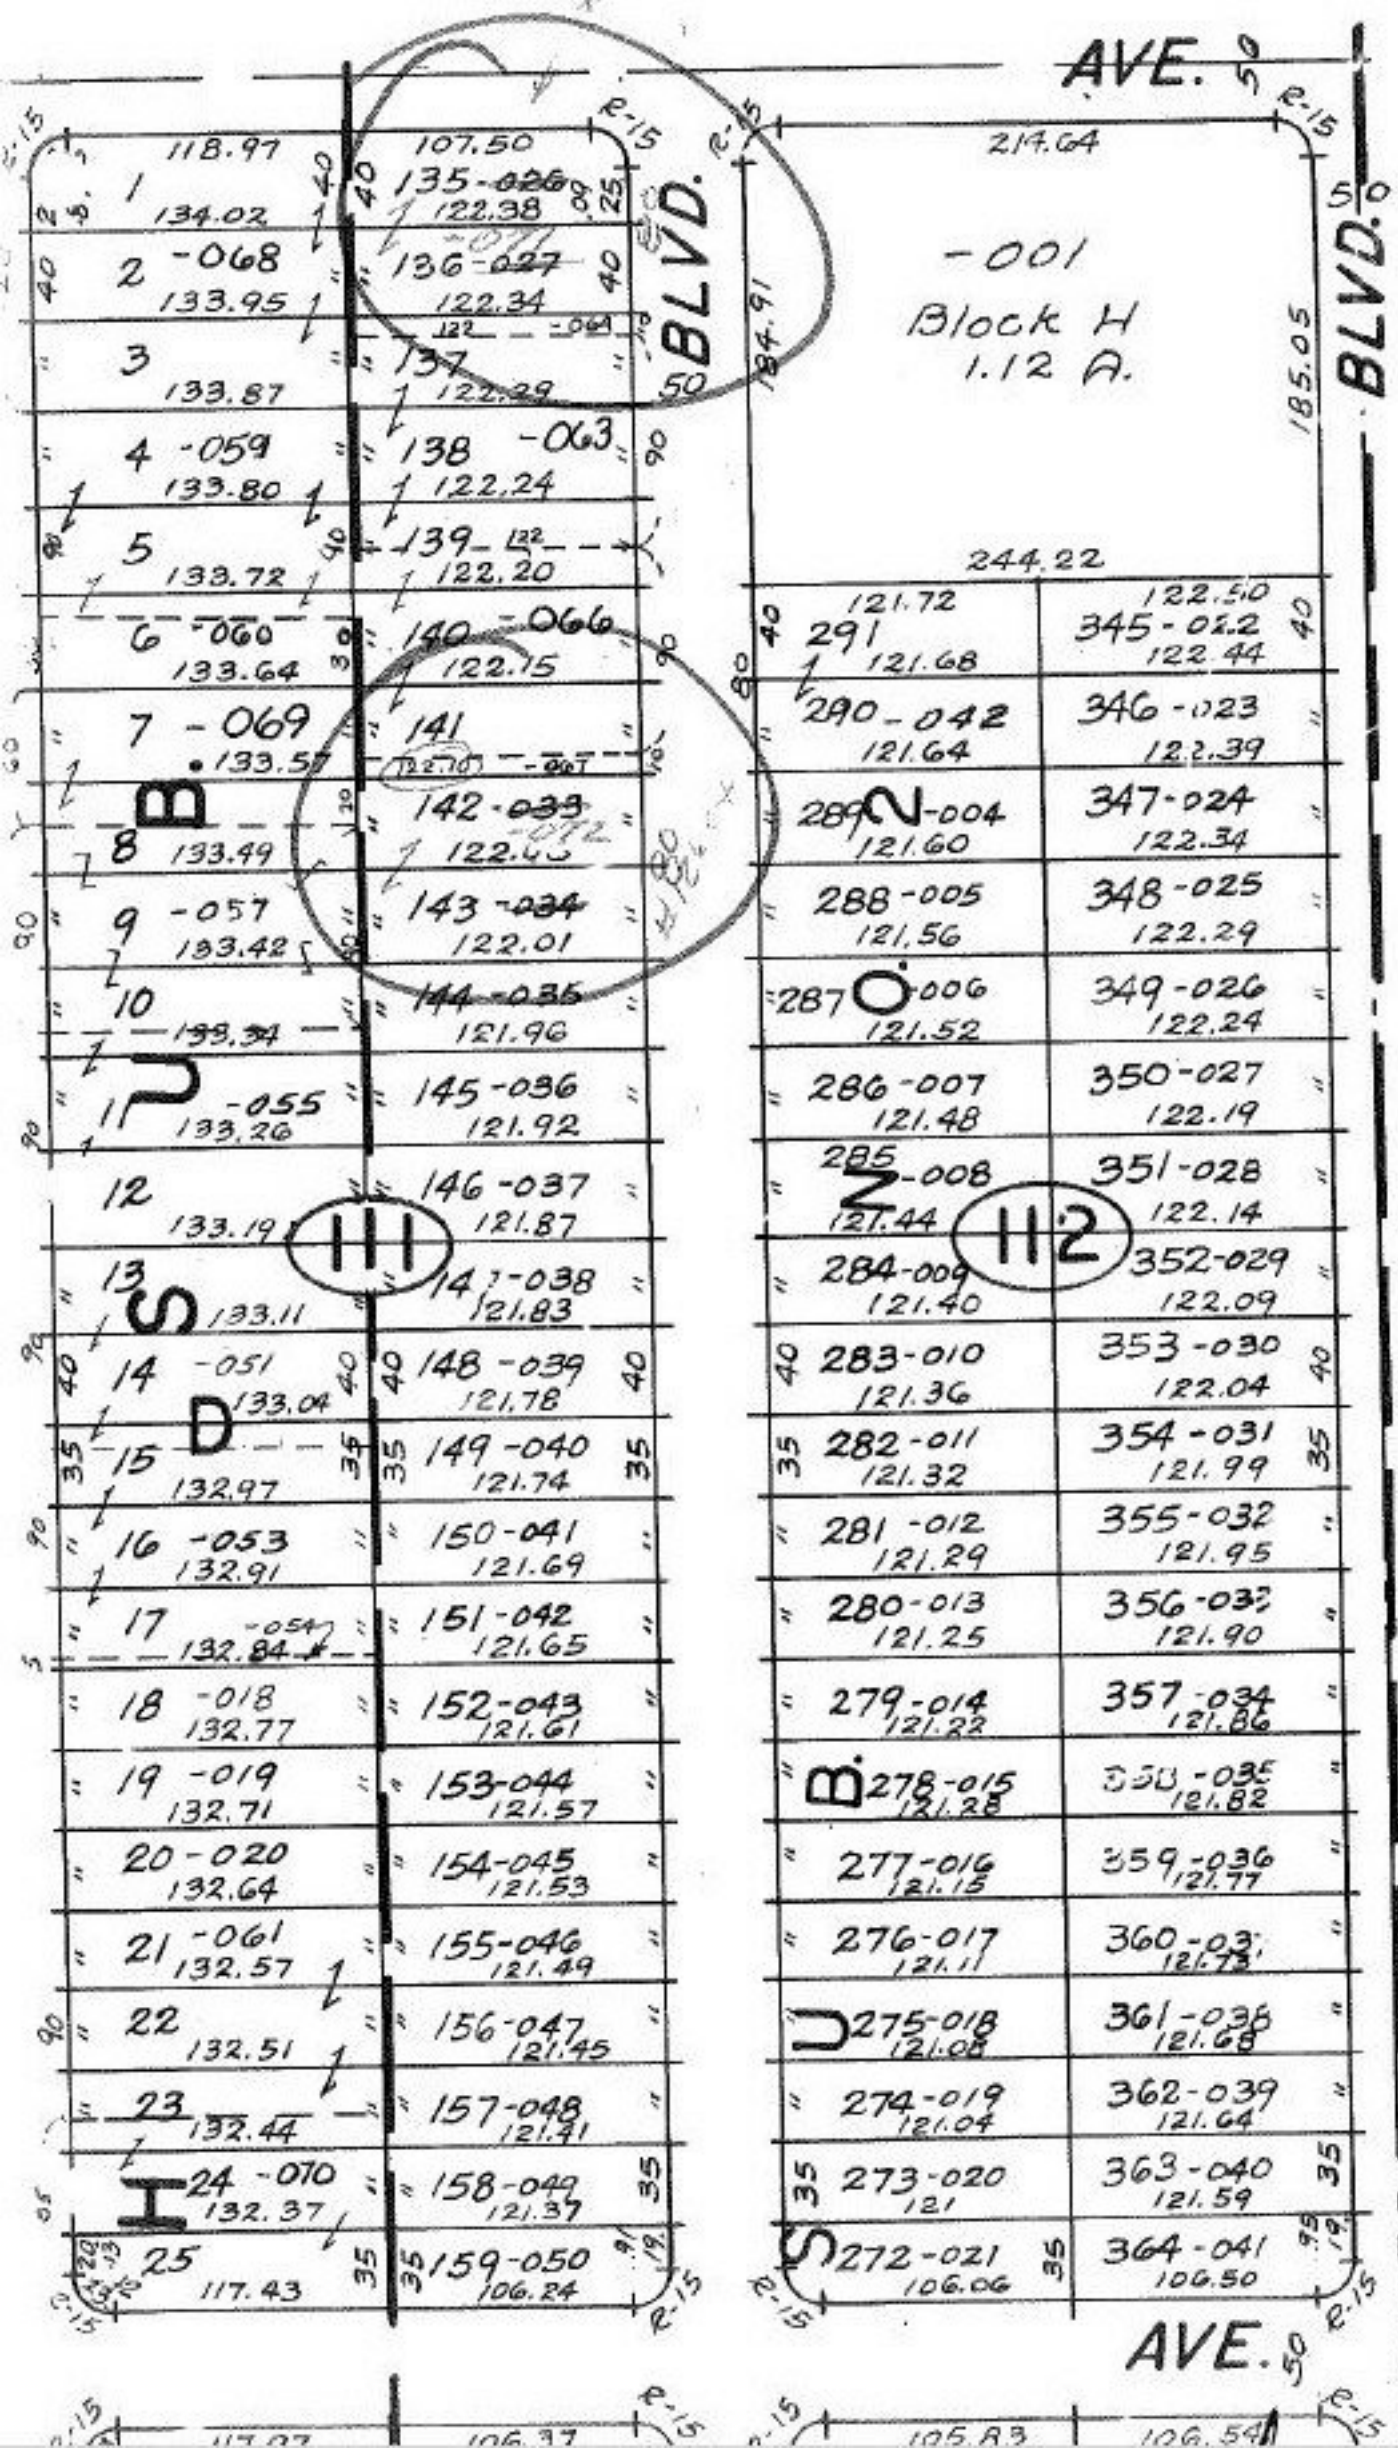

JUN 15 1979

#12624

APPROVED
LORAIN CO.
MAP DEPT.

DATE 5-18-79

PAGE 3-00-037-B

BY

VOID AFTER