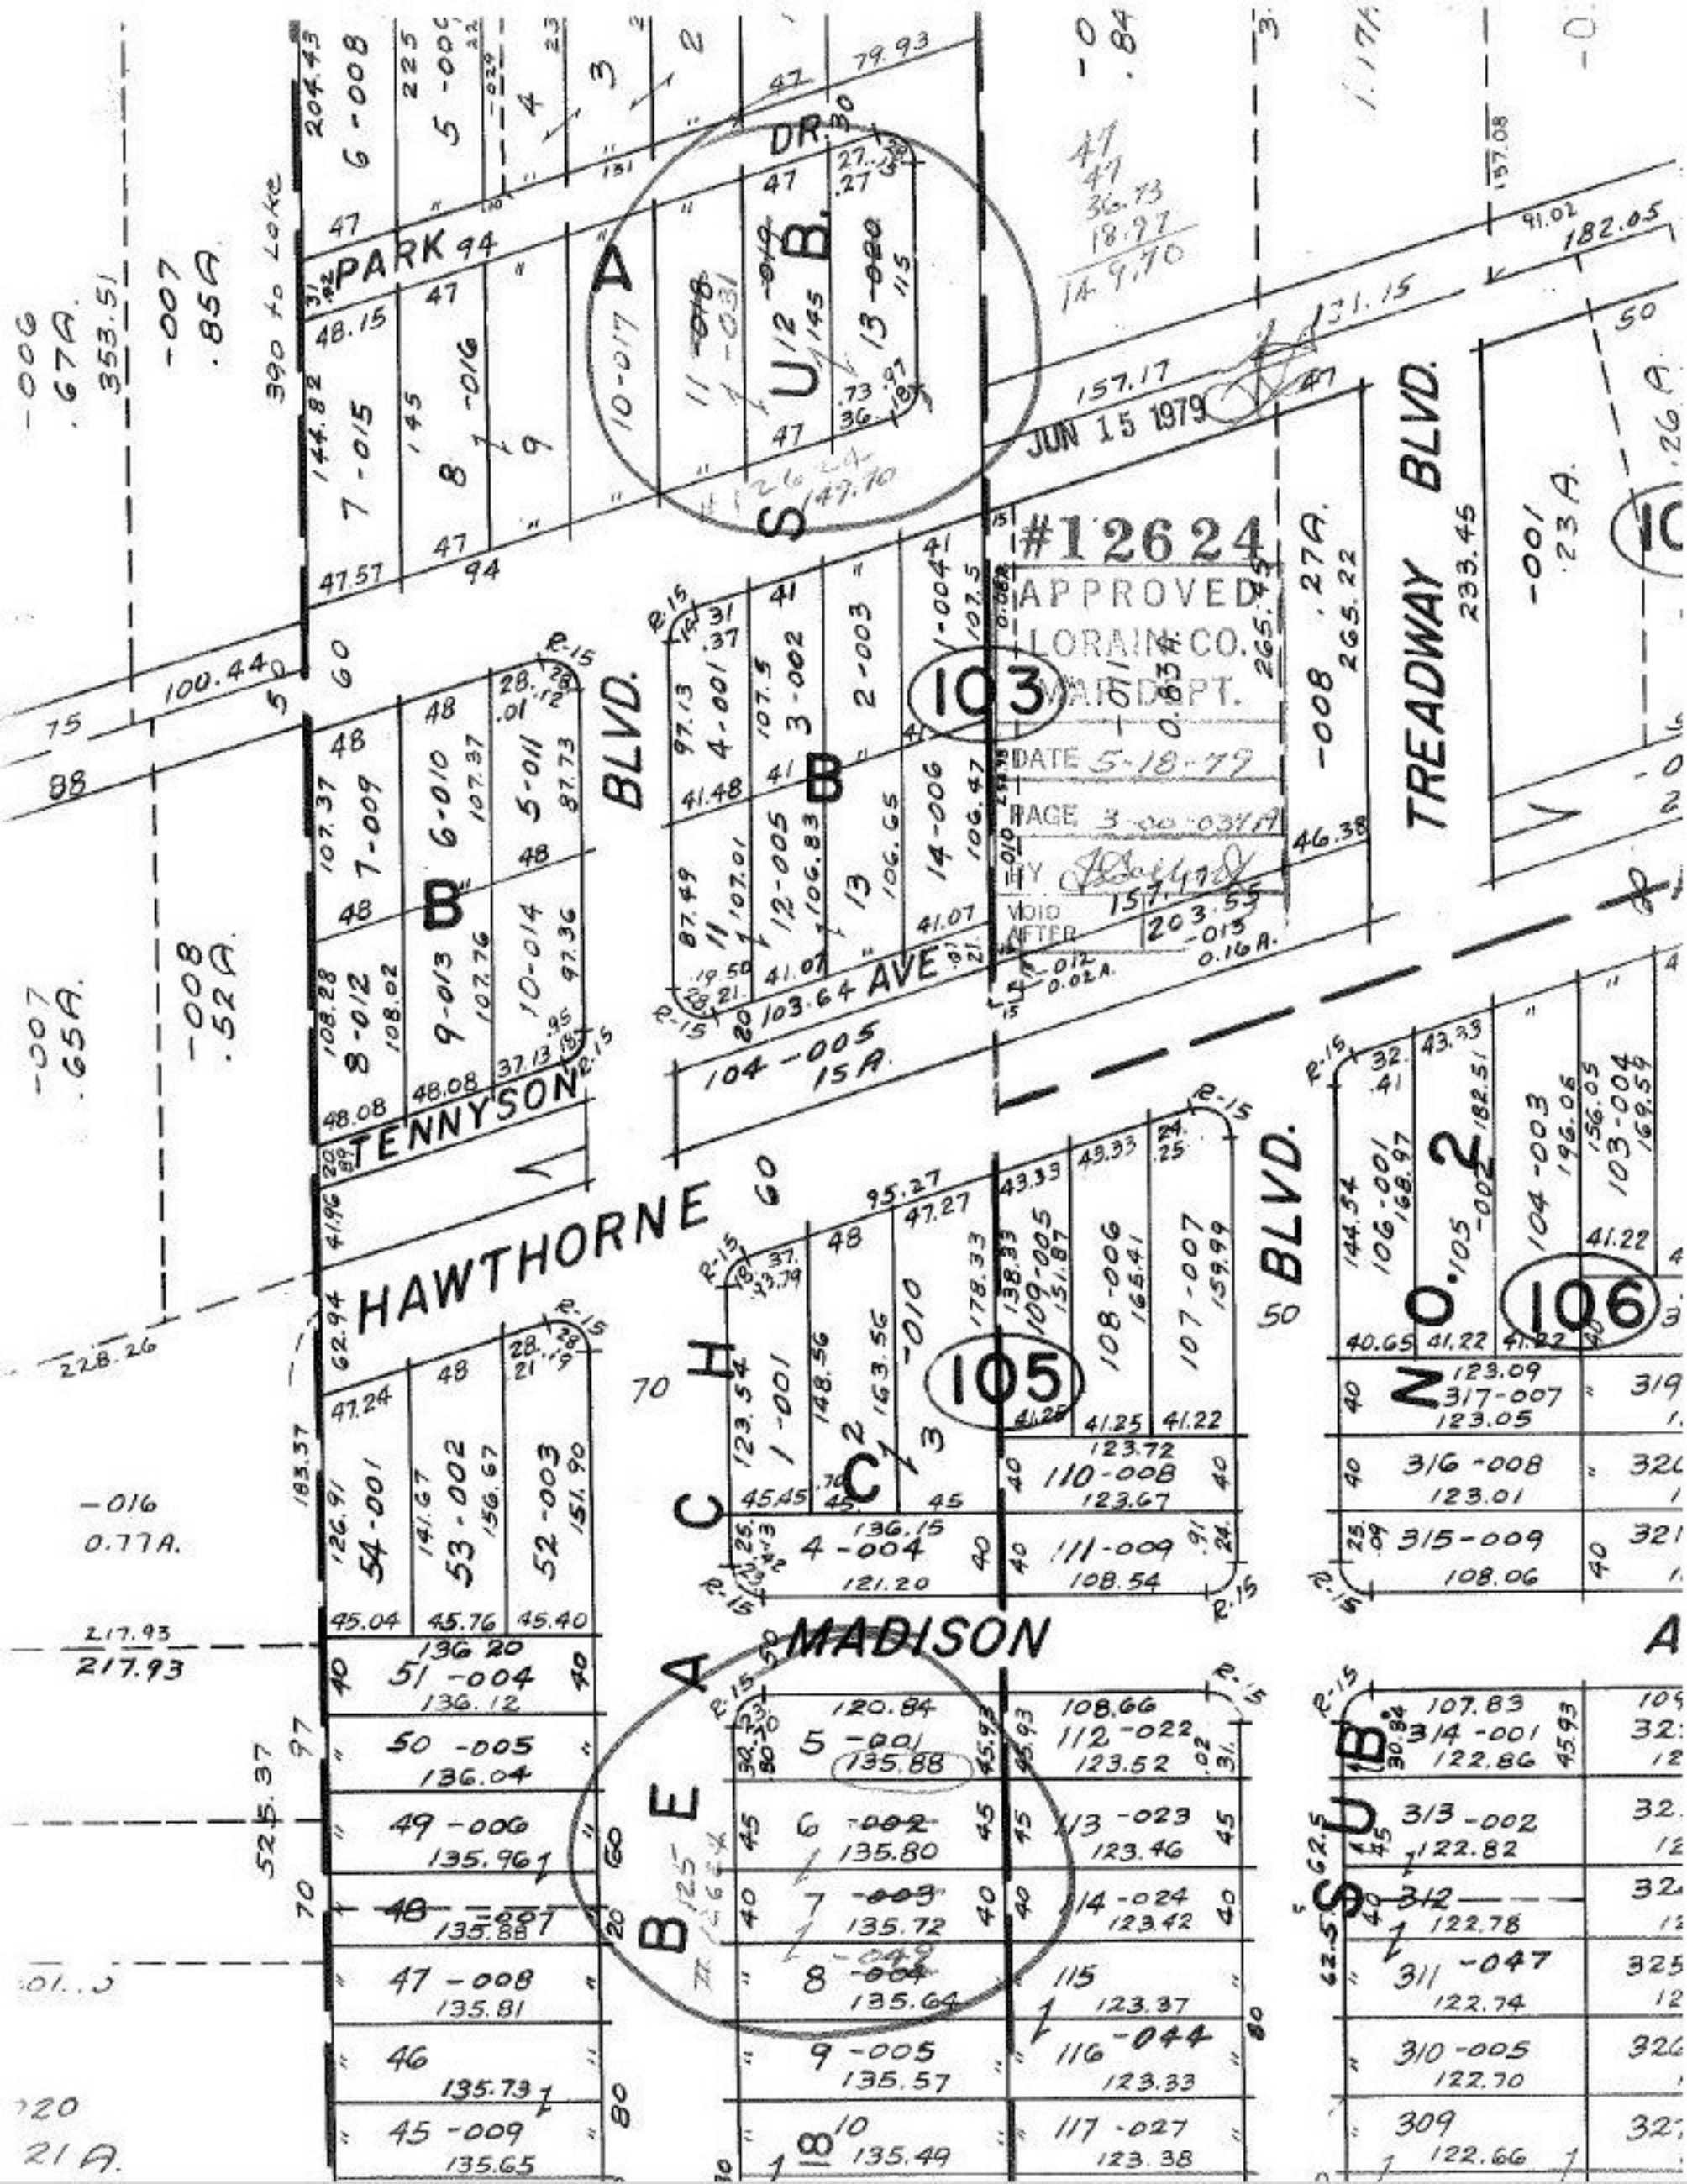

#12624
APPROVED
LORAIN CO.
MAP DEPT.
DATE 5-18-79
PAGE 3-00-034A
BY
VOID AFTER
JUN 15 1979
PARK DR.
TENNYSON BLVD.
HAWTHORNE AVE
MADISON BLVD.
TREADWAY BLVD.
SUB. A
SUB. B
103
105
106