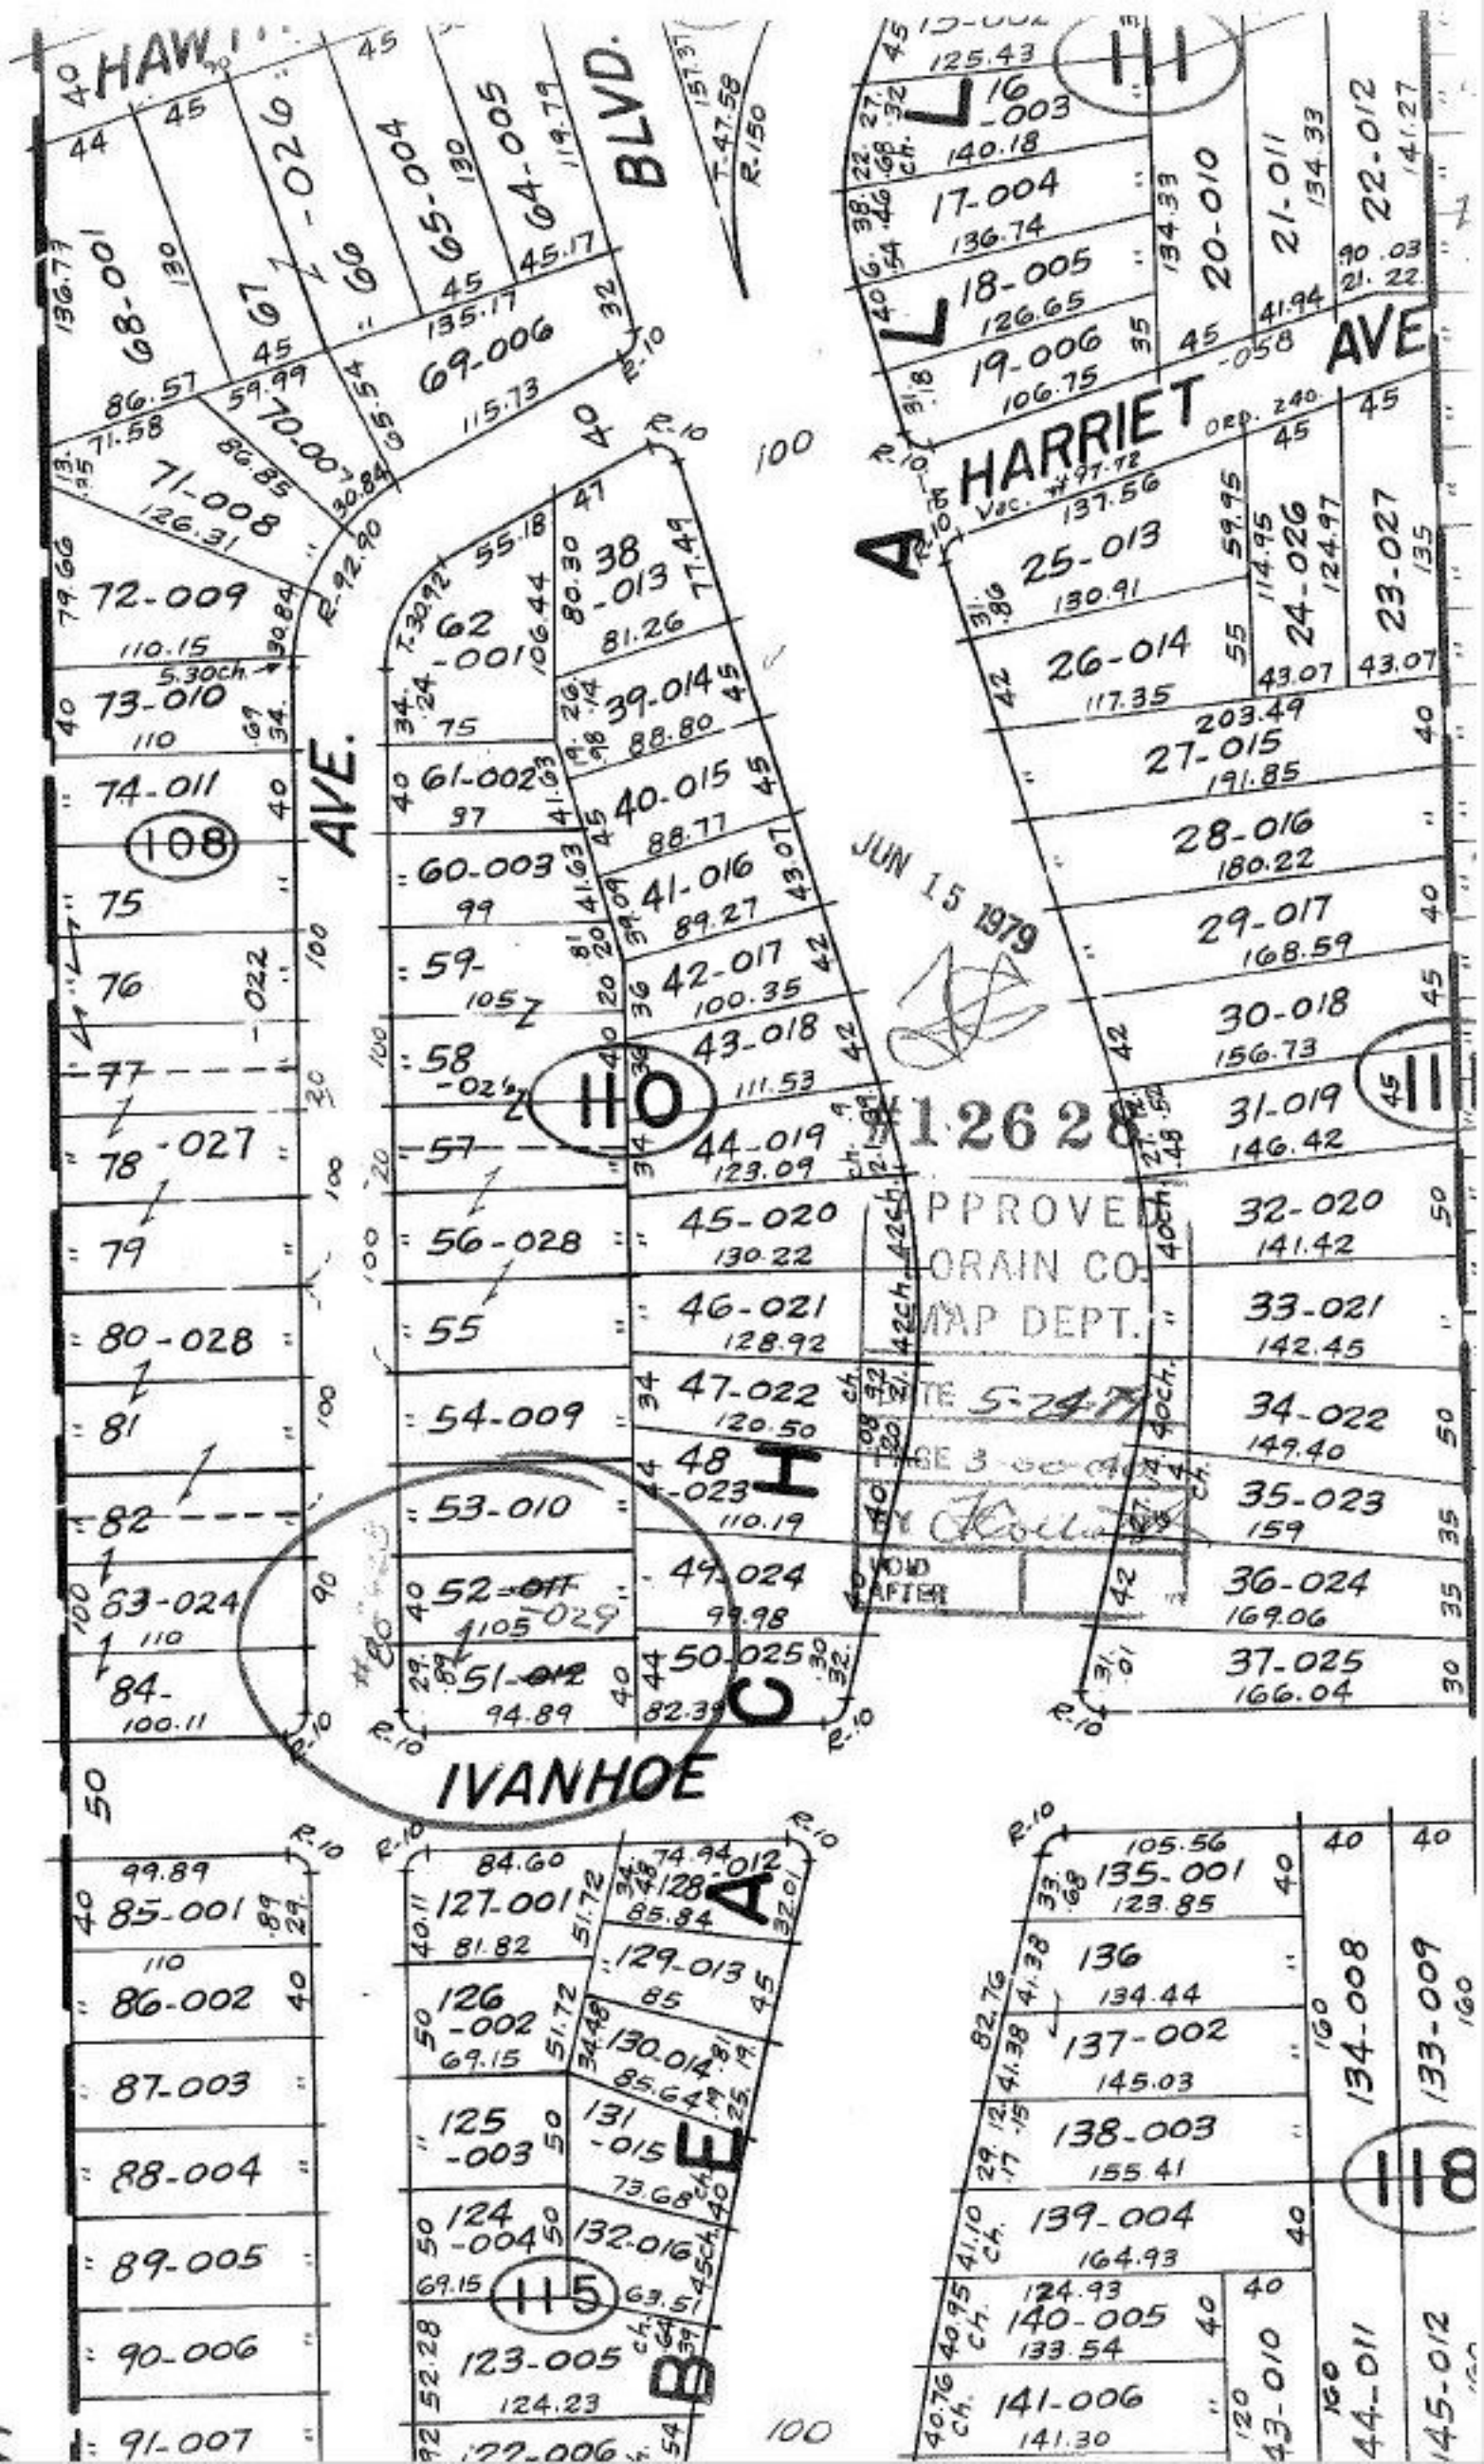
HAWTH
BLVD.
AVE.
HARRIET
AVE
IVANHOE
108
110
111
115
118
JUN 15 1979
#12628
APPROVED
ORAIN CO.
MAP DEPT.
DATE 5-24-79
PAGE 3-00-40
BY
VOID AFTER
68-001
67-026
66
65-004
64-005
69-006
70-007
71-008
72-009
73-010
74-011
75
76
77
78-027
79
80-028
81
82
83-024
84-
85-001
86-002
87-003
88-004
89-005
90-006
91-007
62-001
61-002
60-003
59-
58-
57
56-028
55
54-009
53-010
52-029
51-012
38-013
39-014
40-015
41-016
42-017
43-018
44-019
45-020
46-021
47-022
48-023
49-024
50-025
127-001
126-002
125-003
124-004
123-005
122-006
128-012
129-013
130-014
131-015
132-016
16-003
17-004
18-005
19-006
20-010
21-011
22-012
25-013
26-014
27-015
28-016
29-017
30-018
31-019
32-020
33-021
34-022
35-023
36-024
37-025
135-001
136
137-002
138-003
139-004
140-005
141-006
134-008
133-009
144-011
145-012
100