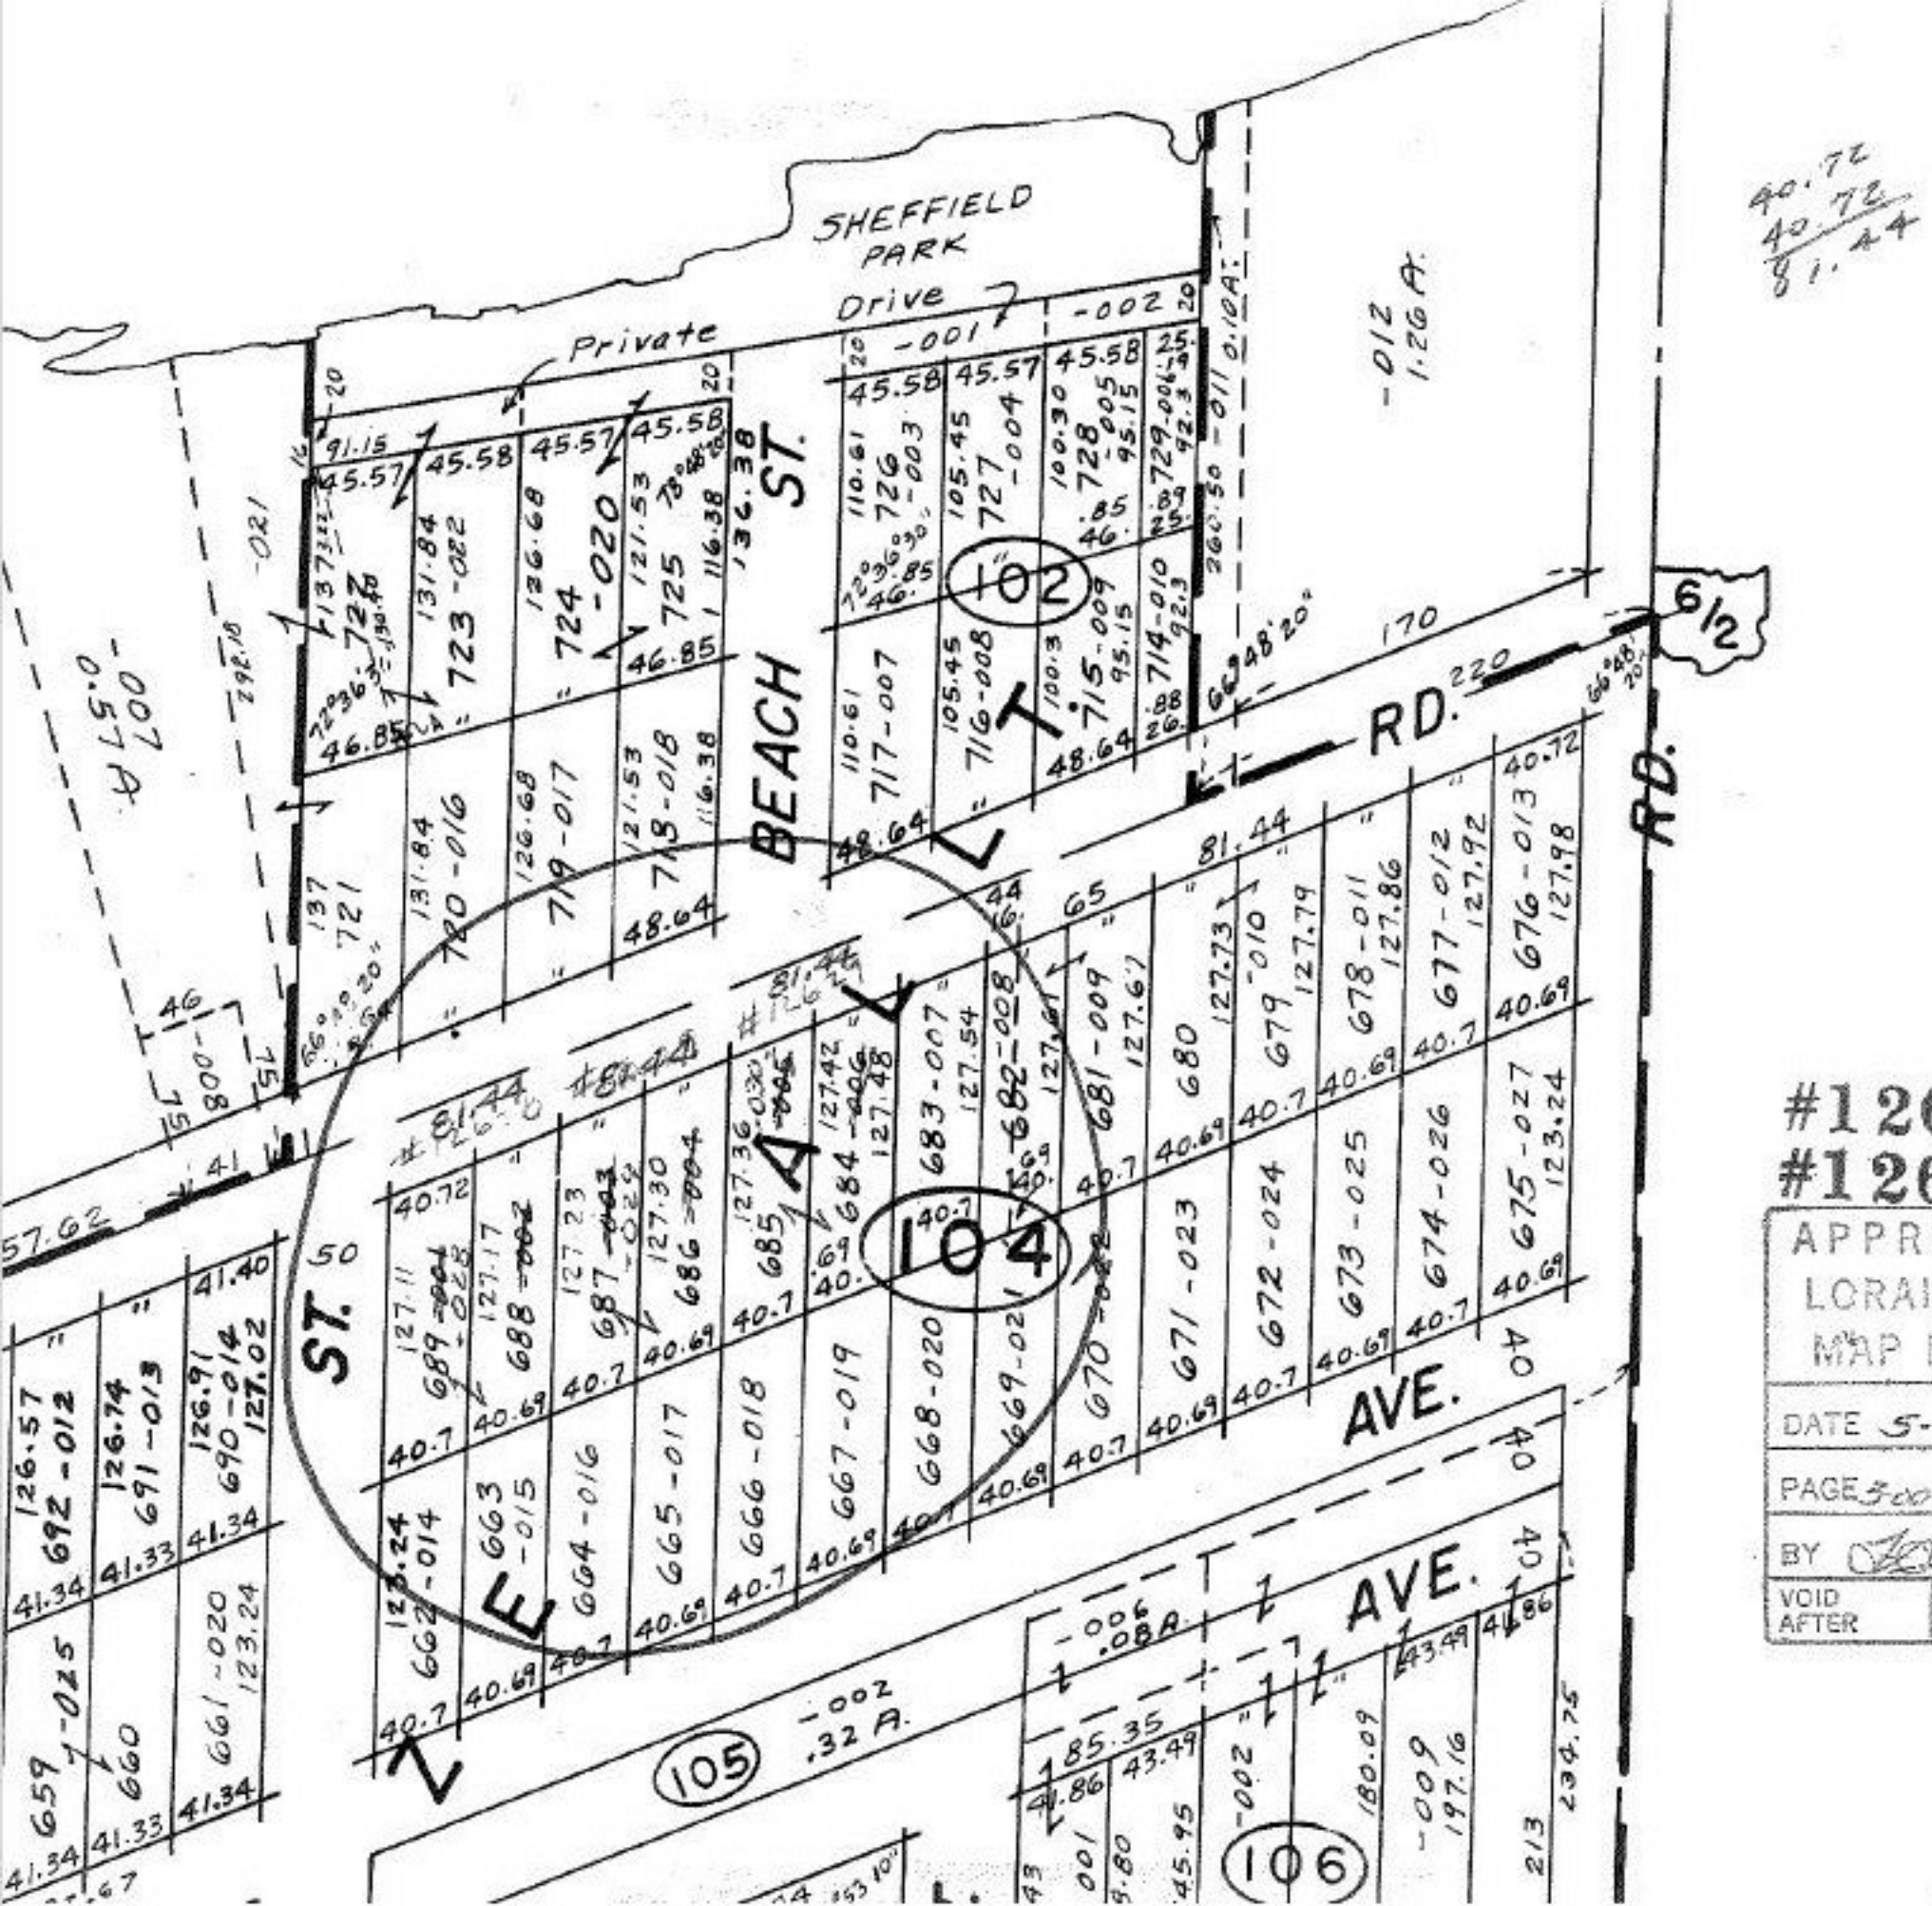

#12628
#12629

APPROVED
LORAIN CO.
MAP DEPT.
DATE 5-24-79
PAGE 300-042 A
BY
VOID AFTER

JUN 15 1979