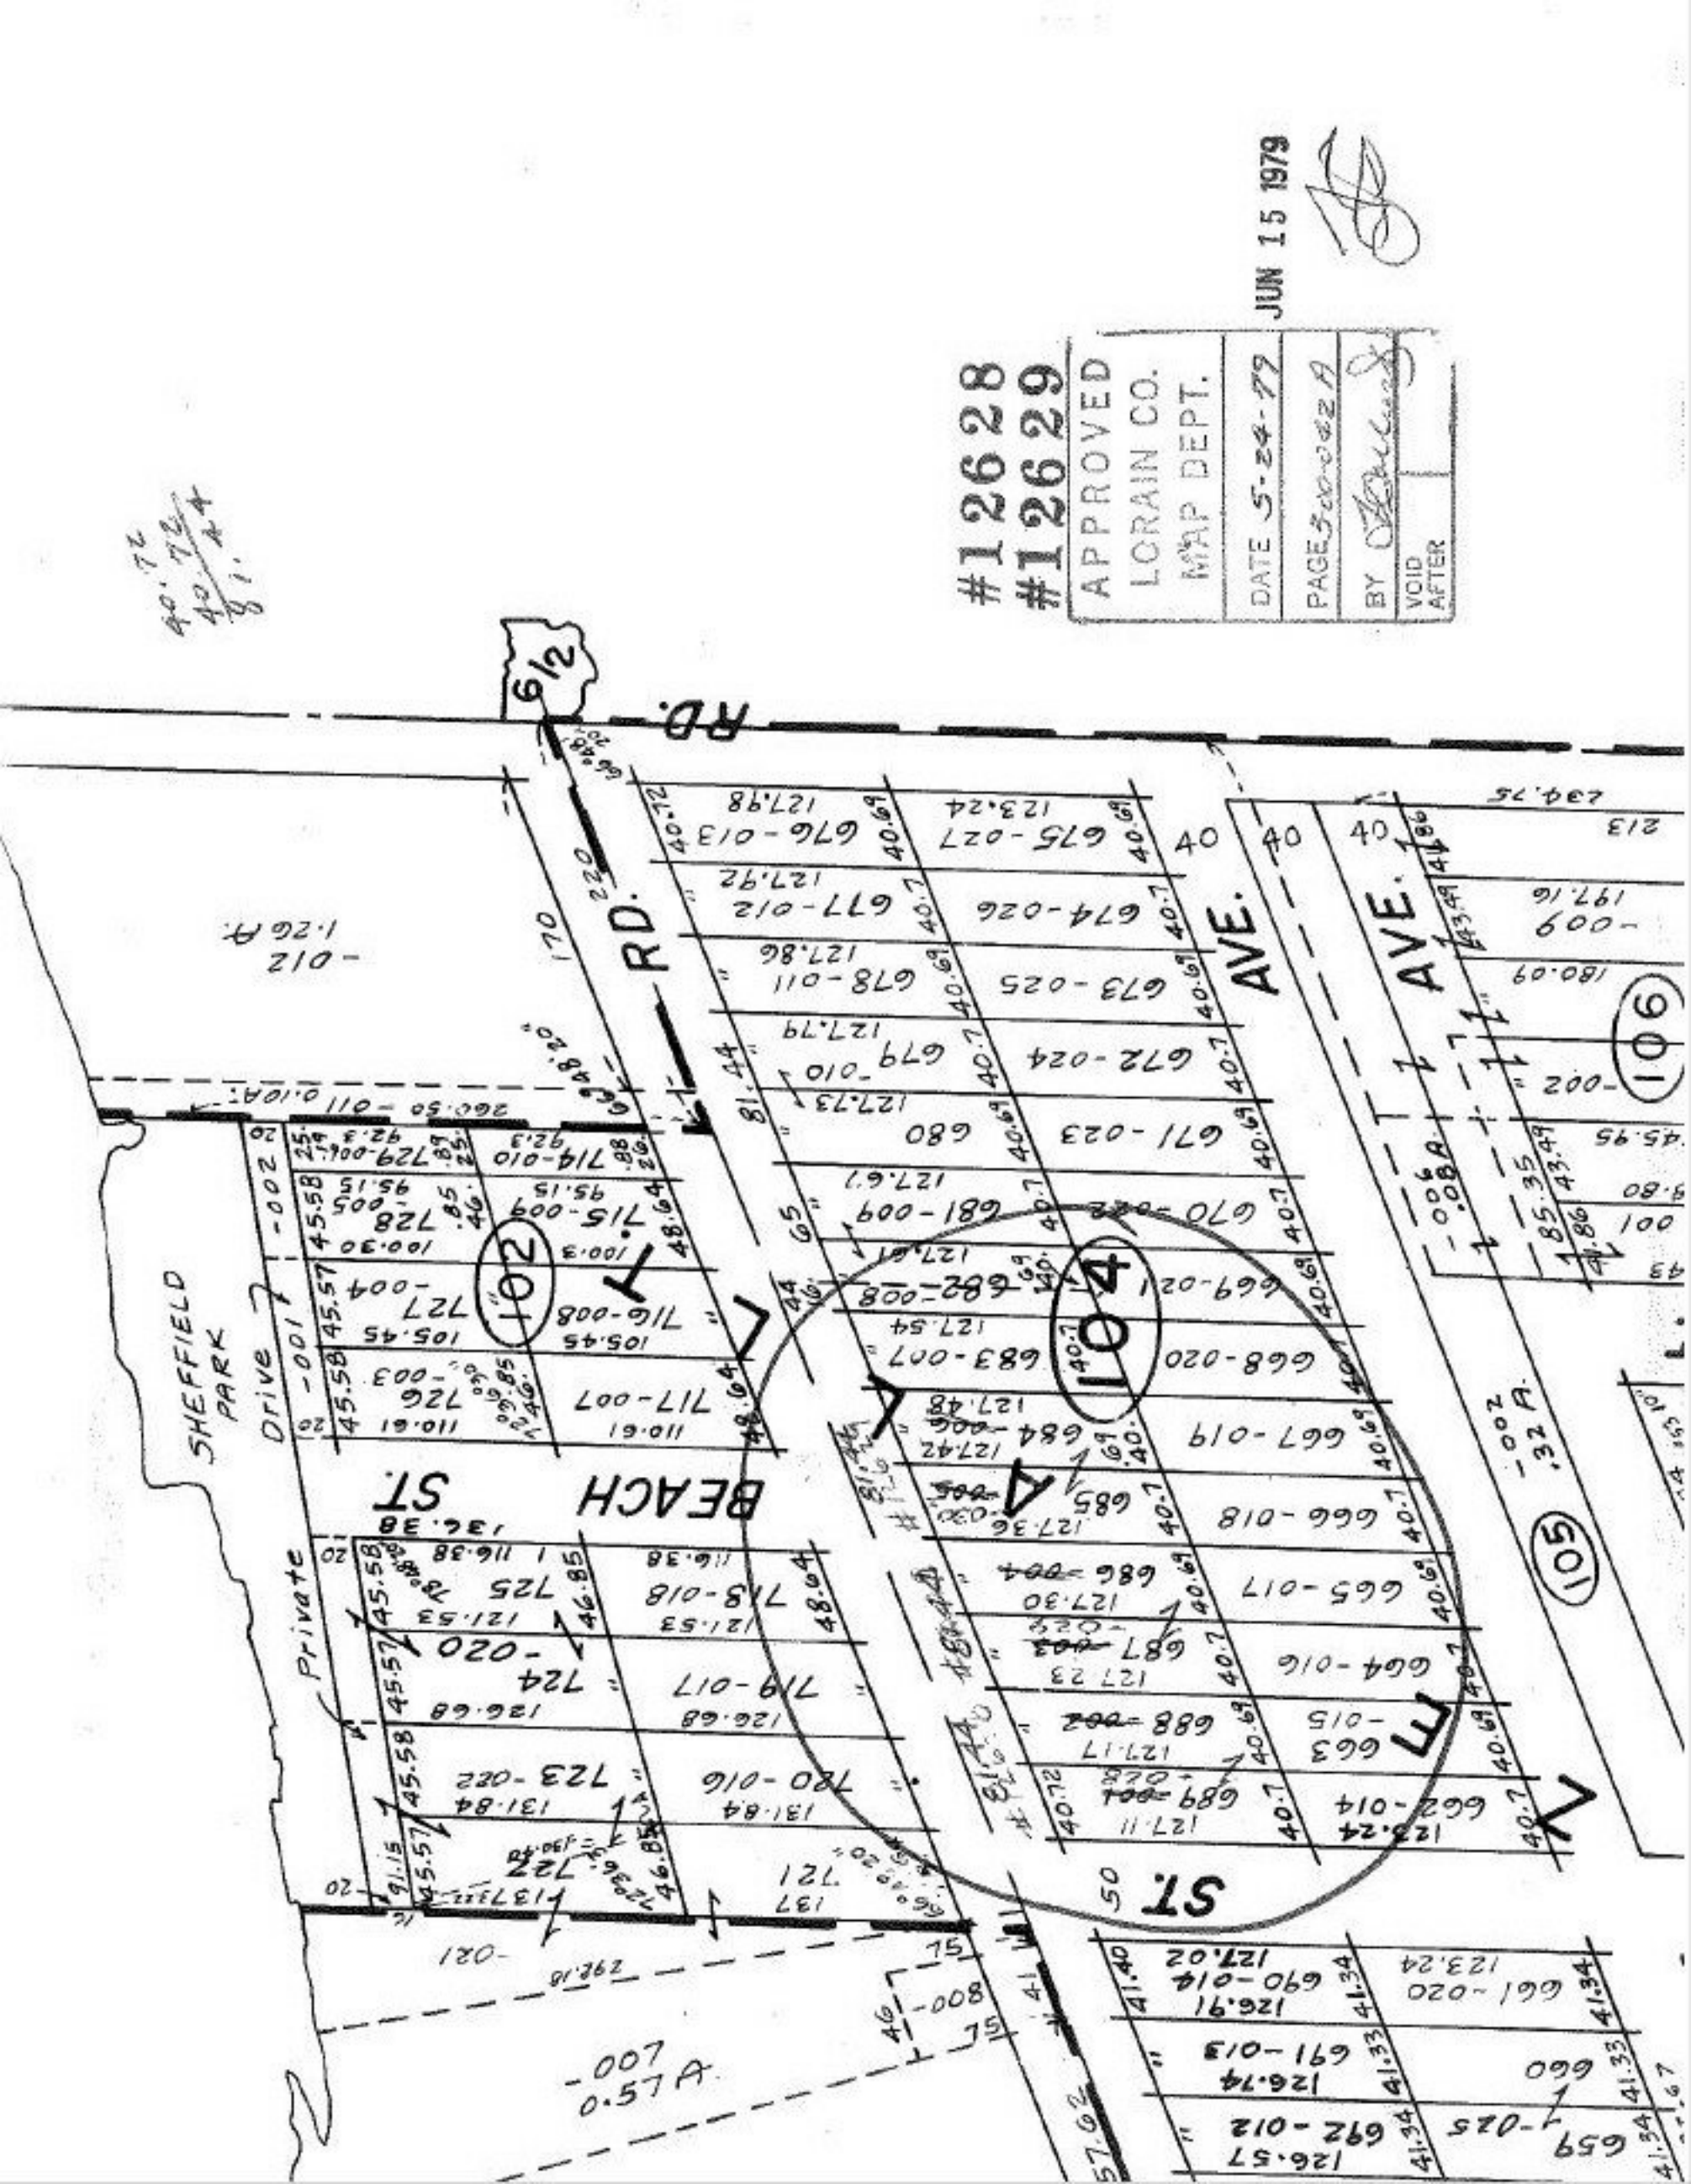

#12628
#12629
APPROVED
LORAIN CO.
MAP DEPT.
DATE 5-24-79
PAGE 300-042A
BY
VOID AFTER
JUN 15 1979
RD.
RD.
AVE.
AVE.
BEACH ST.
ST.
SHEFFIELD PARK
Drive
Private
102
104
105
106