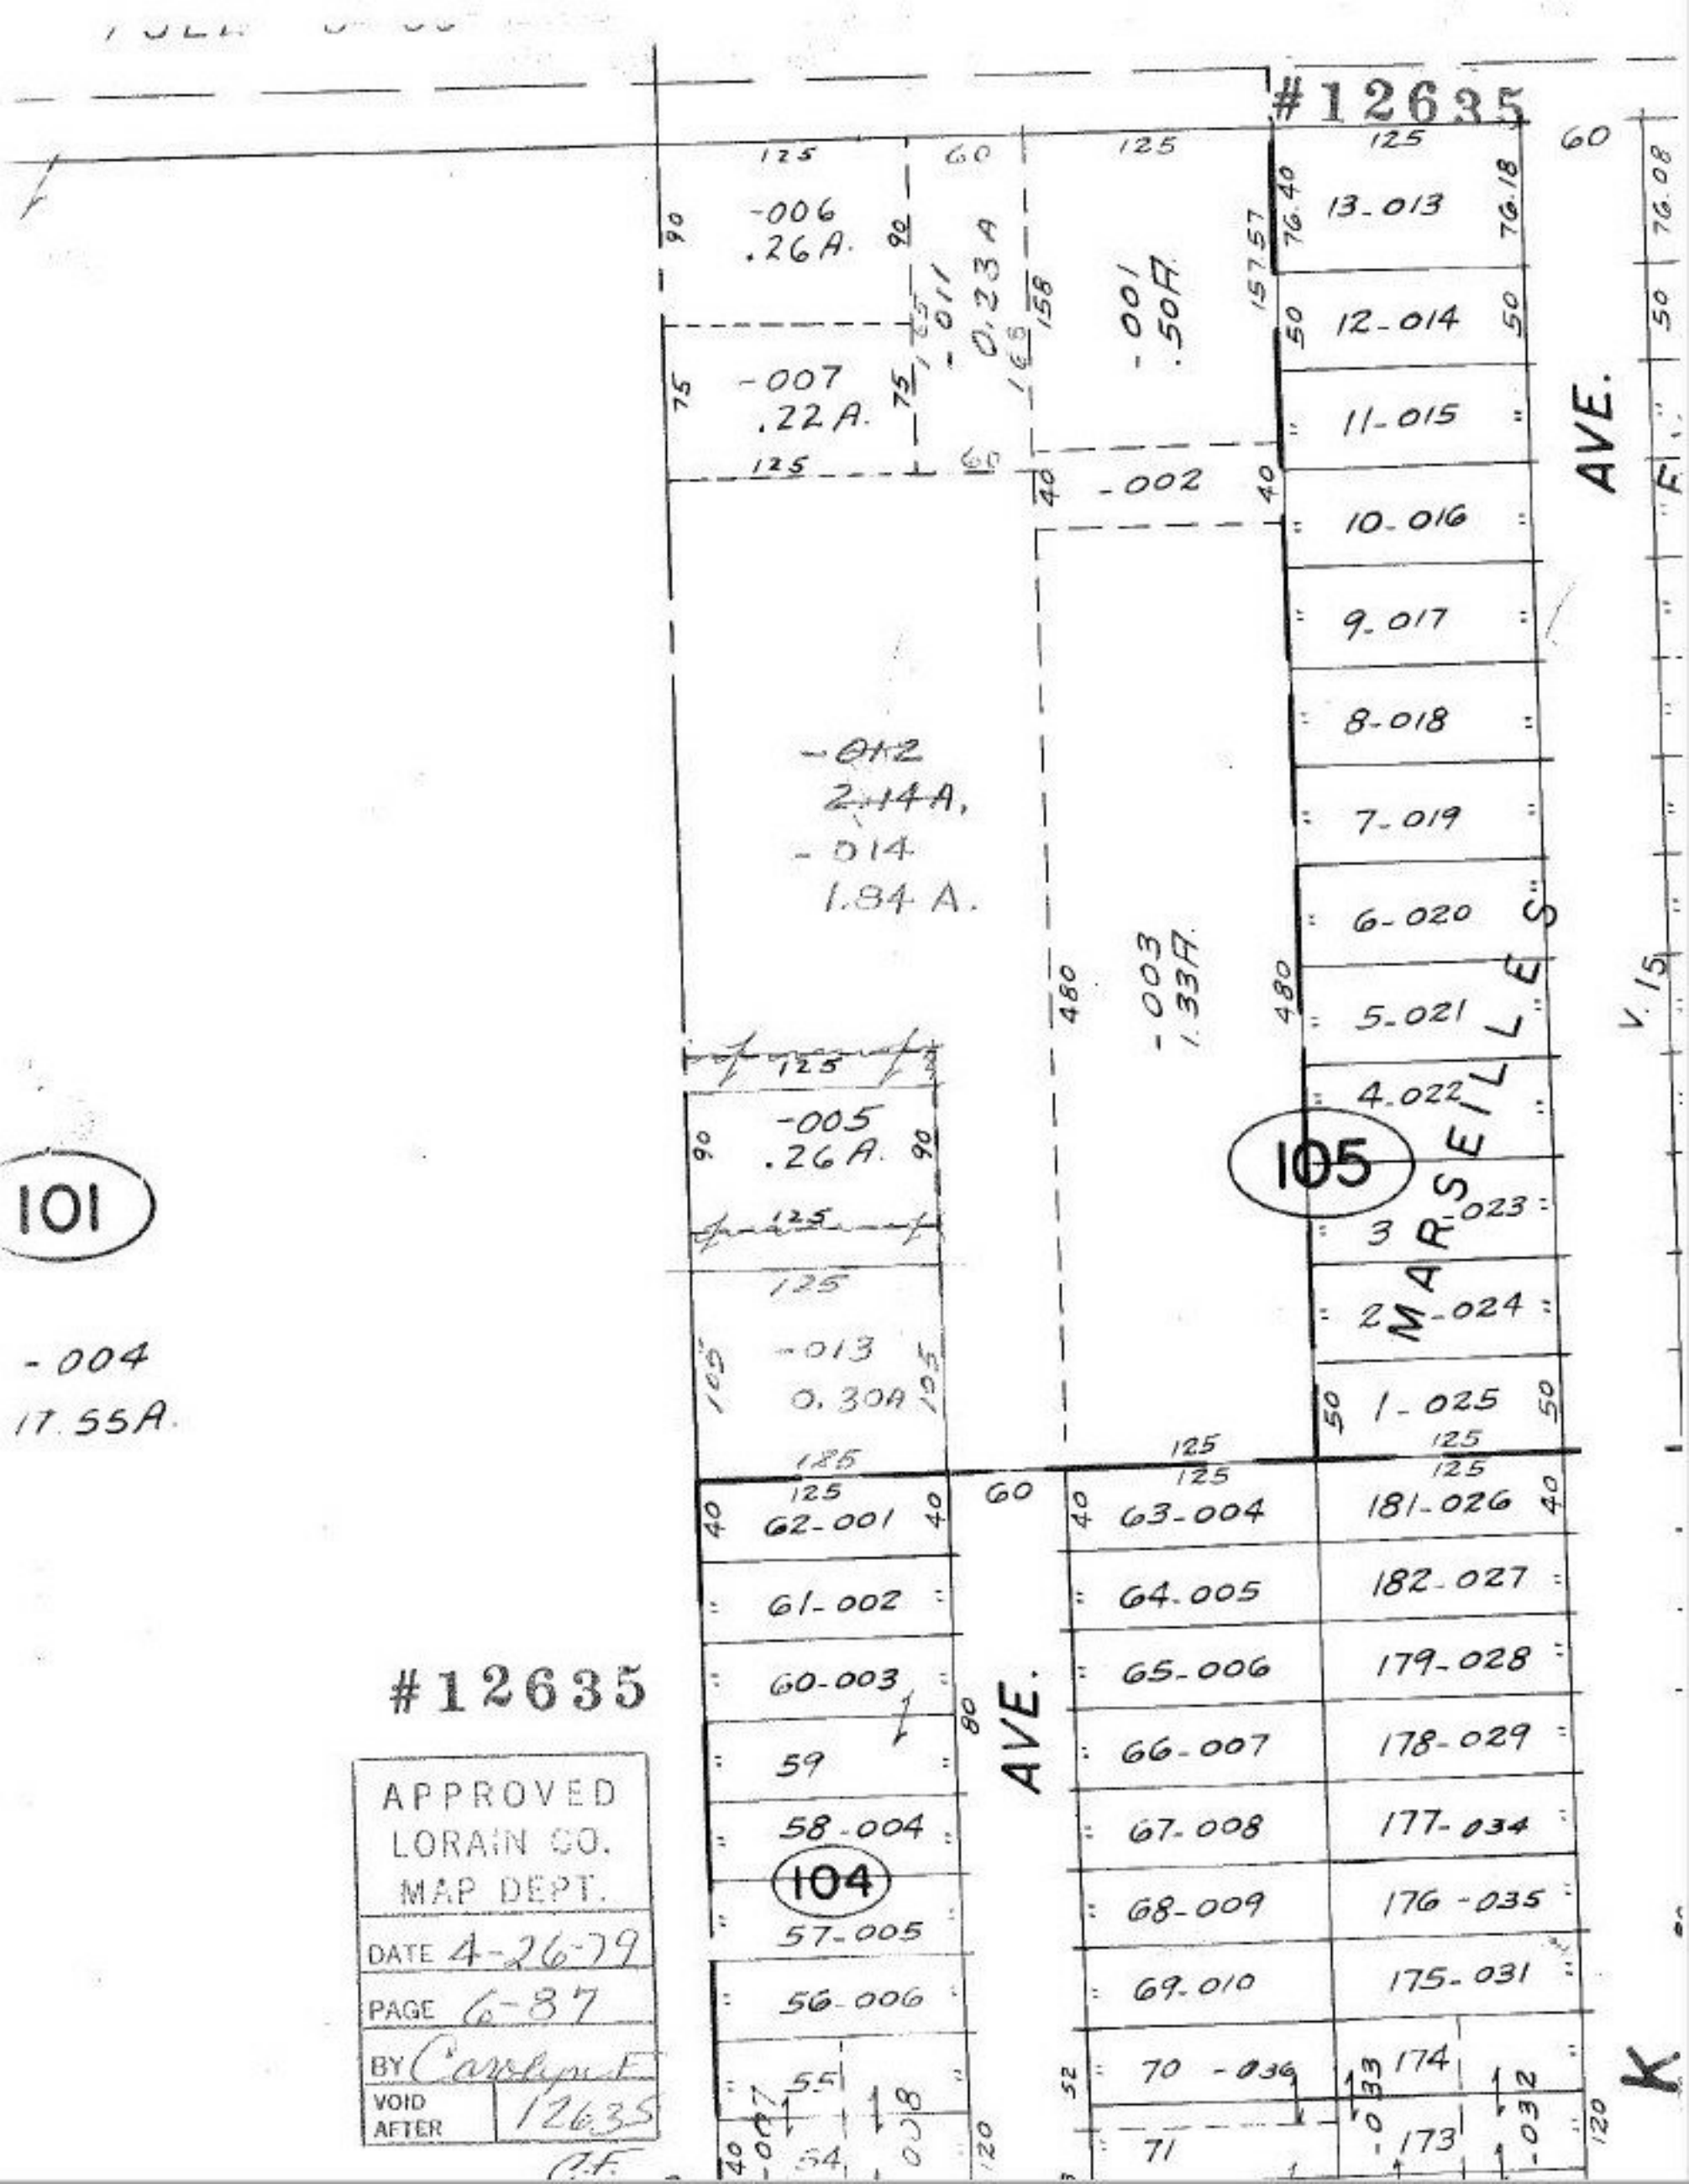
#12635
-006
.26A.
-007
.22A.
-011
0.23A
-001
.50A
-002
-012
2.14A.
-014
1.84 A.
-003
1.33A.
-005
.26A.
-013
0.30A
-004
17.55A.
13-013
12-014
11-015
10-016
9-017
8-018
7-019
6-020
5-021
4-022
3-023
2-024
1-025
MARSEILLES AVE.
105
101
62-001
61-002
60-003
59
58-004
104
57-005
56-006
55
54
63-004
64-005
65-006
66-007
67-008
68-009
69-010
70-036
71
181-026
182-027
179-028
178-029
177-034
176-035
175-031
174
173
AVE.
V.15
#12635
APPROVED
LORAIN CO.
MAP DEPT.
DATE 4-26-79
PAGE 6-87
BY Carolyn F
VOID AFTER 12635
C.F.