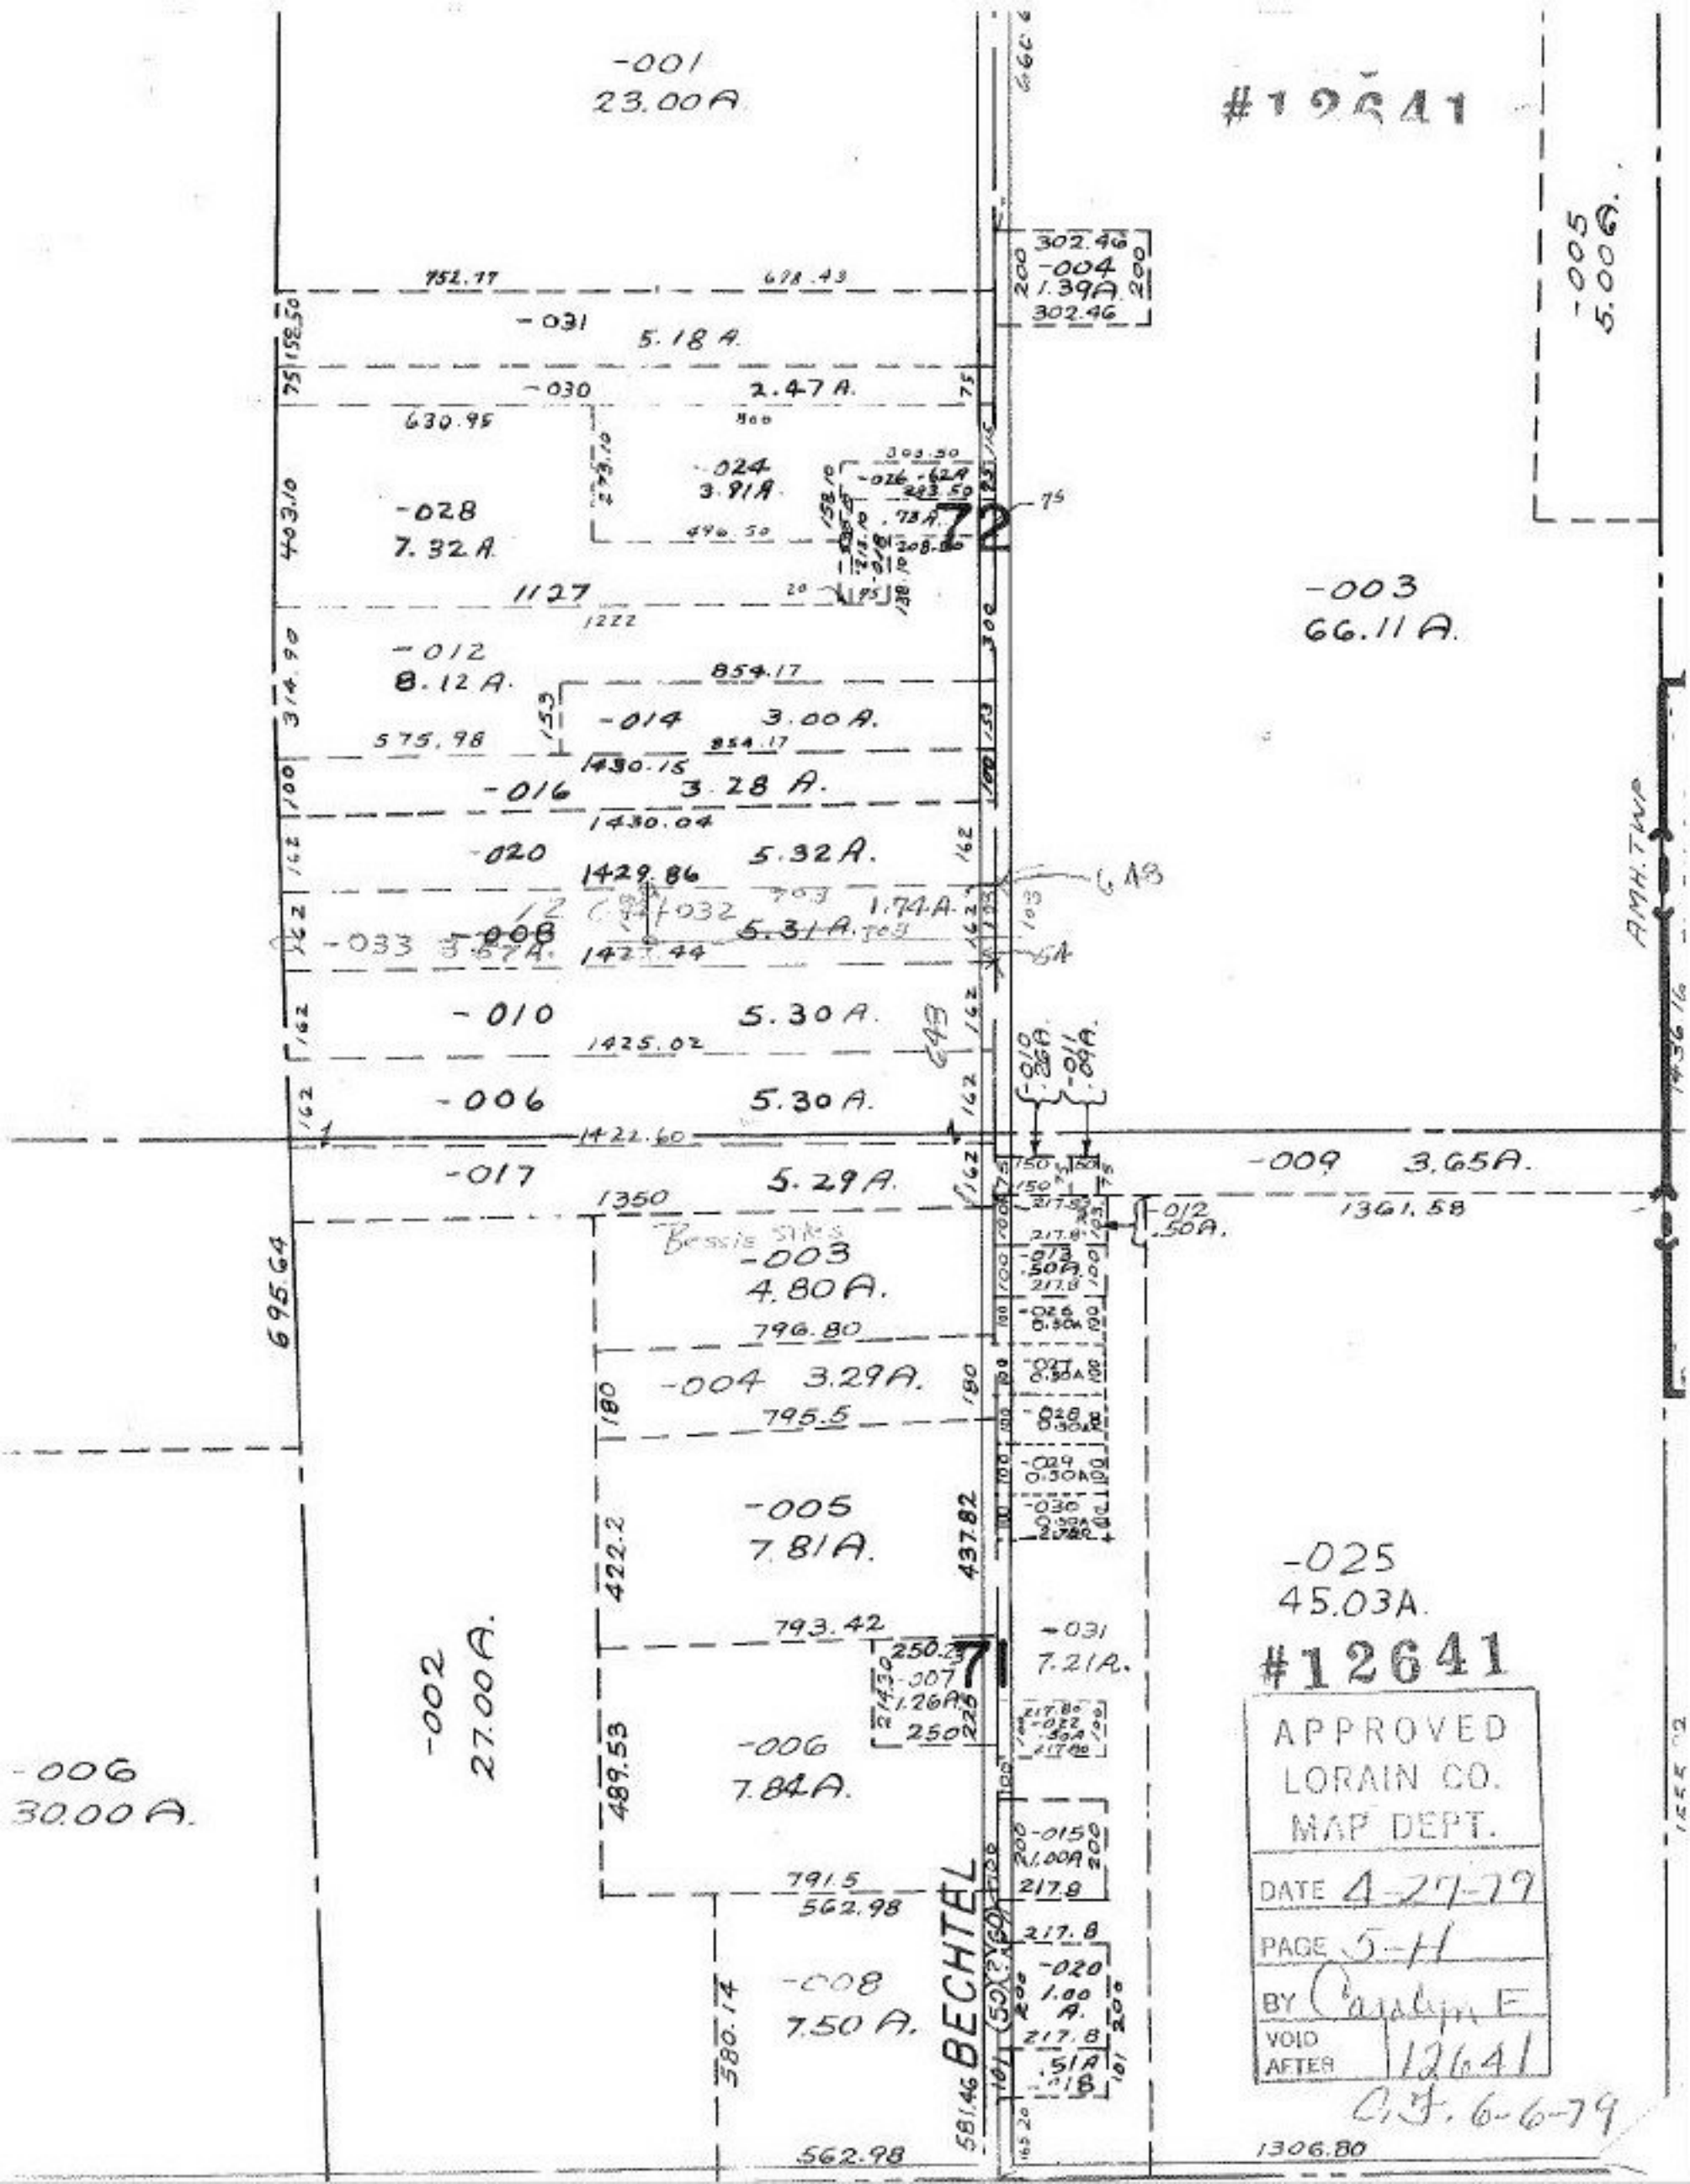

APPROVED
LORAIN CO.
MAP DEPT.
DATE 4-27-79
PAGE 5-H
BY Carolyn F
VOID AFTER 12641
C.F. 6-6-79