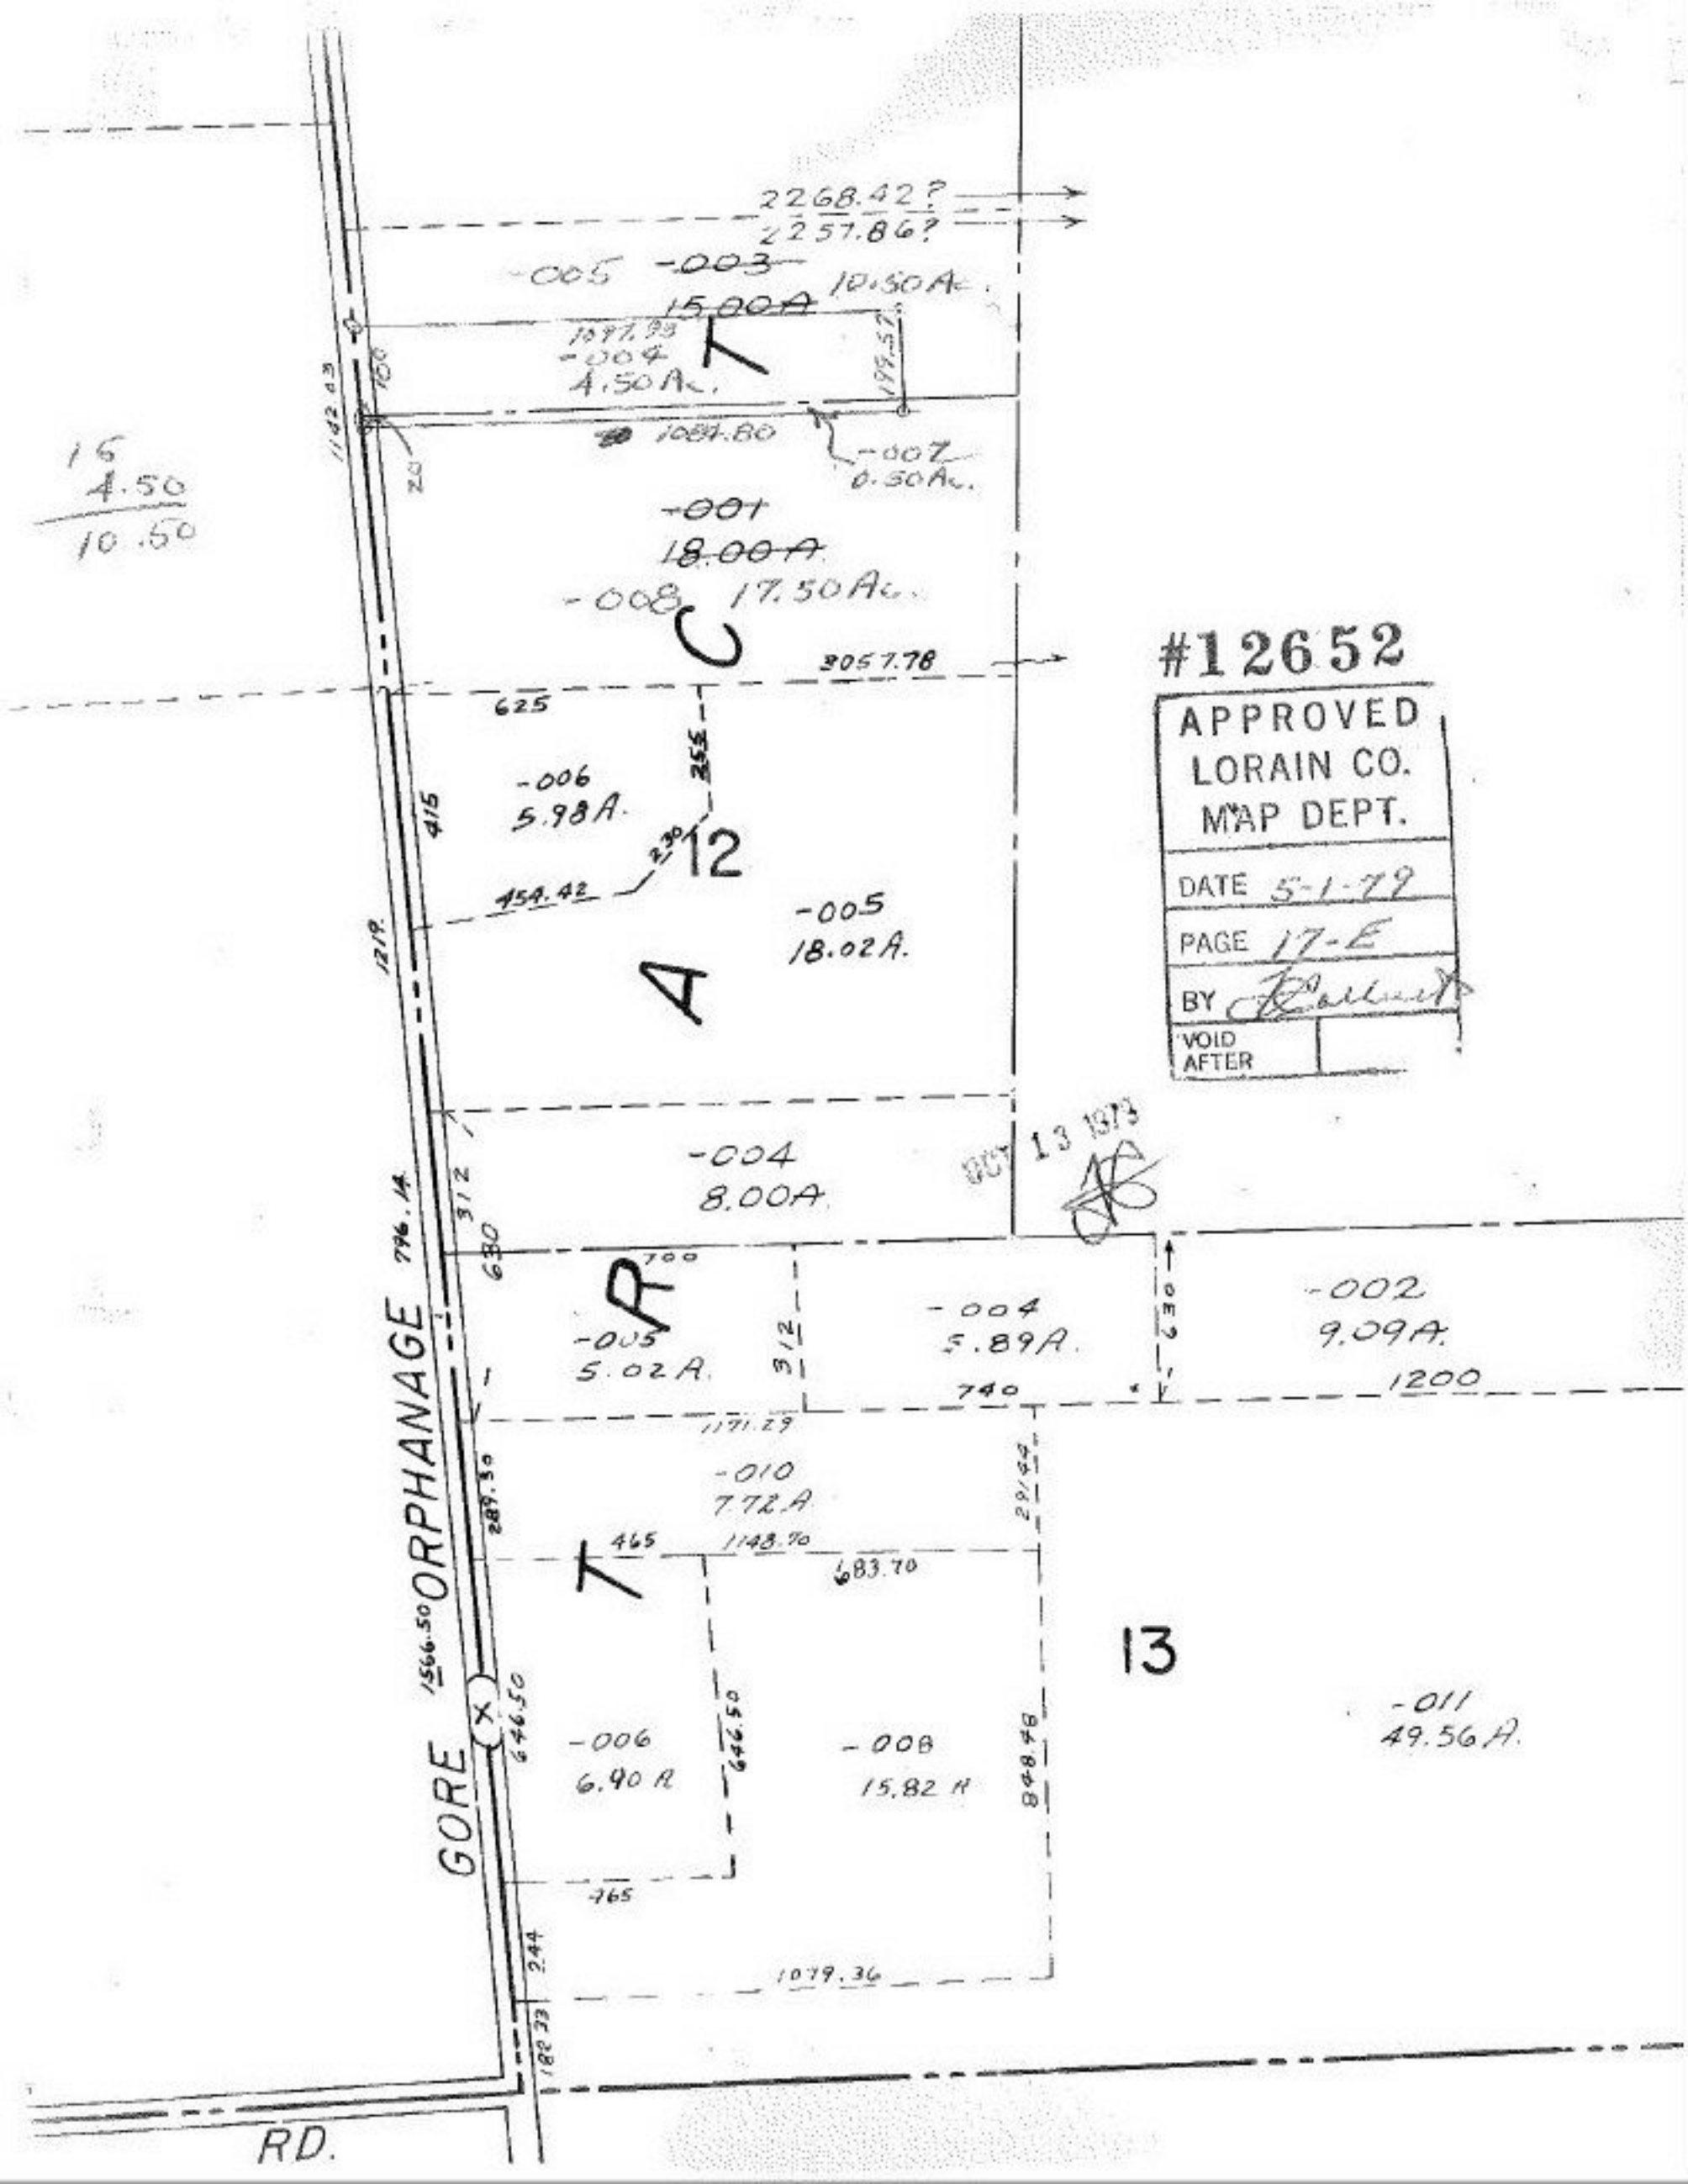

#12652

APPROVED
LORAIN CO.
MAP DEPT.

DATE 5-1-79

PAGE 17-E

BY [signature]

VOID AFTER

OCT 13 1979