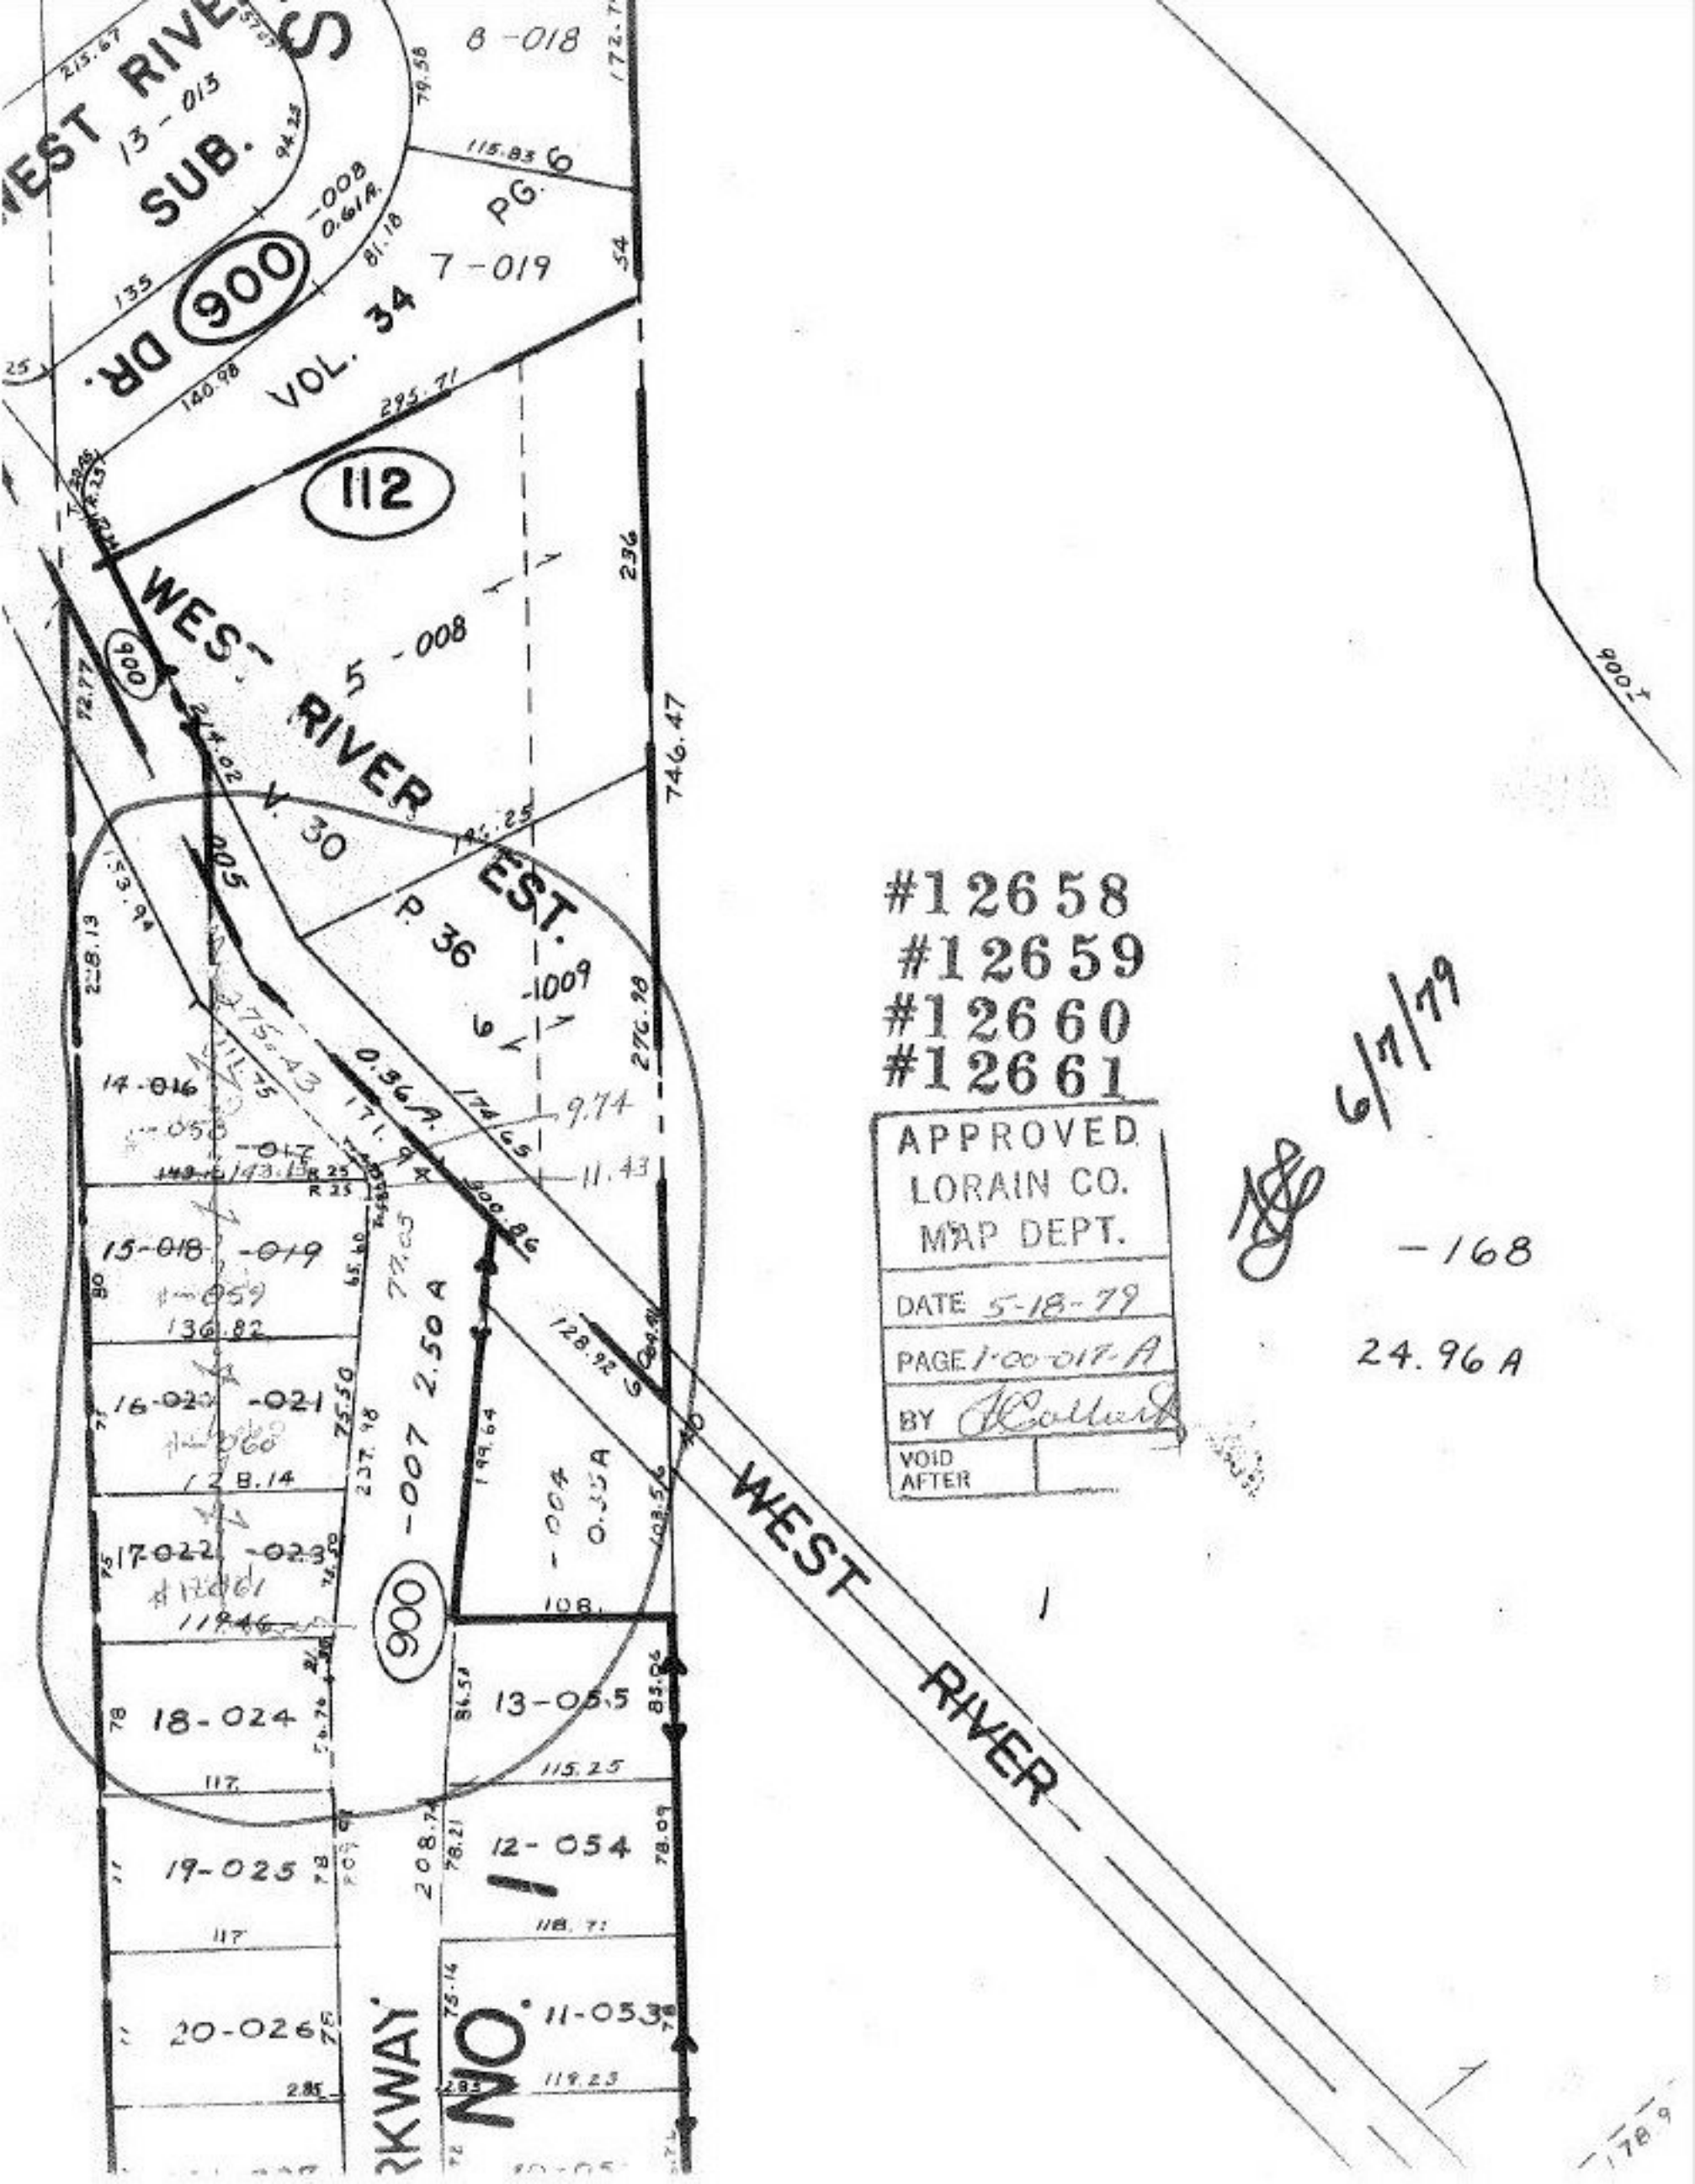

#12658
#12659
#12660
#12661

APPROVED
LORAIN CO.
MAP DEPT.
DATE 5-18-79
PAGE 1-00-017-A
BY [signature]
VOID AFTER

6/7/79

-168

24.96 A